

SEWAGE DISPOSAL SYSTEM

MARYLAND STATE DEPARTMENT OF HEALTH

HOWARD COUNTY

ELLICOTT CITY

DISTRICT 1

INDEXED

DATE 12/8/72

Drvs Calloway IS PERMITTED TO INSTALL X ALTER

ADDRESS 1304 Blackfriars Road, Baltimore, Md. PHONE 242-1600, Ext. 74

A SEWAGE DISPOSAL SYSTEM LOCATED AT _____

SUBDIVISION Exzies ROAD 1534 Exzies Rd. LOT 6, Blk. A, Sec. 2

PROPERTY OWNER DAVID L. CALLOWAY *David L. Calloway*

ADDRESS _____

SPECIFICATIONS - 3 bedrooms

DRAIN FIELD _____ DEPTH _____ FEET. BOTTOM AREA _____ SQ. FT.

SEEPAGE PITS _____ ABSORBENT SIDE-WALL AREA _____ SQ. FT.

SEPTIC TANK CAPACITY 1,000 GALLONS

FOR GARBAGE GRINDER, INCREASE DISPOSAL AREA 25% & TANK CAPACITY 50%.


OTHER Dry well - 100 sq. ft. area below inlet and locate as shown on page sheet.

PLANS APPROVED BY D. W. Mcneehan DATE 12/7/72

FILL SEPTIC TANK AND DISTRIBUTION BOX WITH WATER BEFORE CALLING FOR AN INSPECTION. COVER NO WORK UNTIL INSPECTED AND APPROVED.

NEITHER THE HOWARD COUNTY COMMISSIONERS NOR THE HEALTH DEPARTMENT IS RESPONSIBLE FOR THE SUCCESSFUL OPERATION OF ANY SYSTEM.

BLDG. PERMIT SIGNED
AND RETURNED *4/1/73*
Serial # 64113 - Prod.

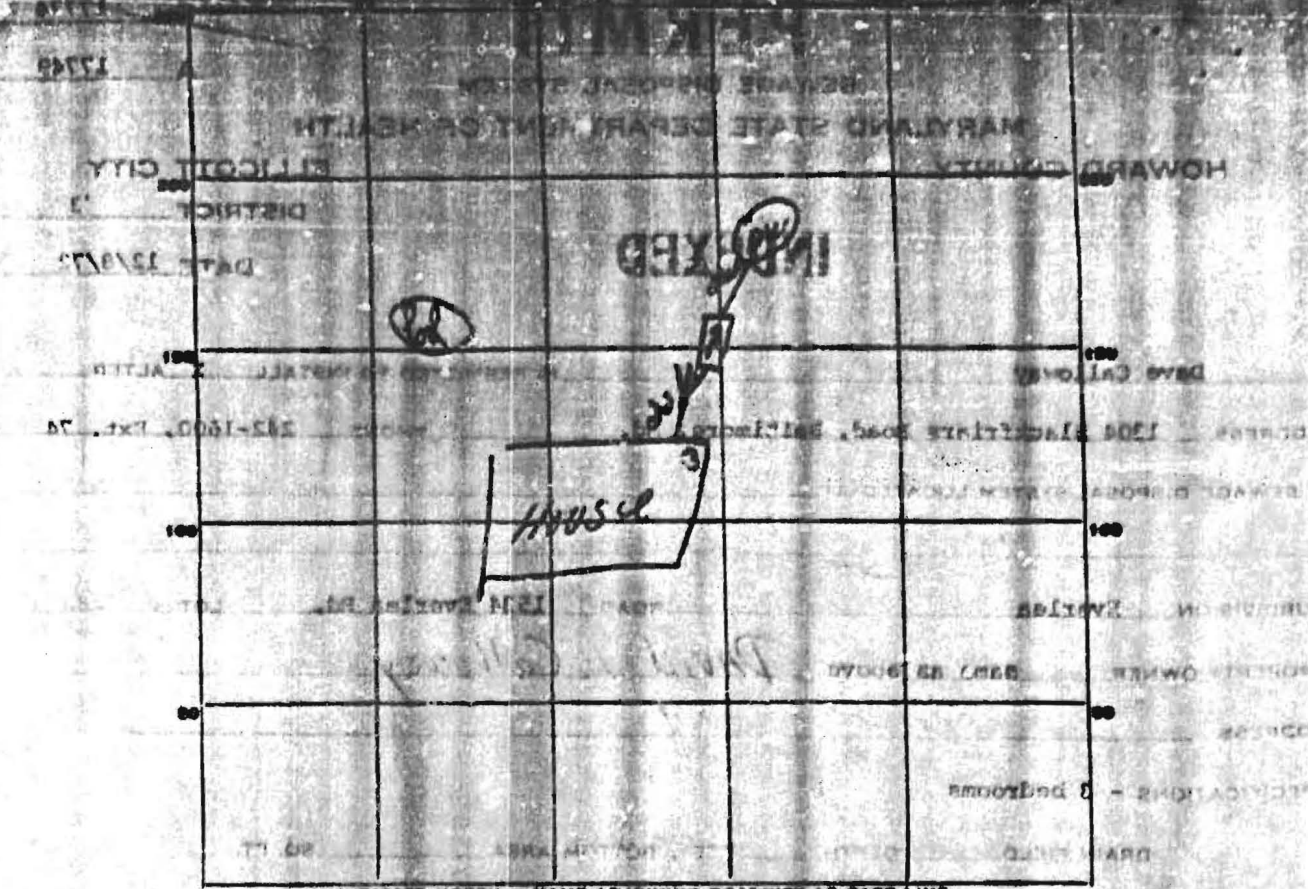

INDICATES NORTH - NAME ADJOINING ROADWAY AS GAGE LINE.

Curled Rd

PERMIT CARD 1K

SEPTIC TANK, LEVEL 2K CLEANOUTS _____

DISTRIBUTION BOX, LEVEL _____

TILE FIELD, DEPTH _____ FT. TRENCH WIDTH _____ FT.

GRAVEL DEPTH _____ IN. TOTAL LENGTH _____ FT.

NUMBER OF TRENCHES _____ TOTAL BOTTOM AREA _____

SEEPAGE PITS, INSIDE DIAMETER 12 FT. DEPTH BELOW INLET 9 FT.

ABSORBENT AREA 3.38 SQ. FT.

REMARKS _____

DATE SYSTEM APPROVED 10/15/52 INSPECTOR W. M. M...