


I certify the measurements and elevations are actual + correct for this property.

Signed: Norman E. Mason Jr.

FINISH Floor Elev.	0'
INU. Elev.	- 2'
TANK INU. Elev.	- 2 1/2'
EXIST. Elev.	- 1'
	- 6'
Dry well INU.	- 5 1/2 0 1/2' Below org. grade
EXIST. Elev.	- 1 1/2'
ELEV AT PT	→

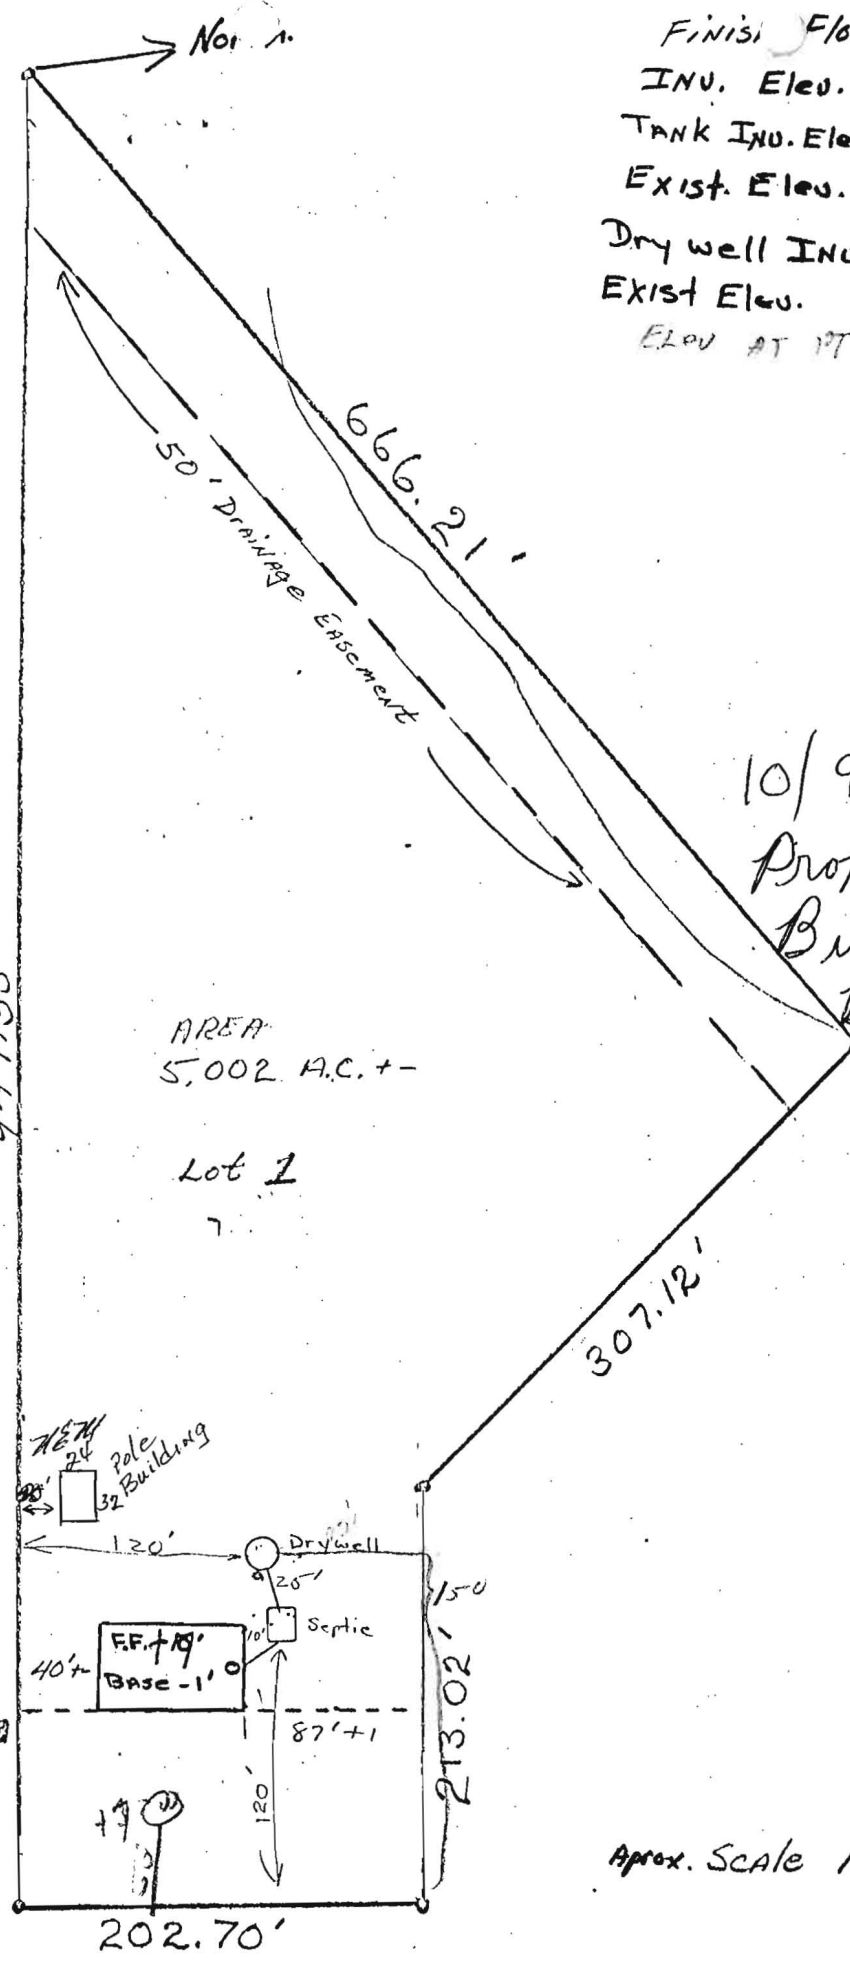

Min. Set Back 100'


Approx. Scale 1" = 100'

PARCEL 34

TAX MAP 20 GRID 6
64462 Dist 4

WILLIAM G. RASC
REG. NO. 4575

EDWIN WARFIELD III
W.H.H. 461/689

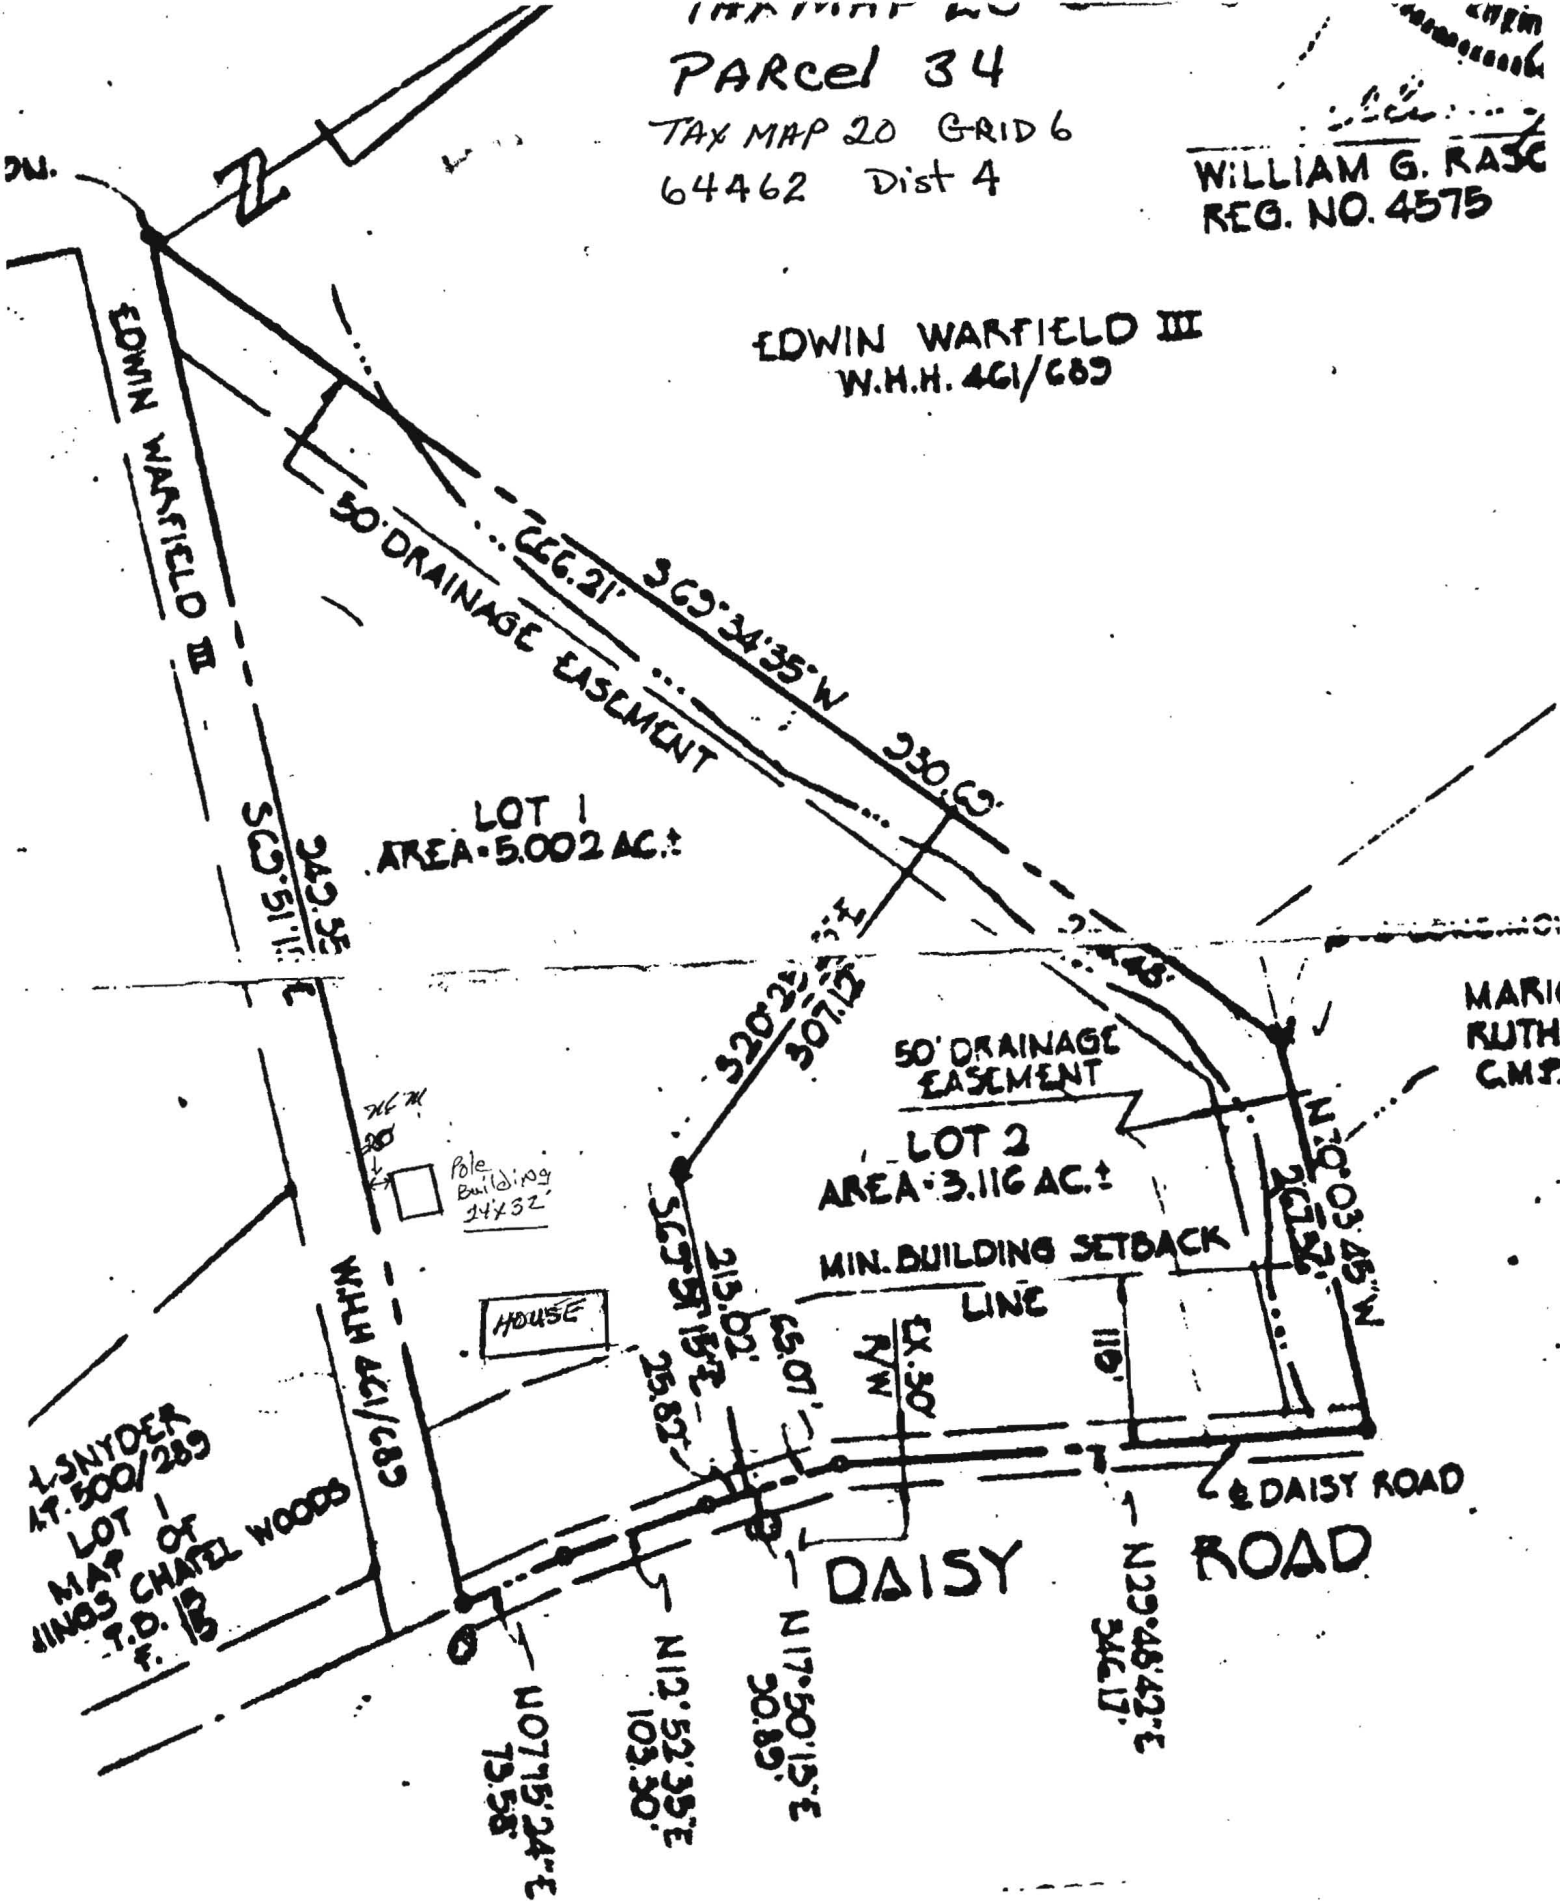

LOT 1
AREA 5.002 AC.±

LOT 2
AREA 3.116 AC.±

MIN. BUILDING SETBACK
LINE

50' DRAINAGE
EASEMENT

DAISY

DAISY ROAD

L. SNYDER
AT. 500/289
LOT 1
MAP OF
KINGS CHAPEL WOODS
F. 13

MARI
RUTH
C.M.P.

1" = 132'