

C-781 P. 706 4.13' below
12/19/74

APPLICATION

A 21959

SEWAGE DISPOSAL TESTING

P _____

STATE OF MARYLAND - DEPARTMENT OF HEALTH AND MENTAL HYGIENE

HOWARD COUNTY HEALTH DEPARTMENT
ENVIRONMENTAL HEALTH SERVICES

DISTRICT 3

P. O. BOX 470, ELLICOTT CITY, MARYLAND 21043
TELEPHONE: 655-5900, EXT. 330

S.F. 3 - 1000
4 - 1500

DATE 8/19/75

1639 ft prop line, measured along the 663 ft prop line, and 1639 ft in from the 663 ft prop line. The line will enter the D.W. @ 4' below O.C., and the new vent depth will not exceed 4'. The 2nd D.W. will be constructed in the same manner as the first, having placed approx. 30 ft from the first, edge-to-edge, and at approximately the same elevation. There will be no less than 150 ft of clearcut sidewalk near ga bedroom in this these dry wells.

TO: THE COUNTY HEALTH OFFICER
ELLICOTT CITY, MARYLAND

ST needs manhole to be cleaned & grade built
eg: 302 wh/area: 4500
482 wh/area: 6000
Rev. 4/24/78

I, HEREBY, APPLY FOR THE NECESSARY TEST IN ORDER TO CONSTRUCT (OR RECONSTRUCT) A SEWAGE DISPOSAL SYSTEM.

PROPERTY OWNER Don & Marlene Wyczalek

ADDRESS (Mrs. Lillian Podell) 4615 Old Court Rd. Ellicott City, Md. PHONE 655-3482

PROPERTY LOCATION: 8506 Charlton Road Randallstown, Md. 21133 (work- 730-5770, Ext. 526)

SUBDIVISION _____ LOT NO. 24

ROAD AND DESCRIPTION River Road & E. 12

SIZE OF LOT 5.071 acres TYPE BLDG. 1 of 4

IF NOT SINGLE RESIDENCE DESCRIBE _____
NUMBER OF BEDROOMS (Single Fam. Dwell.)

THE SYSTEM INSTALLED UNDER THIS APPLICATION IS ACCEPTABLE ONLY UNTIL PUBLIC FACILITIES BECOME AVAILABLE.

SIGNATURE OF APPLICANT Mrs. Lillian Podell BLDG. PERMIT SIGNED AND RETURNED 7/20/78


APPROVED BY R. Mansfield FOR D.W. (sewer) DATE 10/26/76
(KIND OF SYSTEM)

REJECTED BY _____ FOR _____ DATE _____
(KIND OF SYSTEM)

HOLD PENDING FURTHER TESTS _____ DATE _____

REASONS FOR REJECTION OR HOLDING _____

THIS IS NOT A PERMIT

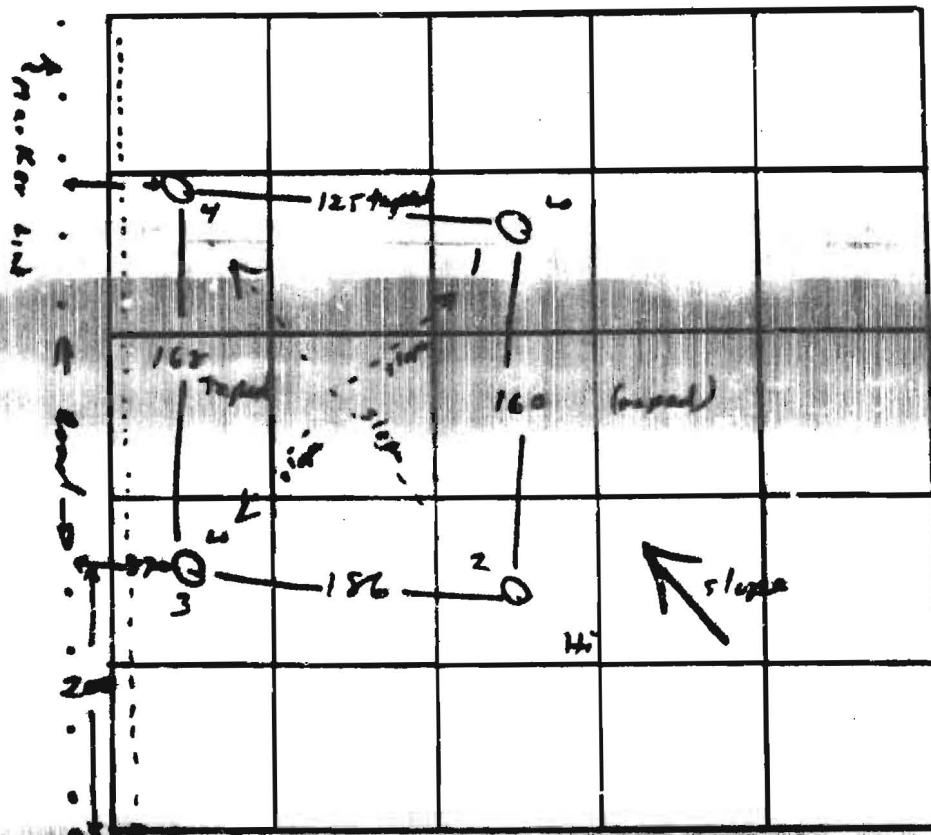

St 24

125'

clay/loam
sandy loam
to
ood

12

3

(same clay)
sandy loam
loam
brown
(low clay)
(mixed)

12

11-7

DATE	TEST NO.	DEPTH	PRELIMINARY		TEST - 1" DROP		TIME
			START	STOP	START	STOP	
9/9/55	1	3	12 ¹⁰	12 ¹¹	12 ¹⁴	12 ¹³	2
	1A	12	12 ¹⁰	12 ¹²	12 ¹²	12 ¹²	6
	2	4	12 ⁰⁸	12 ⁰⁹	12 ⁰⁸	12 ¹³	3
	2A	12	12 ⁰⁸	12 ¹³	12 ¹³	12 ¹⁶	4
	3	4	12 ⁰⁷	12 ²¹	12 ²¹	12 ³²	11
	3A	12	12 ⁰⁸	12 ²⁶	12 ²⁶	12 ²⁶	26
	4	12	vis		same		

REMARKS Lot #3 is under 0 bottom

TYPE OF SOIL _____

TESTED BY RJM ALSO PRESENT P Leadrin

PROPERTY
6669

20' BUILDING RESTRICTION LINE

off
1-20-78
dy

LOT 26
5.071 Ac.

420

422

424

426

428

20' BUILDING RESTRICTION LINE

618.14

S 60° 44' 50" E

427

429

20' BUILDING RESTRICTION LINE

20' BUILDING RESTRICTION LINE

