

6052 SEQUENCE NO. (OEP USE ONLY) STATE OF MARYLAND WELL COMPLETION REPORT THIS REPORT MUST BE SUBMITTED WITHIN 45 DAYS AFTER WELL IS COMPLETED.

COUNTY NUMBER A-20182 PERMIT NO. H-0-181-2250

DATE WELL COMPLETED 07-15-87 Depth of Well 42.5 (TO NEAREST FOOT) 12-7-87

OWNER MURPHY WANDA ADDRESS 11329 OLD HOPKINS ROAD TOWN FULTON DIVISION FLAMEWOOD SECTION 1 LOT 7

WELL LOG

Not required for drive wells

STATE THE KIND OF FORMATIONS PENETRATED, THEIR COLOR, DEPTH, THICKNESS AND IF WATER BEARING

DESCRIPTION (Use sectional sheets if needed)	FEET		Check if water bearing
	FROM	TO	
SP soil	0	2	
lay	2	4	
haley	4	12	
and stone	12	50	
thin mica	50	75	
thick mica	75	165	
lint	165	166	✓
mica	166	400	

9-15-87 CW

GROUTING RECORD

WELL HAS BEEN GROUTED (Circle appropriate Box)  Y  N

TYPE OF GROUTING MATERIAL CEMENT  M BENTONITE CLAY  BC

NO. OF BAGS 15 NO. OF POUNDS 1500

GALLONS OF WATER 75

DEPTH OF GROUT SEAL (to nearest foot) from 0 ft. to 33 ft.

CASING RECORD

MAIN CASING TYPE ST Nominal diameter 13 1/2 Total depth of main casing 68

OTHER CASING (if used) diameter inch depth (feet) from to

SCREEN RECORD

screen type or open hole ST BR HO PL OT

STEEL BRASS OPEN HOLE PLASTIC OTHER

GRAVEL PACK

IF WELL DRILLED WAS FLOWING WELL INSERT F IN BOX

TELESCOPE CASING  LOG INDICATOR  OTHER DATA

PUMPING TEST

HOUS PUMPED (nearest hour) 3

PUMPING RATE (gal. per min. to nearest gal.) 2

METHOD USED TO MEASURE PUMPING RATE float

WATER LEVEL (distance from land surface) BEFORE PUMPING 165 WHEN PUMPING 400

TYPE OF PUMP USED (circle appropriate box)  A air  P piston  T turbine  C centrifugal  R rotary  O other (describe below)  J jet  S submersible

PUMP INSTALLED

DRILLER WILL INSTALL PUMP YES  NO

IF DRILLER INSTALLS PUMP, THIS SECTION MUST BE COMPLETED FOR ALL WELLS EXCEPT HOME USE


TYPE OF PUMP INSTALLED PLACE (A, C, J, P, R, S, T, O) IN BOX - SEE ABOVE

CAPACITY GALLONS PER MINUTE (to nearest gallon) 2

PUMP HORSE POWER 1

PUMP COLUMN LENGTH (nearest ft.) 2

CASING HEIGHT (circle appropriate box and enter casing height)  + above  - below LAND SURFACE 2 (nearest foot)

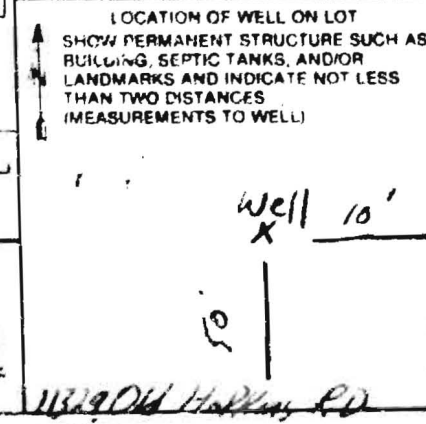

CIRCLE APPROPRIATE LETTER IF A WELL WAS ABANDONED AND SEALED WHEN THIS WELL WAS COMPLETED

ELECTRIC LOG OBTAINED

TEST WELL CONVERTED TO PRODUCTION WELL

PERMIT IDENT NO. 4

DRILLER'S SIGNATURE [Signature]

DRILLER'S SIGNATURE MATCH SIGNATURE ON APPLICATION

SUPERVISOR (signature of driller's journeyman responsible for sitework if different from permittee)