

WELL COMPLETION REPORT

DATE OF REPORT: 1/23/57
 DEPTH OF WELL: 410 FT (TO NEAREST FOOT)
 DRILLER IDENTIFICATION NO.: 137

OWNER: [Name]
 STREET OR RIVE: [Name]
 POST OFFICE: [Name]

WELL LOG

STATE THE KIND OF FORMATION PENETRATED, THICKNESS, DEPTH, THICKNESS AND IF WATER BEARING

DESCRIPTION	FEET	THICKNESS
[Faded text]	0 - 10	10
[Faded text]	10 - 20	10
[Faded text]	20 - 30	10
[Faded text]	30 - 40	10
[Faded text]	40 - 410	370

GRouting RECORD

WELL HAS BEEN GROUTED (CIRCLE APPROPRIATE BOX)

TYPE OF GROUTING MATERIAL (CIRCLE ONE): G M (CEMENT), B C (BENTONITE CLAY)

NO. OF BAGS: 18, NO. OF POUNDS: 1692

DEPTH OF GROUT SEAL (TO NEAREST FOOT): FROM 0 FT. TO 40 FT.

CASING RECORD

MAJOR CASING TYPE: S T (STEEL TUBING), P L (PLASTIC), O T (OTHER)

DIAMETER (INCH): 6, 6.1

DEPTH (FEET): 60, 61

OTHER CASING (IF USED)

DIAMETER (INCH): [] []

DEPTH (FEET): [] []

SCREEN RECORD

SCREEN TYPE: S T (STEEL), P L (PLASTIC), O T (OTHER)

DIAMETER (INCH): [] []

DEPTH (FEET): [] []

WELL LOG

DEPTH (NEAREST WHOLE FOOT) FROM 0 TO 400

DIAMETER OF SCREEN: 6 INCH (NEAREST INCH)

GRAVEL PACK: [] []

IF WELL DRILLED WAS A FLOWING WELL (CIRCLE ONE): F, N

PUMPING TEST

WATER PUMPED TO NEAREST HOUR: [] []

PUMPING RATE: [] []

WATER LEVEL (DISTANCE FROM LAND SURFACE): [] []

TYPE OF PUMPER USED (CIRCLE APPROPRIATE ONE): A (AIR), P (Piston), T (TUBING), C (CENTRIFUGAL), R (ROTARY), O (OTHER), J (JET), S (SUBMERSIBLE)

PUMP INSTALLED

TYPE OF PUMP (WRITE APPROPRIATE LETTER IN BOX): [] [] [] [] [] [] [] [] [] []


DRILLER WILL INSTALL PUMP (CIRCLE APPROPRIATE BOX): Y, N

WELL CAPACITY: [] []

PUMP HORSE POWER: [] []

PUMP COLUMN LENGTH (NEAREST FOOT): [] []

CASING HEIGHT (CIRCLE APPROPRIATE ONE): ABOVE, BELOW

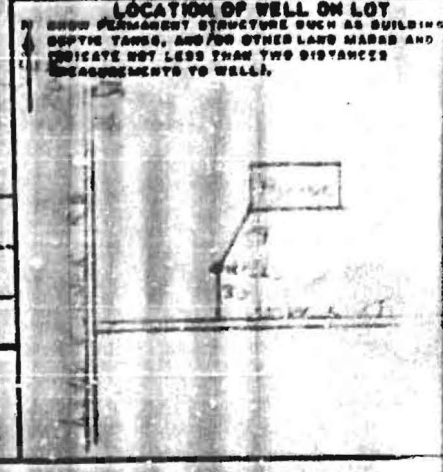

CIRCLE APPROPRIATE BOXES

A WELL WAS ABANDONED AND SEALED WHEN THIS WELL WAS COMPLETED

E ELECTRIC LOG OBTAINED

P VERY WELL CONVERTED TO PRODUCTION WELL

I HEREBY CERTIFY THAT I HAVE COMPLIED WITH ALL CONDITIONS STATED ON THE ABOVE MENTIONED "PERMIT TO DRILL WELL" AND THAT INFORMATION CONTAINED IN THIS REPORT IS TRUE, ACCURATE, AND COMPLETE TO THE BEST OF MY KNOWLEDGE, INFORMATION AND BELIEF.

DRILLER'S NAME: [Name]

DATE: 1/23/57

SIGNATURE: Robert C. [Name]