

517962-E

PERMIT

SEWAGE DISPOSAL SYSTEM

MARYLAND STATE DEPARTMENT OF HEALTH

HOWARD COUNTY

ELLCOTT CITY

INDEXED

DISTRICT 4th

DATE 6/26/76

Howard Pickett IS PERMITTED TO INSTALL E ALTER

ADDRESS Watersville Road, Mt. Airy, Maryland 21771 PHONE 828-0543

SEWAGE DISPOSAL SYSTEM LOCATED AT _____

SUBDIVISION CR Naples Property ROAD 18552 New Cut Road LOT 15

PROPERTY OWNER Walter Brochert PHONE: 277-8933

ADDRESS _____

SPECIFICATIONS 3 bedrooms

DRAIN FIELD _____ DEPTH _____ FEET, BOTTOM AREA _____ SQ. FT.

SEEPAGE MTS _____ ABSORBENT SIDE-WALL AREA _____ SQ. FT.

SEPTIC TANK CAPACITY 1000 GALLONS

FOR GARBAGE GRINDER, INCREASE DISPOSAL AREA 25% & TANK CAPACITY 50%.

OTHER DRY WELL - To have 120 sq. ft. absorbent sidewall area per bedroom. Just no deeper than 3 1/2 ft. and maximum depth permitted for dry well is 10 1/2 ft. Locate dry well 150 ft. from left property line and 140 ft. from center of the road as seen when facing the lot from the road.

NOTE! ALL PIPE FROM HOUSE TO DISPOSAL AREA MUST BE CAST IRON, PERMIT VOID AFTER THREE YEARS.

NOTE! INSTALL STAND PIPE ON SEPTIC TANK AND DRY WELL. STAND PIPES MUST BE 6 INCHES IN DIAMETER. CAST IRON, CONCRETE OR TERRA COTTA ACCEPTED.


PLANS APPROVED BY Charles B. Streater DATE 6/3/73

FILL SEPTIC TANK AND DISTRIBUTION BOX WITH WATER BEFORE CALLING FOR AN INSPECTION. COVER NO WORK UNTIL INSPECTED AND APPROVED.

NEITHER THE HOWARD COUNTY COMMISSIONERS NOR THE HEALTH DEPARTMENT IS RESPONSIBLE FOR THE SUCCESSFUL OPERATION OF ANY SYSTEM.

18889

DATE SYSTEM APPROVED _____

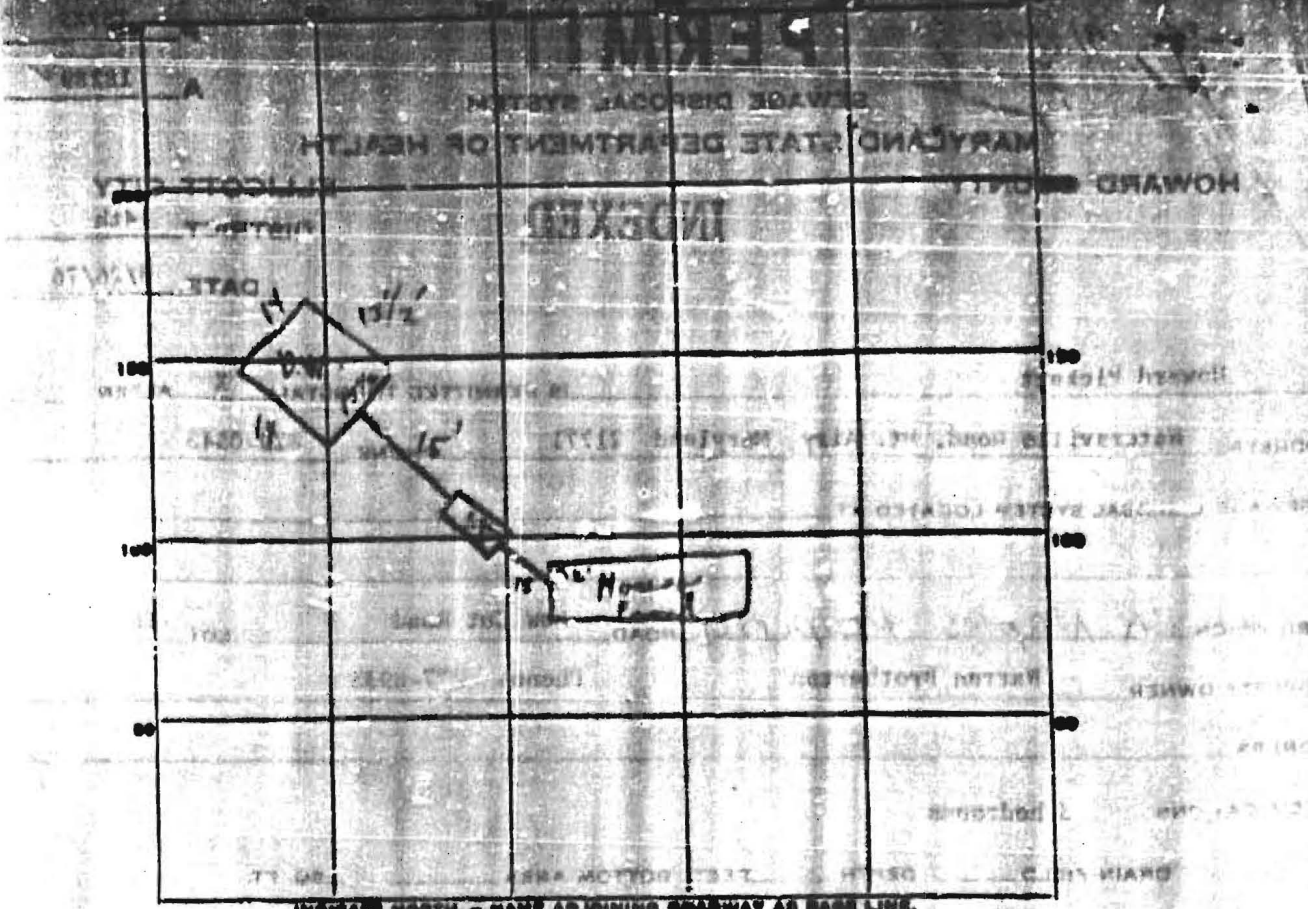

PERMIT CARD Yes

SEPTIC TANK, LEVEL ok CLEANUP, ok S.T. ok D.W. ok

DISTRIBUTION BOX, LEVEL _____

TILE FIELD, DEPTH _____ FT. TRENCH WIDTH _____ FT.

GRAVEL DEPTH _____ IN. TOTAL LENGTH _____ FT.


NUMBER OF TRENCHES _____ TOTAL BOTTOM AREA _____

SEEPAGE PITS, INSIDE DIAMETER outside pits 55 FT. DEPTH BELOW INLET 75-80 FT.

ABSORBENT AREA 440 SQ. FT.

REMARKS 7/3/76 55 x 80 = 440 ok

DATE SYSTEM APPROVED 9/3/76 INSPECTOR C. B. Stankus

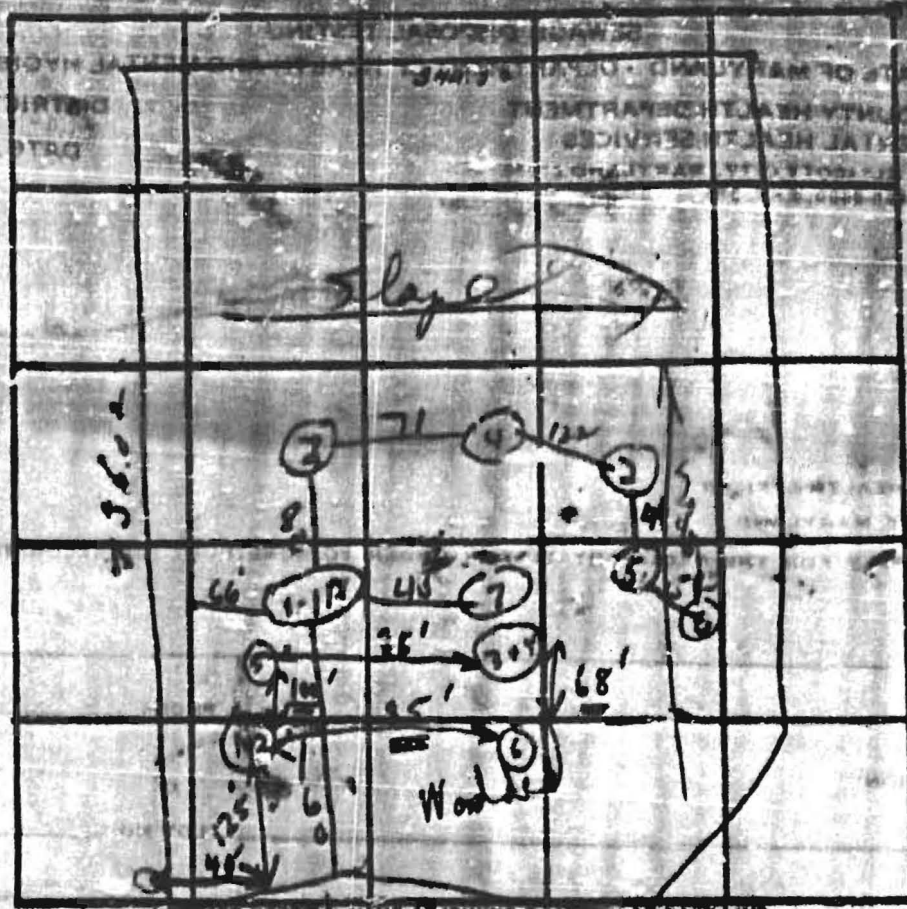

| DATE | TEST NO. | DEPTH | LOG-OUT START | STOP | TEST - 1" DROP START | STOP | TIME |
|--------|----------|---------|------------------|-----------------|-------------------------|------|------|
| 4/1/02 | 1 | 4' | 10:45 | arrived | | | |
| | 1A | 10 1/2' | 1:10 | slippery - road | | | |
| | 3 | 8' | rock collar | go deeper | | | |
| | 4 | 9' | water | | | | |
| | 2 | 9' | rock | | | | |
| | 5 | 3' | rock | | | | |
| | 6 | 3' | rock | | | | |
| | 7 | 3' | rock | | | | |
| 4/5/02 | 1 | 4' | 2:56 | 2:59 | 2:59 | 3:06 | 9m |
| | 2 | 10 1/2' | 2:55 | 2:57 | 2:59 | 3:09 | 10m |
| | 3 | 4' | 2:59 | 3:01 | 3:01 | 3:04 | 7m |
| | 4 | 11' | 2:00 | 2:02 | 2:02 | 2:06 | 7m |
| | 5 | 10' | shallow | 3:14 | | | |

Shale
think
dick?

REMARKS
 → Toted closer to road see above table.