

# PERMIT

SEWAGE DISPOSAL SYSTEM

MARYLAND STATE DEPARTMENT OF HEALTH

HOWARD COUNTY

*app 8-18-67*  
*DLW-2*

P 12987

A \_\_\_\_\_

INDEXED

ELLICOTT CITY

DISTRICT 4

DATE 8/16/67

*9/16/67*  
*Permit on back for post*  
*9am*

James Triplett IS PERMITTED TO INSTALL \_\_\_\_\_ ALTER X

ADDRESS Hardy Rd., Mt. Airy, Md. PHONE XU 9-4555

A SEWAGE DISPOSAL SYSTEM LOCATED AT \_\_\_\_\_

SUBDIVISION \_\_\_\_\_ ROAD 16822? Rt. 144 - 4th house LOT \_\_\_\_\_

PROPERTY OWNER J. M. Spaulding past Stansbury Store on same side

ADDRESS \_\_\_\_\_

### SPECIFICATIONS

DRAIN FIELD \_\_\_\_\_ DEPTH \_\_\_\_\_ FEET, BOTTOM AREA \_\_\_\_\_ SQ. FT.

SEEPAGE PITS \_\_\_\_\_ ABSORBENT SIDE-WALL AREA \_\_\_\_\_ SQ. FT.

SEPTIC TANK CAPACITY \_\_\_\_\_ GALLONS

FOR GARBAGE GRINDER, INCREASE DISPOSAL AREA 22% & TANK CAPACITY 50%.

OTHER DEY WELL - 300 sq. ft. min.

PLANS APPROVED BY \_\_\_\_\_ DATE 8/16/67

FILL SEPTIC TANK AND DISTRIBUTION BOX WITH WATER BEFORE CALLING FOR AN INSPECTION. COVER NO WORK UNTIL INSPECTED AND APPROVED.

NEITHER THE HOWARD COUNTY COMMISSIONERS NOR THE HEALTH DEPARTMENT IS RESPONSIBLE FOR THE SUCCESSFUL OPERATION OF ANY SYSTEM.


**NOTIFY THE HEALTH DEPARTMENT 48 HOURS BEFORE EXCAVATIONS ARE TO BE BACK FILLED.**

P 12987

*A 517962-B*



6.75  
 53.75  
 2700  
 3037.5

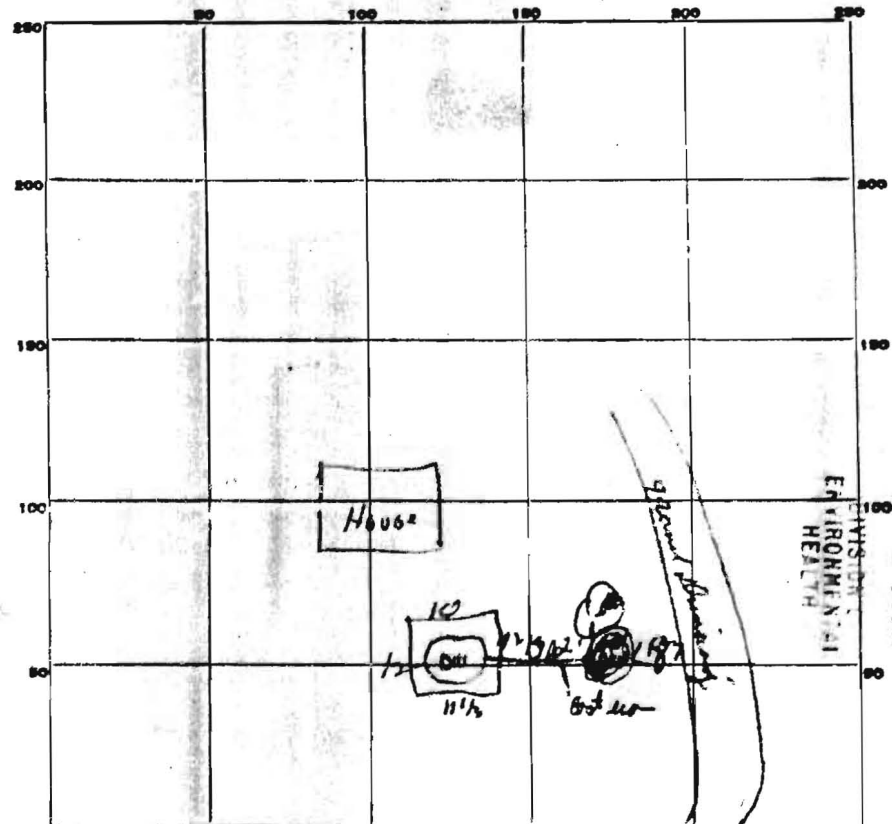

INDICATE NORTH. - NAME ADJOINING ROADWAY AS BASE LINE.  
 RT. 144 - Poplar Springs

RECEIVED  
 HOWARD COUNTY  
 HEALTH DEPT  
 AUG 17 3 43 PM '66  
 ENVIRONMENTAL  
 HEALTH

PERMIT CARD 012

SEPTIC TANK, LEVEL \_\_\_\_\_ CLEANOUTS \_\_\_\_\_

DISTRIBUTION BOX, LEVEL \_\_\_\_\_

TILE FIELD, DEPTH \_\_\_\_\_ FT. TRENCH WIDTH \_\_\_\_\_ FT.

GRAVEL DEPTH \_\_\_\_\_ IN. TOTAL LENGTH \_\_\_\_\_ FT.

NUMBER OF TRENCHES \_\_\_\_\_ TOTAL BOTTOM AREA \_\_\_\_\_

SEEPAGE PITS, INSIDE DIAMETER Painted 45 FT. DEPTH BELOW INLET 6 3/4 FT.

ABSORBENT AREA 3037 SQ. FT.

REMARKS \_\_\_\_\_

\_\_\_\_\_

\_\_\_\_\_

\_\_\_\_\_

\_\_\_\_\_

DATE SYSTEM APPROVED 8/10/67 INSPECTOR D.W. Monaghan