

10/16/02 - 9-10 Am

PUB. SEWER STATUS VERIFIED BY _____

ISSUE DATE: 10/16/2002

PERMIT

Fyock not doing this

Transferred to 850 Winchester P 517962 P517971

APPROVAL DATE: 10/24/02

A REPAIR

ON-SITE SEWAGE DISPOSAL SYSTEM HOWARD COUNTY HEALTH DEPARTMENT BUREAU OF ENVIRONMENTAL HEALTH

Mathelds

INDEXED 04-334728

~~Jack Fyock Septic Service~~

IS PERMITTED TO INSTALL ALTER

ADDRESS: ~~PO Box 89, Glenelg, MD 21737~~

PHONE NUMBER: ~~410 988 9270~~

SUBDIVISION: Gwenlee Estates

LOT NUMBER: 6

ADDRESS: 3259 Gwenlee Circle

PROPERTY OWNER: William Leffler

SEPTIC TANK CAPACITY (GALLONS): 1250

PUMP CHAMBER CAPACITY (GALLONS): N/A

NUMBER OF BEDROOMS: 4

SQUARE FEET PER BEDROOM: _____

LINEAR FEET OF TRENCH REQUIRED: _____

TRENCHES:	Trench to be _____ feet wide. Inlet _____ feet below original grade. Bottom maximum depth _____ feet below original grade. Effective area begins at _____ feet below original grade. _____ feet of stone below distribution pipe.
LOCATION:	
PURPOSE:	Relocate existing septic tank in support of future building permit. Call for inspection when ground is opened so sanitarian can recommend repair.

PLANS APPROVED: _____

DATE: _____

NOTE: PERMIT VOID AFTER 2 YEARS

NOTE: CONTRACTOR RESPONSIBLE FOR SCHEDULING A PRE-CONSTRUCTION INSPECTION FOR ALL INSTALLATIONS

NOTE: WATERTIGHT SEPTIC TANKS REQUIRED

NOTE: ALL PARTS OF SEPTIC SYSTEM SHALL BE 100 FEET FROM ANY WATER WELL

NOTE: MANHOLE RISERS REQUIRED ON ALL SEPTIC TANKS AND PUMP CHAMBERS


NEITHER THE HOWARD COUNTY COUNCIL NOR THE HEALTH DEPARTMENT IS RESPONSIBLE FOR THE SUCCESSFUL OPERATION OF ANY SYSTEM PERMITTEE RESPONSIBLE FOR OBTAINING FINAL APPROVAL ON THIS PERMIT

BUILDING PERMIT SIGNED CALL 410-313-2640 FOR INSPECTION OF SEPTIC SYSTEM


AND RETURNED 10-23-02

BOU 139608-DREK + Sun room

P517971

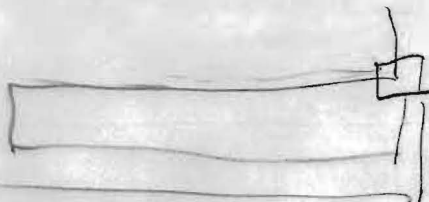

NOT TO SCALE

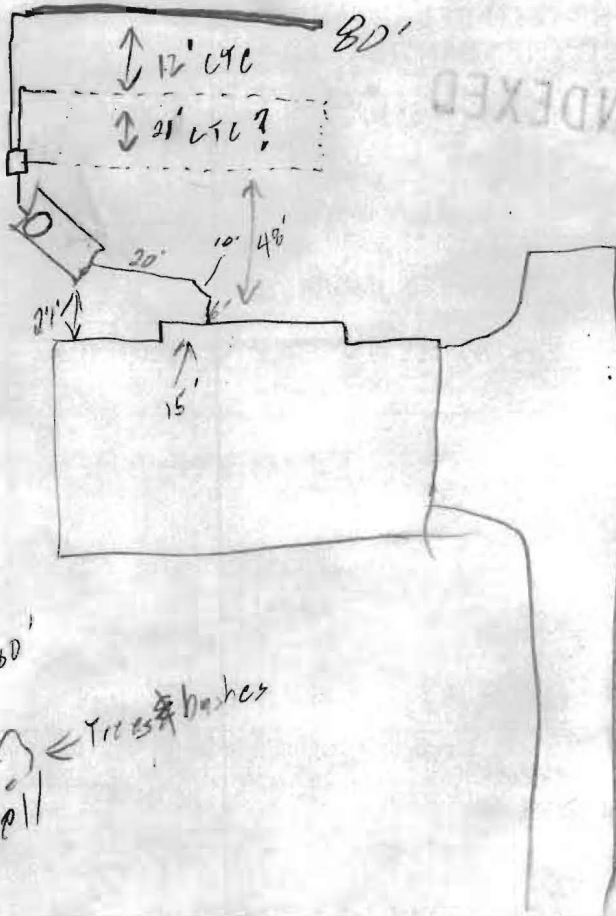

TRENCH/DRAINFIELD DATA		
WIDTH	INLET	BOTTOM
2'	5'	10'
NUMBER OF TRENCHES		1
TOTAL LENGTH		80'
ABSORPTION AREA		400 sq
DISTRIBUTION BOX LEVEL		<input checked="" type="checkbox"/>
DISTRIBUTION BOX BAFFLE		<input checked="" type="checkbox"/>
DISTRIBUTION BOX PORT		<input type="checkbox"/>

SEPTIC TANK DATA	
SEPTIC TANK 1 LEVEL	<input checked="" type="checkbox"/>
CAPACITY	1500 GAL
SEAM LOC	Top
TANK LID DEPTH	4'
BAFFLES	<input checked="" type="checkbox"/>
BAFFLE FILTER	<input type="checkbox"/>
MANHOLE LOC	Back
6" PORT LOC	<input type="checkbox"/>
WATERTIGHT TEST	<input type="checkbox"/>
SEPTIC TANK 2 LEVEL	<input type="checkbox"/>
CAPACITY	_____ GAL
SEAM LOC	_____
TANK LID DEPTH	_____
BAFFLES	N/A
BAFFLE FILTER	<input type="checkbox"/>
MANHOLE LOC	_____
6" PORT LOC	_____
WATERTIGHT TEST	_____

PRE-CONSTRUCTION 10/15/02 Adding an addition & need to move S.T. Discussed set backs & possibly adding an additional trench

INSTALLATION while contractor is here. Add trench would be 80' w/ 10' bottom & 5-6' stone. Current spec's would require (2) 84' trenches. Currently have 80' & 81' trenches with no sign of failure (50)

10/28/02 Tank set 10/28/02 DB set & trenches plumbed. 1st trench wet, 2nd trench dry. OK to cover work that is completed (50)

10/29/02 OK to cover all work (50)


BUILDING PERMIT SIGNED AND RETURNED

FINAL INSPECTOR

[Signature]

DATE OF APPROVAL

10/29/02

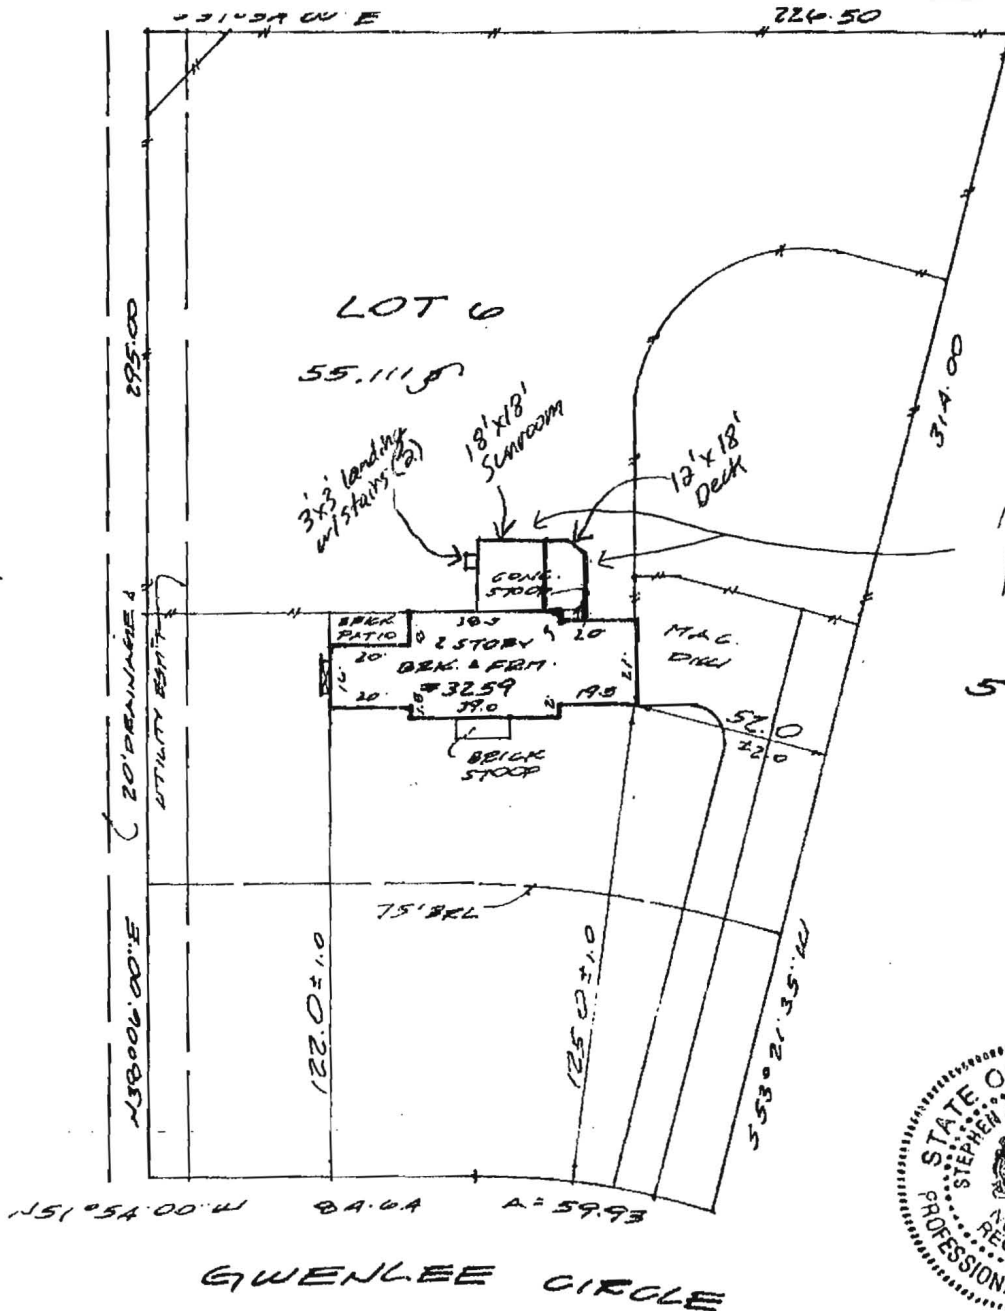

10/23/02-
Proposed additions
on **SRK**
5 ex ST will be
moved



GWENLEE CIRCLE

No evidence of property corners was found. Apparent occupation is shown.

1" = 50'

Date: 06-26-02 Scale: 1" = 50' Drn: B.D.
 Plat Book:
 Plat No.: 3324 NO TITLE REPORT FURNISHED
 Work Order: 02-3418
 Address: 3259 GWENLEE CIRCLE
 District: 4
 Jurisdiction: HOWARD COUNTY, MD

Surveyor's Certification

I hereby certify that the survey shown hereon is correct to the best of my knowledge and that, unless noted otherwise, it has been prepared utilizing a description of record. This survey is not a boundary survey and the location of existence of property corners is neither guaranteed nor implied. Fence lines, if shown, are approximate in location. This property does not lie within a 100 year flood plain according to FEMA insurance maps as interpreted by the originator unless otherwise shown hereon. Building restriction lines shown are as per available information and are subject to the interpretation of the originator.

Stephen J. Wentz

LOCATION DRAWING
LOT 6
BLOCK D
GWENLEE ESTATES
SECTION 2

NOTE: This plat is of benefit to a consumer only insofar as it is required by a lender or a title insurance company or its agent in connection with contemplated transfer, financing or refinancing. This plat is not to be relied upon for the establishment or location of fences, garages, buildings, or other existing or future improvements. This plat does not provide for the accurate identification of property boundary lines, but such identification may not be required for the transfer of title or securing financing or refinancing.



Meridian Surveys, Inc.
 811 Russell Avenue
 Suite #303
 Gaithersburg, MD 20879
 (301) 721-9400