


APPLICATION

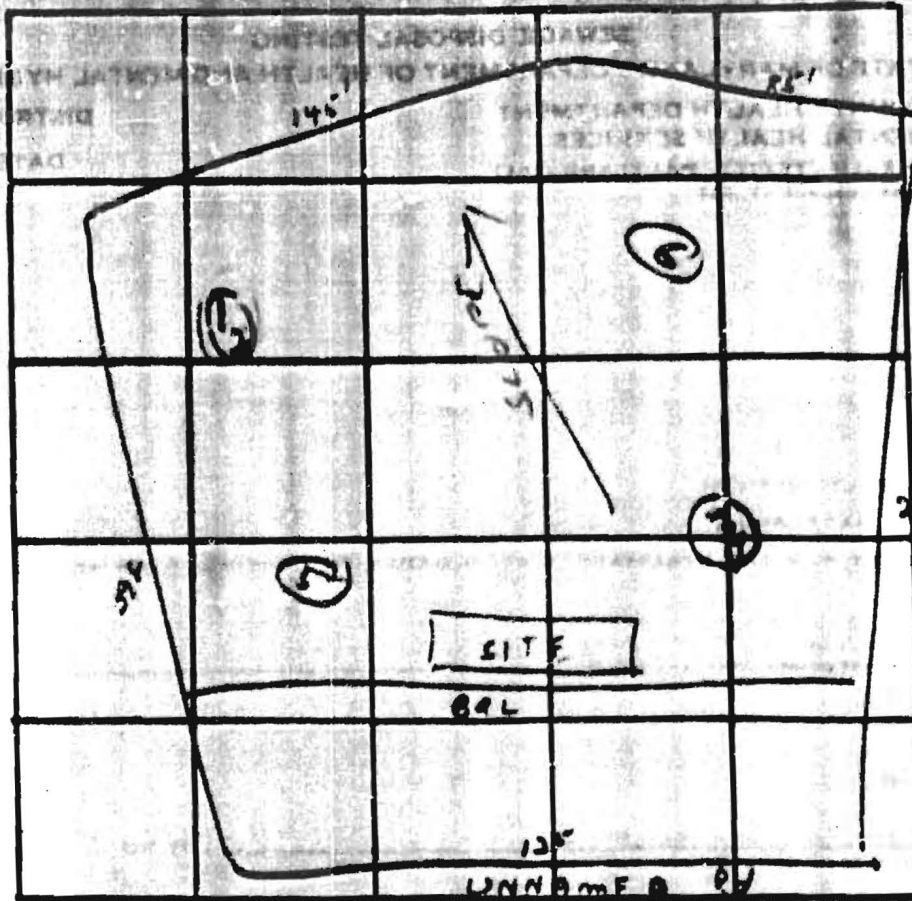

8-D

E = 12
inlet = 5

DATE	TEST NO.	DEPTH	PRE-WET		TEST - 1" DROP		TIME
			START	STOP	START	STOP	
11/1/77	1	13"	10 ⁵⁵	—	—	11 ⁰⁰	7 min
	2	5"	10 ⁵⁵	—	—	10 ⁰⁰	5 min
	3	12"	11 ⁰⁰	11 ⁰⁰	11 ⁰⁰	11 ¹⁹	15 min
	4	6"	11 ⁰⁰	11 ⁰⁷	11 ⁰⁷	11 ¹⁵	8 min
11/2	5	10"	Vis				
"	6	10"	Vis				

REMARKS

R7

TYPE OF SOIL

SM


7/19/25

ED PONTIER

1" = 50'

July 20th
Approved
Septic Plan

PERMIT
OK 7/23/25

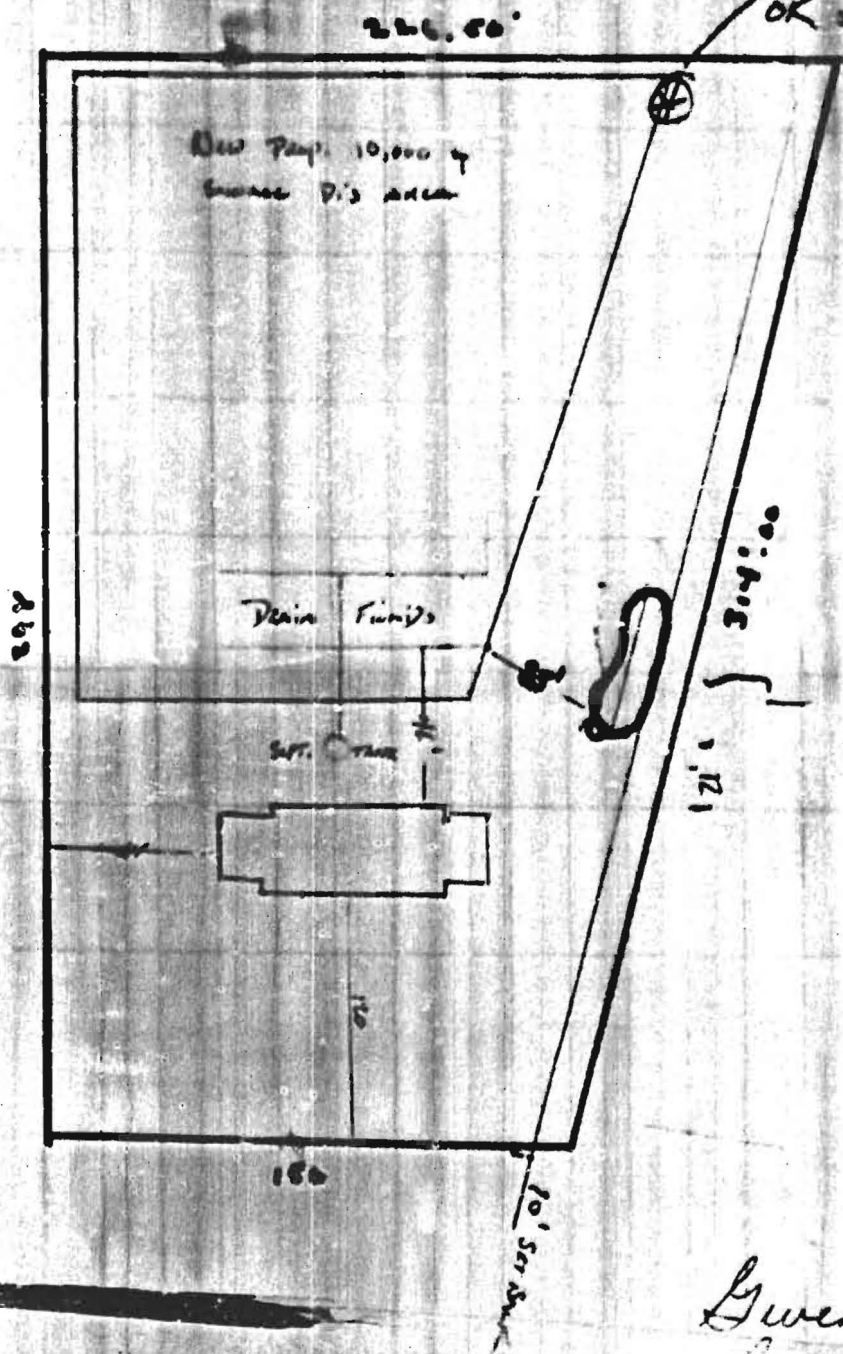

Gwendu Est.
Lot 6, Blk. 10
Gwendu Circle

APPLICATION

Deliver
3/23/79
9:30 A.M.

A19125

29583

SEWAGE DISPOSAL TESTING

STATE OF MARYLAND - DEPARTMENT OF HEALTH AND MENTAL HYGIENE

HOWARD COUNTY HEALTH DEPARTMENT
ENVIRONMENTAL HEALTH SERVICES
P.O. BOX 576 ELLICOTT, MARYLAND 21037
TELEPHONE 896-3330

DISTRICT 4

DATE 14 March 79

TO THE COUNTY HEALTH OFFICER
ELLICOTT CITY, MARYLAND

I HEREBY APPLY FOR THE NECESSARY TEST IN ORDER TO CONSTRUCT OR RECONSTRUCT A SEWAGE DISPOSAL SYSTEM

PROPERTY OWNER Edward & Barbara Pontier

(FOR MARYLAND POOLS - 744-5757)
MOB. 6 P.C.C.U.

ADDRESS 3254 Gwendolite Circle

PHONE 992-6074

PROPERTY LOCATION

SUBDIVISION Gwendolite Estates

LOT NO 6, Sec. 2

ROAD AND DESCRIPTION Need to move perc area because of pool that is going to be installed.

SIZE OF LOT

TYPE BLDG

THE SYSTEM INSTALLED UNDER THIS APPLICATION IS ACCEPTABLE ONLY UNTIL PUBLIC FACILITIES BECOME AVAILABLE.

I FULLY UNDERSTAND THE FEE CONNECTED WITH THE FILING OF THIS PERC TEST APPLICATION IS NON-REFUNDABLE UNDER

ANY CIRCUMSTANCES.

SIGNATURE OF APPLICANT Edward W. Pontier

APPROVED BY _____ FOR _____ DATE _____


REJECTED BY _____ FOR _____ DATE _____

HOLD PENDING FURTHER TESTS _____ DATE _____

REASONS FOR REJECTION OR HOLDING 3/23/79 - SEE PLANS FOR VIEW SWIM POOL SITE & CONSULT WITH P.A.

THIS IS NOT A PERMIT

①
SOIL PROFILE

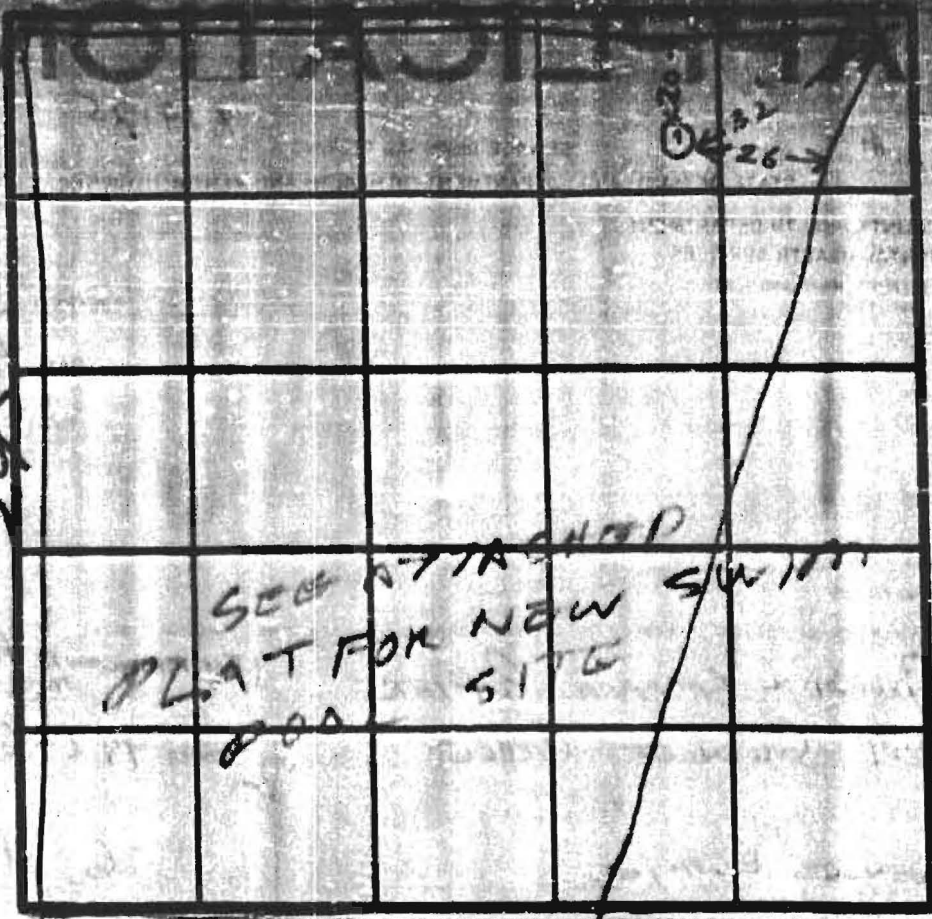

INDICATE NORTH - NAME ADJOINING ROADWAY AS EDGE LINE
R 17

DATE	TEST NO.	DEPTH	PRE-WET		TEST - 1" DEEP		TIME
			START	STOP	START	STOP	
5/23/72		15"	SEE	SOIL	PROFILE		

REMARKS SEE ATTACHED PLAT POOL SITE
CHANGED

TESTED BY R.H.

ALSO PRESENT BLANCH FOR CONTRACTOR
ROTTIER
ARNOLD