

PERMIT

SEWAGE DISPOSAL SYSTEM

MARYLAND STATE DEPARTMENT OF HEALTH*

HOWARD COUNTY

ELLICOTT CITY

DISTRICT _____

DATE 3/23/82

P 31844

A REPAIR

INDEX

Olen Ketterman

IS PERMITTED TO INSTALL _____ ALTER X

ADDRESS 14960 Frederick Road, Woodbine, Maryland 21797 PHONE 442-1336

SUBDIVISION Braeburn ROAD 10826 Braeburn ROAD LOT 23

PROPERTY OWNER Bill Veater (Young or Neuhman Previous owners) plat 1

ADDRESS 10826 Braeburn, Columbia, Md.

SPECIFICATIONS 3BR

SEPTIC TANK CAPACITY _____ GALLONS

DRAIN FIELD _____ DEPTH _____ FEET, BOTTOM AREA _____ SQ. FT.

DEEP TRENCH 1 DEPTH 11 FEET, BOTTOM AREA 460 SQ. FT. ONESIDE

SEEPAGE PITS _____ ABSORBENT SIDE-WALL AREA _____ SQ. FT.

INLET PIPE 3 FT. BELOW ORIGINAL GRADE. MAXIMUM DEPTH 11 FT. BELOW ORIGINAL GRADE

EFFECTIVE DEPTH AT _____ FT. BELOW ORIGINAL GRADE.

LOCATE DISPOSAL AREA _____ FT. FROM _____ LOT LINE AND _____ FT. FROM _____ LOT LINE AS SEEN WHEN

FACING LOT FROM ABOUT 135-140 FT FROM THE BACK

REPAIR-CALL FOR INSPECTION WHEN GROUND IS OPENED UP SO SANITARIAN CAN RECOMMEND REPAIR

OF THE HOUSE
A SEWAGE LIFT PUMP IS NEEDED

PLANS APPROVED BY Palmer F. Wine

DATE March 23, 1982

COVER NO WORK UNTIL INSPECTED AND APPROVED.

NEITHER THE HOWARD COUNTY COUNCIL NOR THE HEALTH DEPARTMENT IS RESPONSIBLE FOR THE SUCCESSFUL OPERATION OF ANY SYSTEM.

NOTE: IF TRENCH IS USED CALL FOR INSPECTION BEFORE PLACING GRAVEL IN TRENCH.

NOTE: NO DRY WELL SHALL EXCEED 15 FOOT IN DIAMETER.



NOTE: ALL PIPE FROM HOUSE TO DISPOSAL AREA MUST BE CAST IRON.

PERMIT VOID AFTER THREE YEARS.

NOTE: INSTALL STAND PIPE ON SEPTIC TANK AND DRY WELL. STAND PIPES MUST BE 6 INCHES IN DIAMETER. CAST IRON, CONCRETE OR TERRA COTTA ACCEPTED.

*INSTALLER IS RESPONSIBLE FOR OBTAINING FINAL APPROVAL ON THIS PERMIT.

X
P
31844

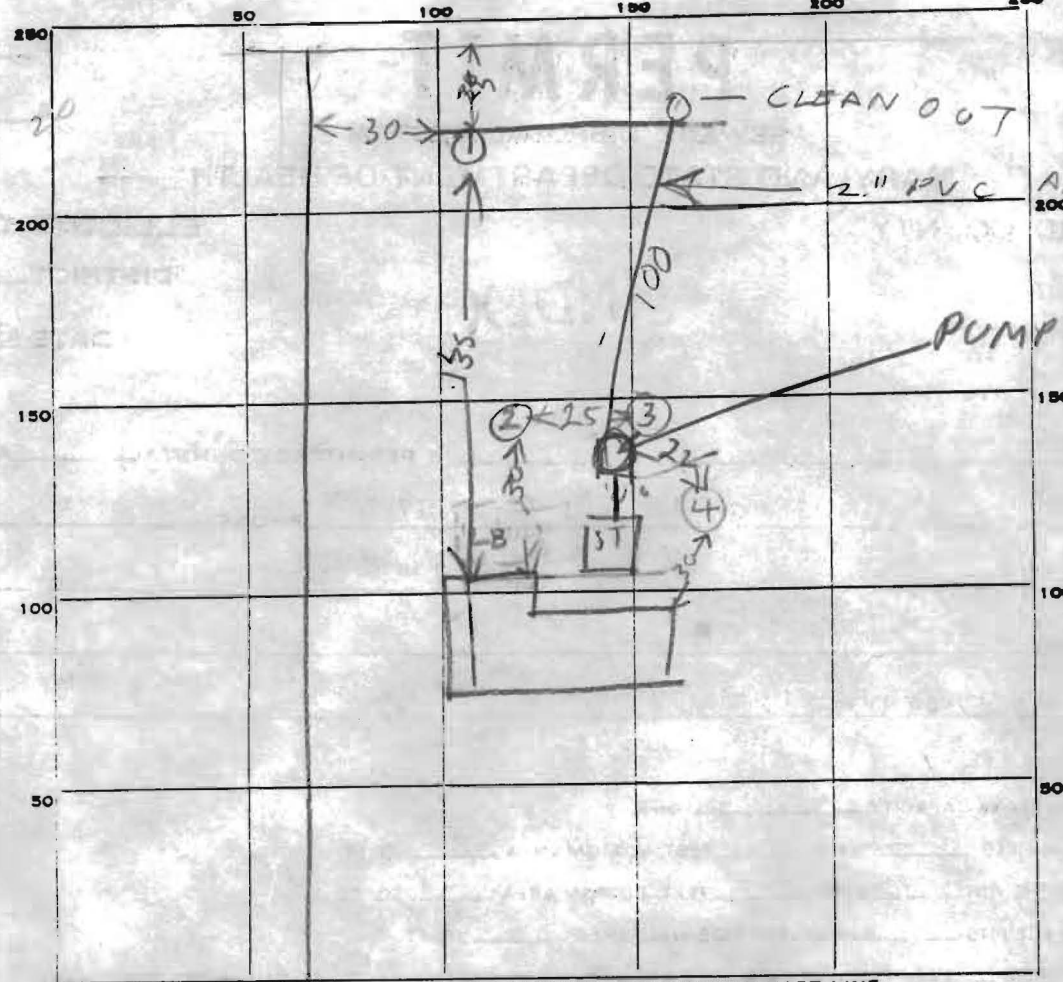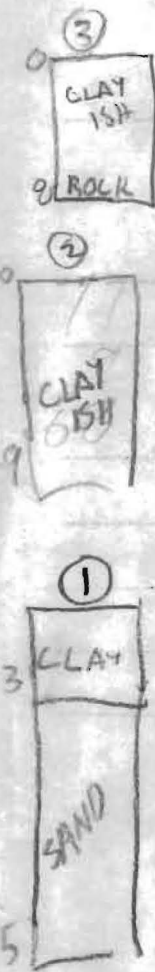

INDICATE NORTH. - NAME ADJOINING ROADWAY AS BASE LINE.

PERMIT CARD _____

SEPTIC TANK, LEVEL _____ CLEANOUTS _____

DISTRIBUTION BOX, LEVEL _____

TILE FIELD, DEPTH 11 FT. TRENCH WIDTH 2 FT.

GRAVEL DEPTH 2 FT IN. TOTAL LENGTH 68 FT.

NUMBER OF TRENCHES 1 TOTAL BOTTOM AREA _____

SEEPAGE PITS, INSIDE DIAMETER _____ FT. DEPTH BELOW INLET _____ FT.

ABSORBENT AREA _____ SQ. FT.

FR4A
Domestic Sewer
Pump
F.E. Myers Co.
USED
per Ketterman

REMARKS 3/23/82 VISUAL HOLE ① IS GOOD; BUT ② ③ ④ ARE
BAD. OLD SYSTEM WAS LEACHING BED WITH A EXTRA
DITCH. DEEP DITCH SYSTEM WITH PUMP NEEDED RA
3/24/82 - 1ST 60 FT OF DITCH FILLED WITH STONE. DITCH DUG
98 FT LONG NOW BEING FILLED WITH STONE FINISH
DITCH & COVER RA. PUMP INSTALLED BUT DID NOT
SEE PUMP MUST CALL KETTERMAN 911

DATE SYSTEM APPROVED 5/18/82 INSPECTOR T. Skeman

4/1/82 SEEN KETTERMAN WILL SUPPLY INFORMATION