

6/11/65  
Partial  
ready as soon  
as possible  
6/10/65

6/4/65 - Partial OK - JHK  
6/10/65 - Approved - JHK  
P 09662  
A 09425

# PERMIT

SEWAGE DISPOSAL SYSTEM

MARYLAND STATE DEPARTMENT OF HEALTH

HOWARD COUNTY

ELLICOTT CITY

## INDEXED

DISTRICT 5

DATE 2/18/65

Elwood Scaggs IS PERMITTED TO INSTALL  ALTER

ADDRESS Murphy Rd., Laurel, Md. PHONE PA 5-0324

A SEWAGE DISPOSAL SYSTEM LOCATED AT \_\_\_\_\_

SUBDIVISION Braeburn ROAD Braeburn Rd. LOT 23, Plat I

PROPERTY OWNER A. H. Young, Jr., Inc.

ADDRESS Ashton, Md.

SPECIFICATIONS - 4 bedrooms

DRAIN FIELD \_\_\_\_\_ DEPTH \_\_\_\_\_ FEET, BOTTOM AREA \_\_\_\_\_ SQ. FT.

SEEPAGE PITS \_\_\_\_\_ ABSORBENT SIDE-WALL AREA \_\_\_\_\_ SQ. FT.

SEPTIC TANK CAPACITY 1,000 GALLONS

FOR GARBAGE GRINDER, INCREASE DISPOSAL AREA 22% & TANK CAPACITY 50%.

OTHER Leaching bed - 400 sq. ft. bottom area installed at a depth of 5 ft. below original grade. This depth includes the bottom of gravel. Place leaching bed between 125 and 150 ft. from front lot line and between 18 and 75 ft. from left side line as seen when facing lot from Braeburn Rd.


**NOTE: CALL OF INSPECTION OF LEACHING BED EXCAVATION BEFORE ANY GRAVEL IS INSTALLED.**

PLANS APPROVED BY D. W. Monaghan DATE 12/22/64

FILL SEPTIC TANK AND DISTRIBUTION BOX WITH WATER BEFORE CALLING FOR AN INSPECTION. COVER NO WORK UNTIL INSPECTED AND APPROVED.

NEITHER THE HOWARD COUNTY COMMISSIONERS NOR THE HEALTH DEPARTMENT IS RESPONSIBLE FOR THE SUCCESSFUL OPERATION OF ANY SYSTEM.

A 09425-

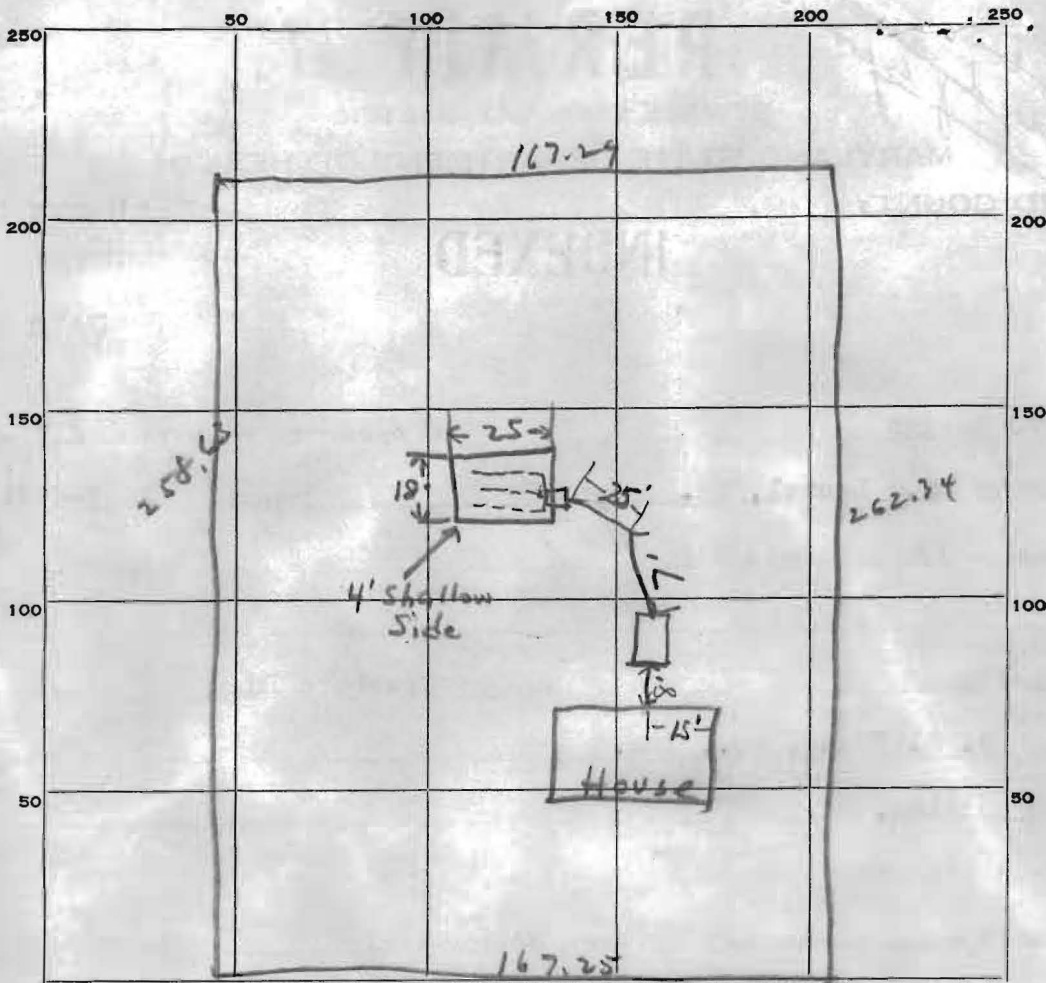

INDICATE NORTH. - NAME ADJOINING ROADWAY AS BASE LINE.

Braeburn Rd.

PERMIT CARD OK

SEPTIC TANK, LEVEL OK CLEANOUTS OK

DISTRIBUTION BOX, LEVEL OK

TILE FIELD, DEPTH 5 FT. TRENCH WIDTH 18 FT.

GRAVEL DEPTH 36 IN. TOTAL LENGTH 25 FT.

NUMBER OF TRENCHES \_\_\_\_\_ TOTAL BOTTOM AREA 450 sq. ft.

SEEPAGE PITS, INSIDE DIAMETER \_\_\_\_\_ FT. DEPTH BELOW INLET \_\_\_\_\_ FT.

ABSORBENT AREA \_\_\_\_\_ SQ. FT.

REMARKS 4/4/65 - Partial OK - JHK  
6/10/65 - Approved - JHK

DATE SYSTEM APPROVED 6/10/65 INSPECTOR J.H. Kilmore