

06605

SEQUENCE NO. (MDE USE ONLY)

STATE OF MARYLAND WELL COMPLETION REPORT

THIS REPORT MUST BE SUBMITTED WITHIN 45 DAYS AFTER WELL IS COMPLETED.

(THIS NUMBER IS TO BE PUNCHED IN COLS. 3-6 ON ALL CARDS)

COUNTY NUMBER A09917

ST/CO USE ONLY DATE Received MM DD YY

DATE WELL COMPLETED MM DD YY 7/21/99

Depth of Well 22 26 (TO NEAREST FOOT)

PERMIT NO. FROM "PERMIT TO DRILL WELL" HO-94-2304

OWNER Knoy, Sandra Edenton Court, Fulton, Beaufort Park, SECTION, LOT 8

WELL LOG Not required for driven wells. STATE THE KIND OF FORMATIONS PENETRATED... PERM TAG RETURNED DESTROYED MR 1/10/00

GROUTING RECORD WELL HAS BEEN GROUTED (Circle Appropriate Box) Y N

TYPE OF GROUTING MATERIAL (Circle one) CEMENT CM BENTONITE CLAY BC NO. OF BAGS NO. OF POUNDS

GALLONS OF WATER DEPTH OF GROUT SEAL (to nearest foot) from 48 TOP 52 ft. to 54 BOTTOM 58 ft.

CASING RECORD casing types insert appropriate code below MAIN CASING TYPE Nominal diameter top (main) casing (nearest inch)! Total depth of main casing (nearest foot)

OTHER CASING (if used) diameter inch depth (feet) from to

SCREEN RECORD screen type or open hole (insert appropriate code below) ST BR HO PL OT

DEPTH (nearest ft.) 1 2 3 4 5 6 7 8 9 11 15 17 21 23 24 26 30 32 36 38 39 41 45 47 51

SLOT SIZE 1 2 3 DIAMETER OF SCREEN (NEAREST INCH) 56 60

GRAVEL PACK IF WELL DRILLED WAS FLOWING WELL INSERT F IN BOX 68 MDE USE ONLY (NOT TO BE FILLED IN BY DRILLER)

TELESCOPE CASING LOG INDICATOR OTHER DATA

PUMPING TEST HOURS PUMPED (nearest hour) 8 9

PUMPING RATE (gal. per min.) 11 15

METHOD USED TO MEASURE PUMPING RATE WATER LEVEL (distance from land surface)

BEFORE PUMPING 17 20 ft. WHEN PUMPING 22 25 ft.

TYPE OF PUMP USED (for test) A air P piston T turbine C centrifugal R rotary O other (describe below) J jet S submersible

PUMP INSTALLED DRILLER WILL INSTALL PUMP YES NO (CIRCLE) (YES or NO)

IF DRILLER INSTALLS PUMP, THIS SECTION MUST BE COMPLETED FOR ALL WELLS. TYPE OF PUMP INSTALLED PLACE (A,C,J,P,R,S,T,O) IN BOX 29

CAPACITY: GALLONS PER MINUTE (to nearest gallon) 31 35

PUMP HORSE POWER 37 41 PUMP COLUMN LENGTH (nearest ft.) 43 47

CASING HEIGHT (circle appropriate box and enter casing height) + above } LAND SURFACE (nearest foot) - below }

LOCATION OF WELL ON LOT SHOW PERMANENT STRUCTURE SUCH AS BUILDING, SEPTIC TANKS, AND /OR LANDMARKS AND INDICATE NOT LESS THAN TWO DISTANCES (MEASUREMENTS TO WELL)

NUMBER OF UNSUCCESSFUL WELLS: 1 WELL HYDROFRACTURED yes no Y N

CIRCLE APPROPRIATE LETTER A A WELL WAS ABANDONED AND SEALED WHEN THIS WELL WAS COMPLETED E ELECTRIC LOG OBTAINED P TEST WELL CONVERTED TO PRODUCTION WELL

I HEREBY CERTIFY THAT THIS WELL HAS BEEN CONSTRUCTED IN ACCORDANCE WITH COMAR 26.04.04 "WELL CONSTRUCTION" AND IN CONFORMANCE WITH ALL CONDITIONS STATED IN THE ABOVE CAPTIONED PERMIT...

DRILLERS LIC. NO. 1 M W D 640

DRILLERS SIGNATURE (MUST MATCH SIGNATURE ON APPLICATION) LIC. NO. 1 M W D 501

SITE SUPERVISOR (sign. of driller or journeyman responsible for sitework if different from permittee)

B 1 8692

SEQUENCE NO. (MDE USE ONLY)

STATE OF MARYLAND PERMIT TO DRILL WELL please print or type

STATE PERMIT NUMBER

HO - 94 - 2304 fill in this form completely

Date Received (APA) 05 14 94

OWNER INFORMATION RN 7858

B 3 LOCATION OF WELL


Owner: Knox Sondra, Address: 5639 Broadwater Lane, Clarksville, Md 21029-1158

Howard County, Beaufort Park Subdivision, Section 44, Lot 8, Fulton, 2 miles from town

DRILLER INFORMATION

Driller's Name: George F. Easterday, License No. MW 040, Firm Name: L. Franklin Easterday, Inc., Address: 9265 Brown Church Rd., MT. Airv. Md. 21771, Signature: George F. Easterday, Date: 5/12/1999

B 4

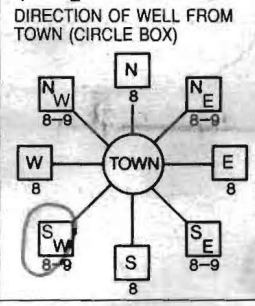

Edenton Ct, 438 feet from road, Tax map information

WELL INFORMATION: APPROX. PUMPING RATE 5 GAL. PER MIN., AVERAGE DAILY QUANTITY NEEDED 500 GAL. PER DAY

NOT TO BE FILLED IN BY DRILLER HEALTH DEPARTMENT APPROVAL

HOWARD COUNTY, A09917, DATE ISSUED 06/22/99, NORTH GRID 474 000, EAST GRID 0817 000

- USE FOR WATER (CIRCLE APPROPRIATE BOX): D DOMESTIC POTABLE SUPPLY & RESIDENTIAL IRRIGATION, F FARMING, I INDUSTRIAL, P PUBLIC WATER SUPPLY WELL, T TEST, G GEO-THERMAL


APPROXIMATE DEPTH OF WELL 300 FEET

APPROXIMATE DIAMETER OF WELL 6 INCH

METHOD OF DRILLING (circle one): BORED (or Augered), AIR-ROtary, CABLE, JETTED, AIR-PERcussion, REVerse-ROtary, Jetted & DRIVEN, ROTARY (Hydraulic Rotary), DRive-POINT

REPLACEMENT OR DEEPEMED WELLS (CIRCLE APPROPRIATE BOX): N THIS WELL WILL NOT REPLACE AN EXISTING WELL, Y THIS WELL WILL REPLACE A WELL THAT WILL BE ABANDONED AND SEALED, S THIS WELL WILL REPLACE A WELL THAT WILL BE USED AS A STANDBY-CONTACT LOCAL APPROVING AUTHORITY FOR POLICY ON STANDBY WELLS, D THIS WELL WILL DEEPEMED AN EXISTING WELL

Not to be filled in by driller (MDE OR COUNTY USE ONLY): APPROP. PERMIT NUMBER GAP, PERMIT No. HO - 94 - 2304

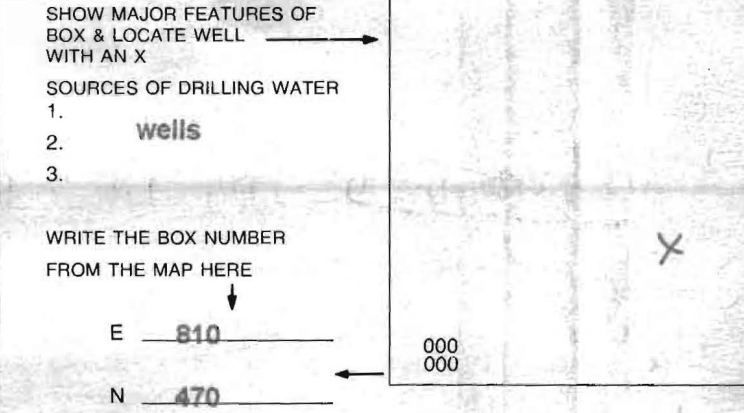


SPECIAL CONDITIONS: Buyer 410-750-9649 Nancy Watts

PLAT TWO, BLOCK F
 LOT 8
 BEAUFORT PARK
 HOWARD COUNTY

APPROVED FOR PRIVATE
 WELL AND SEPTIC,
 HOWARD COUNTY
 HEALTH DEPARTMENT

J. M. [Signature]
 HOWARD COUNTY 9-30-97
 HEALTH OFFICER

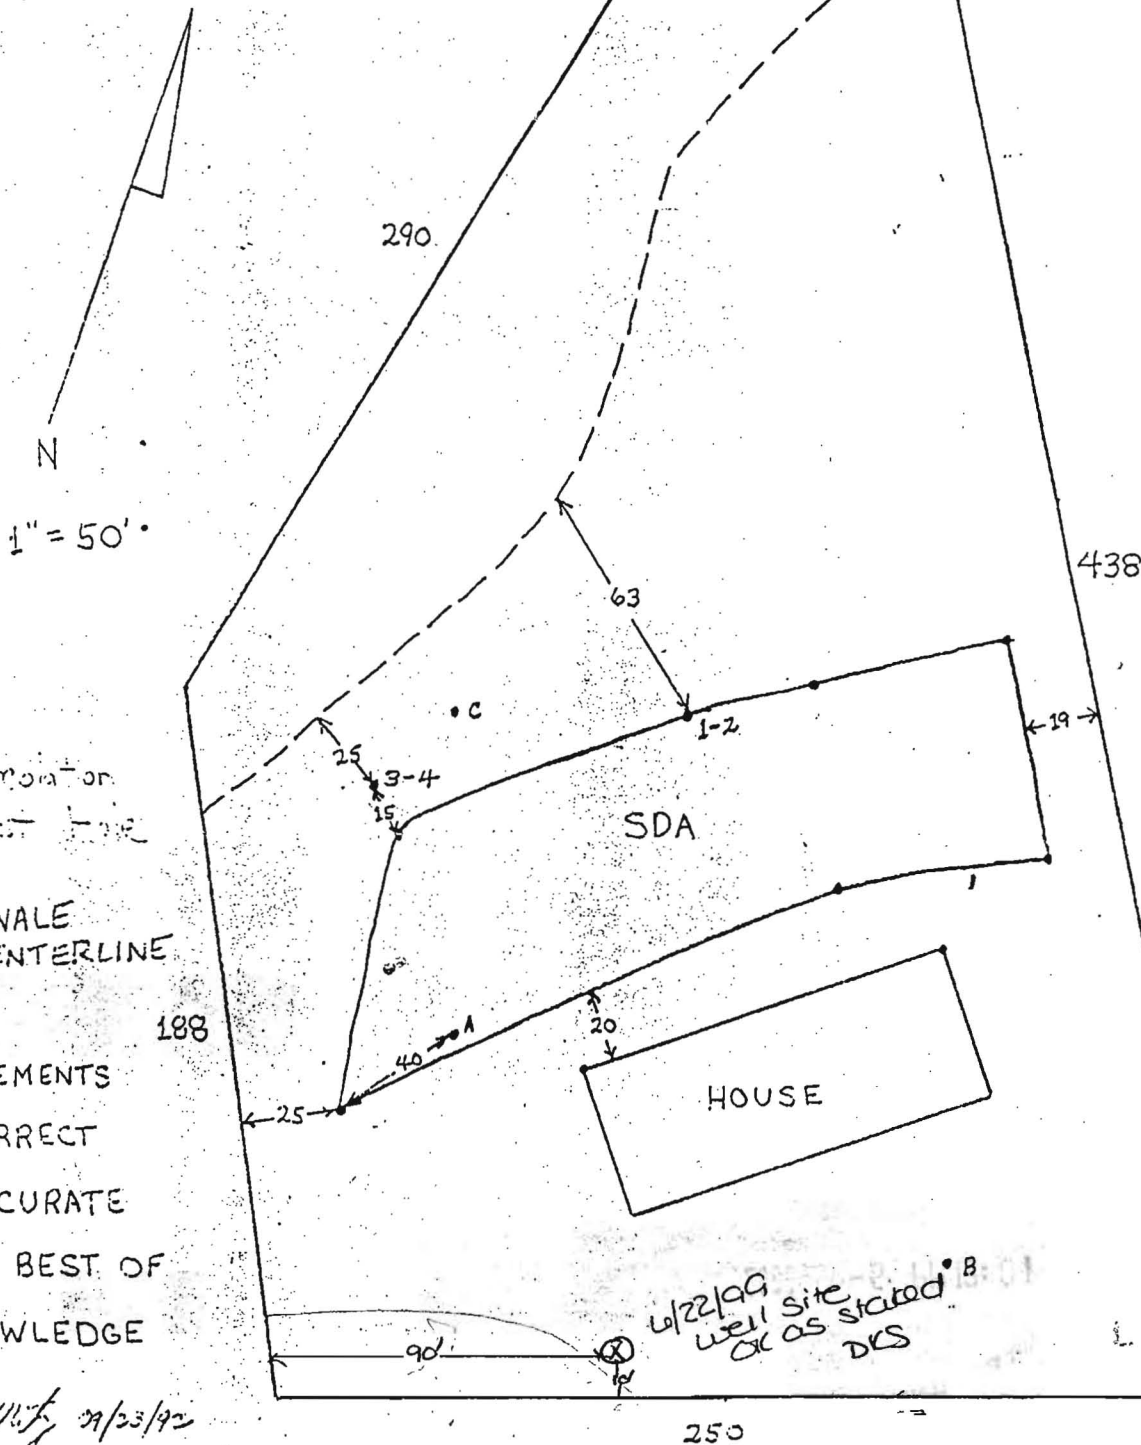

Removal
 Test Line
 SWALE
 CENTERLINE
 MEASUREMENTS
 CORRECT
 ACCURATE
 THE BEST OF
 KNOWLEDGE

RECEIVED

MAY 06 1999

L. FRANKLIN EASTERDAY INC.

[Signature] 09/23/92

250