

STATE OF MARYLAND WATER RESOURCES ADMINISTRATION
TAXES STATE OFFICE BLDG., ANNAPOLIS, MD. 21401
WELL COMPLETION REPORT

THIS REPORT MUST BE SUBMITTED WITHIN 30 DAYS AFTER WELL COMPLETION
 FILL IN THIS FORM COMPLETELY
 COUNTY NUMBER

6157
 DEPTH OF WELL 250
 DATE WELL COMPLETED 8/1/75
 PERMIT NO. FROM "PERMIT TO DRILL WELL" HIC-13-110019
 DRILLERS IDENTIFICATION NO. 209

OWNER LAST NAME **FISHER** FIRST NAME **WILLIAM E**
 STREET OR RFD **14014 BARBRA CIRCLE** POST OFFICE **LOXSVILLE 21725**

WELL LOG
 STATE THE KIND OF FORMATIONS PENETRATED, THEIR COLOR, DEPTH, THICKNESS AND IF WATER BEARING

DESCRIPTION USE APPROPRIATE SHEETS IF NECESSARY	FEET		DIBBLE P MARKS
	FROM	TO	
Flint Rock			
Boulders	0	10	
Mica sand	10	60	
Mica Rock	60	250	

GRouting RECORD
 WELL HAS BEEN GROUTED (CIRCLE APPROPRIATE BOX) YES NO
 TYPE OF GROUTING MATERIAL (CIRCLE ONE)
 CEMENT PORTLAND CEMENT PORTLAND CEMENT
 NO. OF BAGS 16 NO. OF POUNDS 975
 GALLONS OF WATER 100
 DEPTH OF GROUT SEAL (TO NEAREST FOOT) 0

CASING RECORD
 Casing Type: STEEL CONCRETE
 MAIN CASING TYPE: S T
 NOMINAL DIAMETER TOP (MAIN CASING) (NEAREST INCH) 6
 TOTAL DEPTH OF MAIN CASING (NEAREST FOOT) 70

OTHER CASING (IF USED)
 DIAMETER (INCH) _____ DEPTH (FEET) FROM _____ TO _____

SCREEN RECORD
 SCREEN TYPE (CIRCLE ONE): S B H D
 DIAMETER OF SCREEN 20 (NEAREST INCH)
 GRAVEL PACK YES NO

PUMPING TEST
 HOURS PUMPED (TO NEAREST HOUR) 6
 PUMPING RATE (GALLONS PER MINUTE TO NEAREST GALLON) 4
 METHOD USED TO MEASURE PUMPING RATE: TIME
 WATER LEVEL (FEET) _____

TYPE OF PUMPED USED (CIRCLE APPROPRIATE BOX)
 AIR PISTON TURBINE
 CENTRIFUGAL ROTARY OTHER (SPECIFY BELOW)
 JET SUBMERSIBLE

PUMP INSTALLED
 TYPE OF PUMP (WRITE APPROPRIATE LETTER IN BOX - SEE ABOVE: A, C, A, P, R, S, V, O)
 DRILLER WILL INSTALL PUMP (CIRCLE APPROPRIATE BOX) YES NO
 CAPACITY: GALLONS PER MINUTE (TO NEAREST GALLON) 37

CASING HEIGHT (CIRCLE APPROPRIATE BOX AND ENTER CASING HEIGHT)
 ABOVE BELOW
 LAND SURFACE (NEAREST FOOT) 2

LOCATION OF WELL ON LOT
 SHOW PERMANENT STRUCTURE SUCH AS BUILDINGS, DEPTIC TANKS, AND/OR OTHER LAND MARKS - TO INDICATE NOT LESS THAN TWO DISTANCE MEASUREMENTS TO WELL.
 HOUSE

CIRCLE APPROPRIATE BOXES
 A - WELL WAS ABANDONED AND SEALED WHEN THIS WELL WAS COMPLETED
 E - ELECTRIC LOG OBTAINED
 P - TEST WELL CONVERTED TO PRODUCTION WELL


I HEREBY CERTIFY THAT I HAVE COMPLIED WITH ALL CONDITIONS STATED ON THE ABOVE-CAPTIONED "PERMIT TO DRILL WELL", AND THAT INFORMATION CONTAINED IN THIS REPORT IS TRUE, ACCURATE, AND COMPLETE TO THE BEST OF MY KNOWLEDGE, INFORMATION AND BELIEF.

DRILLERS NAME: **HOWARD D. HILL**
 SIGNATURE: *Howard D. Hill*

EACH SCREEN
 DEPTH (NEAREST WHOLE FOOT) FROM 15 TO 21
 DIAMETER OF SCREEN 20 (NEAREST INCH)
 GRAVEL PACK YES NO
 IF WELL DRILLED WAS A FLOWING WELL (CIRCLE ONE) YES NO
 WRA USE ONLY (NOT TO BE FILLED IN BY DRILLER) (E.R.D.S.)
 TELESCOPE CASING YES NO
 LOG INDICATOR YES NO
 OTHER DATA AVAILABLE



PAPERNA CIGARS

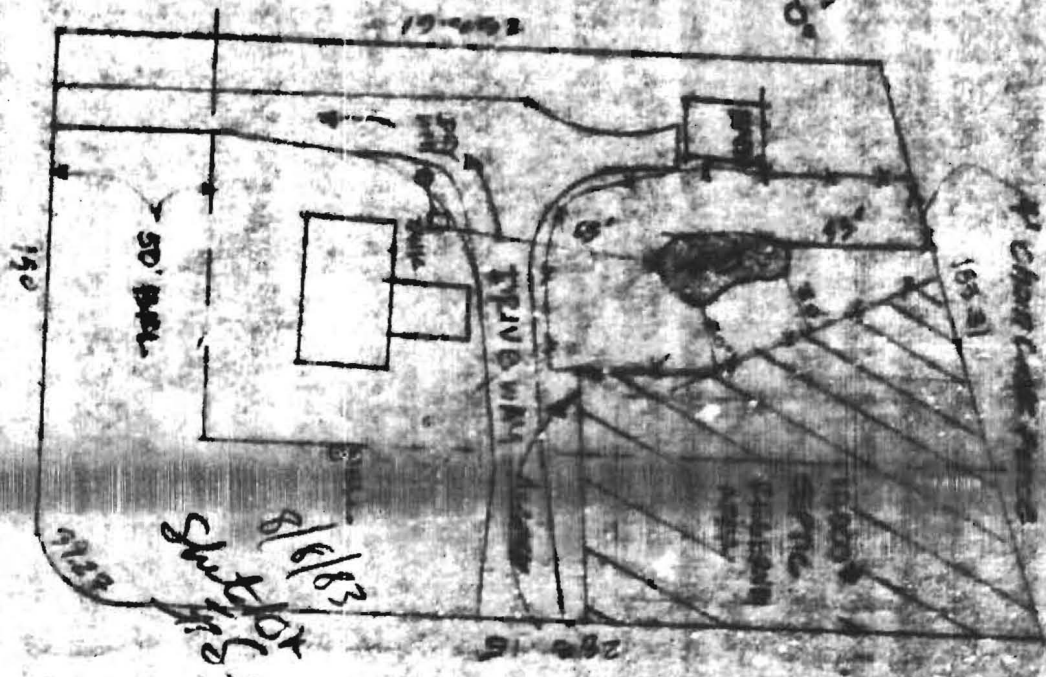

MONTICELLO

8/19/83
Shut off
toilet

- NOTES
- ① POOL LOCAT
 - ② PLACE 2' GIP
 - ③ DIET HAUL

