

6/13/73
2:30 -
hole

APPLICATION

A 12121
P _____

SEWAGE DISPOSAL TESTING

MARYLAND STATE DEPARTMENT OF HEALTH

HOWARD COUNTY

ELLICOTT CITY

Septic Tank - 750 gal

DISTRICT 4

Dry Well - 300 ^{12 3 9} ft. abundant subwallaria below index DATE 8/22/65
the depth 312 ft of non absorbent ground.

Place Dry Well within 100 or 140 ft from Monticello Drive lot line and about 110 ft from Barbara Circle Lot line. Max depth permitted for all is 11 ft below original grade.

TO: THE COUNTY HEALTH OFFICER
ELLICOTT CITY, MARYLAND

I, HEREBY, APPLY FOR THE NECESSARY TESTS IN ORDER TO CONSTRUCT OR RECONSTRUCT A SEWAGE DISPOSAL SYSTEM.

PROPERTY OWNER Dominic & Lexie Monticello

ADDRESS Cooksville, Maryland PHONE HU 9-4420

PROPERTY LOCATION:

SUBDIVISION Villa Monticello LOT NO. 6, Sec. 2

ROAD AND DESCRIPTION Corner of Monticello Dr. & Barbara Circle

OCCUPANT _____ PHONE _____

PERSON TO CONSTRUCT SYSTEM _____

ADDRESS _____ PHONE _____

SIZE OF LOT 1.13 acres TYPE BLDG. 3
NUMBER OF BEDROOMS

IF NOT SINGLE RESIDENCE DESCRIBE _____

SIGNATURE OF APPLICANT Dominic Monticello


APPROVED BY Donald W. Macgibbon FOR Dry Well DATE 8/24/66
(KIND OF SYSTEM)

REJECTED BY _____ FOR _____ DATE _____
(KIND OF SYSTEM)

HOLD PENDING FURTHER TESTS _____ DATE _____

REASONS FOR REJECTION OR HOLDING _____

THIS IS NOT A PERMIT

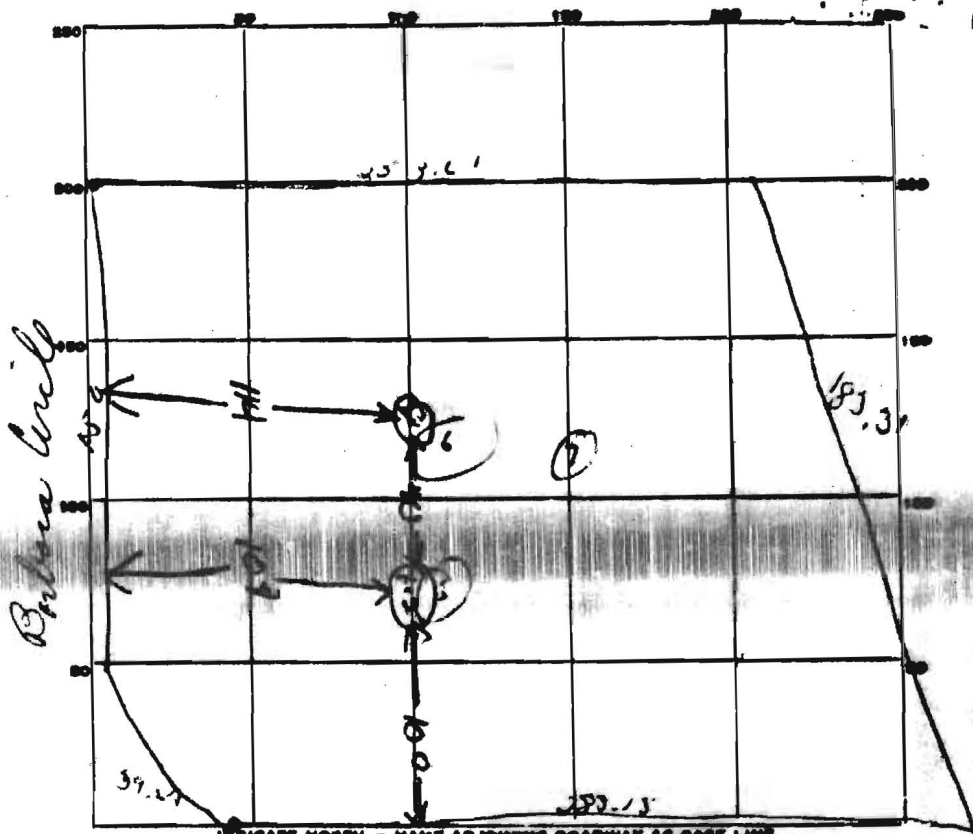

INDICATE NORTH. - NAME ADJOINING ROADWAY AS EAST LINE.

Montecillo Drive

DATE	TEST NO.	DEPTH	PRE-WET		TEST - 1" DROP		TIME
			START	STOP	START	STOP	
9/1/6	1	9 ft	9 22	9 22	9 22	9 21	9 min
	2	4 ft	9 20	9 24	9 24	9 20	6 min
	3	9 ft	9 24	9 26	9 26	9 32	6 min
	4	2 ft	9 24	9 27	9 27	9 31	4 min
	5	11 1/2'					
	6	11 1/2'					
	7	11 1/2'					

SOIL AUGER FINDING

TESTED BY

REMARKS

all M.S.
Human Soil