

11/21/73

11-2677

District P 19311

A 12121

PERMIT

SEWAGE DISPOSAL SYSTEM

MARYLAND STATE DEPARTMENT OF HEALTH

HOWARD COUNTY

ELLICOTT CITY

INDEXED

DISTRICT 4th

DATE 11/20/73

William Hopkins IS PERMITTED TO INSTALL X ALTER

ADDRESS Jennings Chapel Road, Woodbine, Maryland PHONE 404-4721

A SEWAGE DISPOSAL SYSTEM LOCATED AT _____

SUBDIVISION Villa Monticello ROAD 14114 Barbara Circle LOT 6, Sec. 3

PROPERTY OWNER William Fisher

ADDRESS 7923 Kavanaugh Road, Baltimore, Md. 21222 Phone: 284-9475

SPECIFICATIONS 3 bedrooms

DRAIN FIELD _____ DEPTH _____ FEET, BOTTOM AREA _____ SQ. FT.

SEEPAGE PITS _____ ABSORBENT SIDE-WALL AREA _____ SQ. FT.

SEPTIC TANK CAPACITY 1800 GALLONS

FOR GARBAGE GRINDER, INCREASE DISPOSAL AREA 25% & TANK CAPACITY 50%.

OTHER DRY WELL - 300 sq. ft. about 12" below the ground surface below the first 2 ft. of
has successful ground. Maximum depth permitted for dry well is 11 ft. below origi-
nal grade. Place the dry well either 100 or 140 ft. from Monticello Drive lot
line and about 110 ft. from Barbara Circle lot line.

NOTE: ALL PIPE FROM HOUSE TO DRY WELL MUST BE CAST IRON.

PERMIT VOID AFTER THREE YEARS.

NOTE: INSTALL STAND PIPE ON SEPTIC TANK AND DRY WELL.

PLANS APPROVED BY Donald V. Monaghan DATE 8/24/66 & 6/13/73

FILL SEPTIC TANK AND DISTRIBUTION BOX WITH WATER BEFORE CALLING FOR AN INSPECTION. COVER NO WORK UNTIL INSPECTED AND APPROVED.


NEITHER THE HOWARD COUNTY COMMISSIONERS NOR THE HEALTH DEPARTMENT IS RESPONSIBLE FOR THE SUCCESSFUL OPERATION OF ANY SYSTEM.

8/8/83

Permit OK

BLDG. PERMIT SIGNED
AND RETURNED 10/1/83
Serial # 53762
Prot.

11/21/73

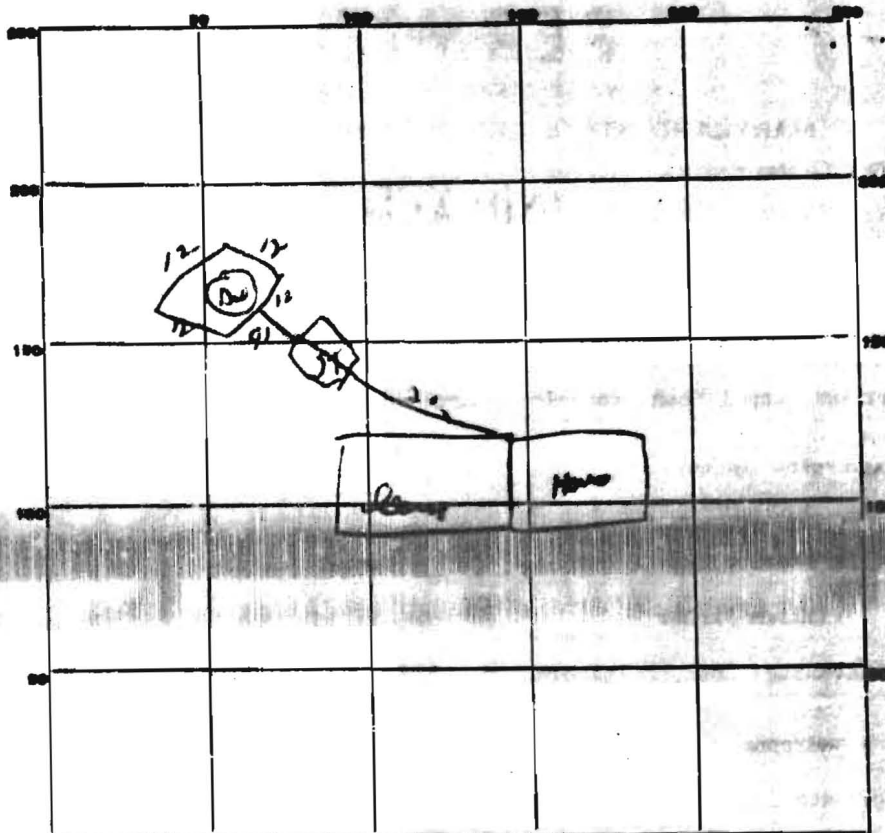

INDICATE NORTH. - NAME ADJOINING ROADWAY AS BASE LINE.

PERMIT CARD OK

Barbora Ln

SEPTIC TANK, LEVEL OK

CLEANOUTS OK

DISTRIBUTION BOX, LEVEL _____

TILE FIELD, DEPTH _____ FT. TRENCH WIDTH _____ FT.

GRAVEL DEPTH _____ IN. TOTAL LENGTH _____ FT.

NUMBER OF TRENCHES _____ TOTAL BOTTOM AREA _____

SEEPAGE PITS, INSIDE DIAMETER Perimeter 48 FT. DEPTH BELOW INLET 7+ FT.

ABSORBENT AREA 396+ SQ. FT.

REMARKS 11/1/77 appears there is not enough fill in line from house to tank - DCM

DATE SYSTEM APPROVED 1/24/77 INSPECTOR D.M. Morgan