


A#00997

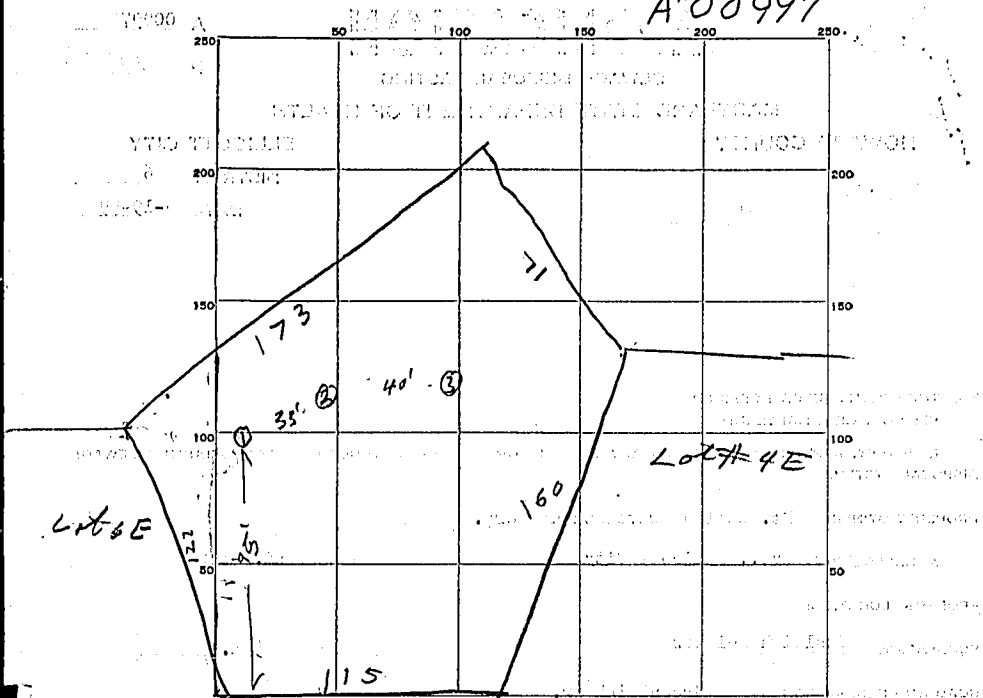

INDICATE NORTH - NAME ADJOINING ROADWAY AS BASE LINE.

GREEN LEIGH

DATE	TEST NO.	DEPTH	PRE-WET		TEST - 1" DROP		TIME
			START	STOP	START	STOP	
5/26	1	3	1023	1027	1027	1032	5 min
	2	3 1/2	1024	1027	1027	1031	4 min
	3	3	1026	1031	1031	1037	6 min

SOIL AUGER FINDING \_\_\_\_\_

TESTED BY Raymond Hodges

REMARKS \_\_\_\_\_

ALSO PRESENT Robert A. Bant LOT NO. 5E