

APPLICATION

PERCOLATION TESTING

A REPAIR
P 518010

HOWARD COUNTY HEALTH DEPARTMENT
BUREAU OF ENVIRONMENTAL HEALTH
3525-H ELLICOTT MILLS DRIVE/ELLICOTT CITY, MARYLAND 21043
TELEPHONE: 313-2840

DISTRICT _____
DATE 11/26/02

TO: THE COUNTY HEALTH OFFICER
ELLICOTT CITY, MARYLAND

10,000 # not required - Historical House

I HEREBY APPLY FOR THE NECESSARY TEST PRIOR TO APPLICATION FOR PERMIT TO CONSTRUCT (OR RECONSTRUCT) A SEWAGE DISPOSAL SYSTEM.

PROPERTY OWNER Kathleen i. Franco DiValentin

ADDRESS 139160 Howard Rd Dayton MD 21036 PHONE 443-535-0274

AGENT OR PROSPECTIVE BUYER _____

ADDRESS _____ PHONE _____

PROPERTY LOCATION:

SUBDIVISION _____ LOT NO. _____

ROAD AND DESCRIPTION Same

TAX MAP 28 PARCEL # 93

SIZE OF LOT 3.5 acres TYPE BLDG. SFD w/ addition
(SINGLE FAMILY DWELLING OR COMMERCIAL)

THE SYSTEM INSTALLED UNDER THIS APPLICATION IS ACCEPTABLE ONLY UNTIL PUBLIC FACILITIES BECOME AVAILABLE. I FULLY UNDERSTAND THE FEE CONNECTED WITH THE FILING OF THIS PERC TEST APPLICATION IS NON-REFUNDABLE UNDER ANY CIRCUMSTANCES. I ALSO AGREE TO COMPLY WITH ALL M.O.S.H.A. REQUIREMENTS IN TESTING THIS LOT. Kathleen DiValentin
(SIGNATURE OF APPLICANT)

APPROVED BY _____ FOR _____ DATE _____

DISAPPROVED BY _____ FOR _____ DATE _____

HOLD PENDING FURTHER TESTS _____

REASONS FOR REJECTION OR HOLDING _____

PERCOLATION TEST PLAT/PRELIMINARY PLAT - TITLE OR I.D. # _____ DATE _____

SITE DEVELOPMENT PLAN/FINAL PLAT - TITLE OR I.D. # _____ DATE _____

THIS IS NOT A PERMIT


MJR

11/26/02 OFFICE MTG w/OWNER
FOR 2 BR ADD'N TO EX. 2 BR HOUSE
(1 EX. BR MAY BE CONVERTED TO
NON-BR USE)

EX. WELL BELIEVED TO BE MODERN,
NO RECORD FOUND;

PERC TEST REQ'D TO
VERIFY SOILS @ EX. SYSTEM
AND ESTABLISH REPAIR
CAPACITY.

OWNER AWARE THAT
TOTAL SYSTEM
REPLACEMENT
POSSIBLE

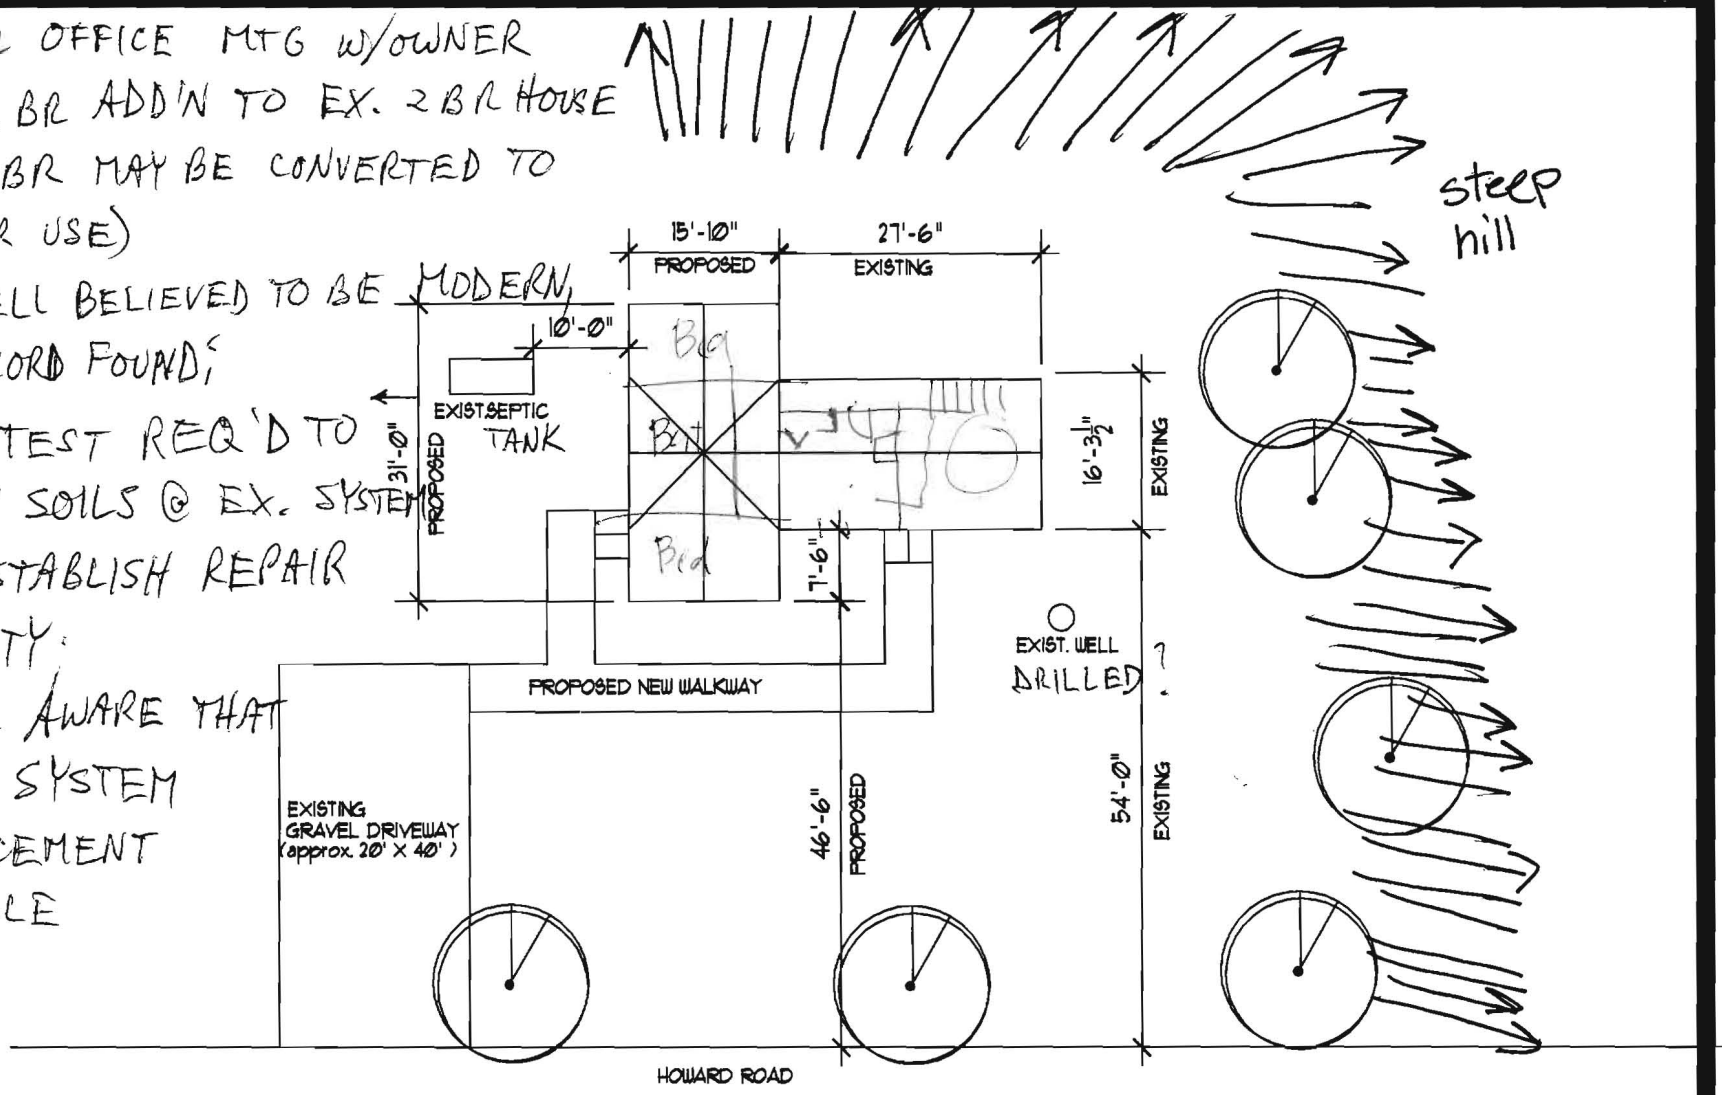

2 ROOF/SITE PLAN
SCALE 1" = 20'

Divalentin Residence
13960 Howard Road
Dayton MD 21036
Howard County
Variance Petition