

PUB. SEWER STATUS VERIFIED BY MR

ISSUE DATE: 12/17/02

APPROVAL DATE: 12/30/02

PERMIT INDEXED

P 518026-B

A REPAIR

ON-SITE SEWAGE DISPOSAL SYSTEM HOWARD COUNTY HEALTH DEPARTMENT BUREAU OF ENVIRONMENTAL HEALTH

05-348323

Jack Fyock Septic Service IS PERMITTED TO INSTALL ALTER

ADDRESS: _____ PHONE NUMBER: 410-988-9270

SUBDIVISION: Tax Map 40, Parcel 83 LOT NUMBER: _____

ADDRESS: 13376 Route 108 PROPERTY OWNER: James Glynn

SEPTIC TANK CAPACITY (GALLONS): 1000

PUMP CHAMBER CAPACITY (GALLONS): _____

NUMBER OF BEDROOMS: _____

SQUARE FEET PER BEDROOM: _____

LINEAR FEET OF TRENCH REQUIRED: _____

TRENCHES:	Trench to be _____ feet wide. Inlet _____ feet below original grade. Bottom maximum depth _____ feet below original grade. Effective area begins at _____ feet below original grade. _____ feet of stone below distribution pipe.
LOCATION:	Existing septic tank to be excavated to verify construction. If not concrete, replace with concrete tank. Seal tank outlet to convert to holding tank. Pump and abandon existing drywell, if present. Install non-electric visual alarm. No trenches/drainfield to be installed.
PURPOSE:	To eliminate existing drainfield in order to reduce contamination risk to proposed replacement well to be drilled in close proximity to septic tank in rear parking lot.

PLANS APPROVED: MER DATE: 11/22/02


- NOTE: PERMIT VOID AFTER 2 YEARS
- NOTE: CONTRACTOR RESPONSIBLE FOR SCHEDULING A PRE-CONSTRUCTION INSPECTION FOR ALL INSTALLATIONS
- NOTE: WATERTIGHT SEPTIC TANKS REQUIRED
- NOTE: ALL PARTS OF SEPTIC SYSTEM SHALL BE 100 FEET FROM ANY WATER WELL
- NOTE: MANHOLE RISERS REQUIRED ON ALL SEPTIC TANKS AND PUMP CHAMBERS

NEITHER THE HOWARD COUNTY COUNCIL NOR THE HEALTH DEPARTMENT IS RESPONSIBLE FOR THE SUCCESSFUL OPERATION OF ANY SYSTEM PERMITTEE RESPONSIBLE FOR OBTAINING FINAL APPROVAL ON THIS PERMIT CALL 410-313-2640 FOR INSPECTION OF SEPTIC SYSTEM

518026-B

NOT TO SCALE

HIGHLAND RD

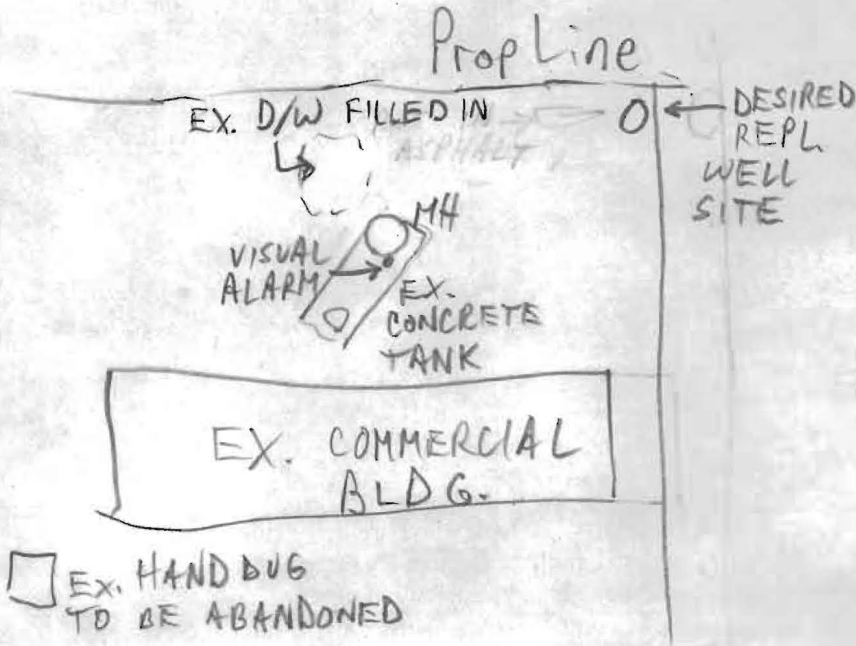

RT. 108

ROAD

TRENCH/DRAINFIELD DATA, WIDTH INLET BOTTOM

NUMBER OF TRENCHES _____
 TOTAL LENGTH _____
 ABSORPTION AREA _____
 DISTRIBUTION BOX LEVEL _____
 DISTRIBUTION BOX BAFFLE _____
 DISTRIBUTION BOX PORT _____

SEPTIC TANK DATA

SEPTIC TANK 1 LEVEL EX-OK
 CAPACITY 1000-1250 GAL
 SEAM LOC _____
 TANK LID DEPTH _____
 BAFFLES _____
 BAFFLE FILTER _____
 MANHOLE LOC _____
 6" PORT LOC _____
 WATERTIGHT TEST _____

SEPTIC TANK 2 LEVEL _____
 CAPACITY _____ GAL
 SEAM LOC _____
 TANK LID DEPTH _____
 BAFFLES _____
 BAFFLE FILTER _____
 MANHOLE LOC _____
 6" PORT LOC _____
 WATERTIGHT TEST _____

PRE-CONSTRUCTION _____

INSTALLATION 12/17/02 EX. CONCRETE TANK CONVERTED TO HOLDING TANK; TYPE/LOC

OF EX. DRAINFIELD NOT YET KNOWN TO BE CONFIRMED SOON (MR)

12/18/02 EX. D/W LOCATED, PROPERLY FILLED; FILE TO BE CLOSED

UPON COMPLETION OF H.T. AGREEMENT (MR)

12/30/02 ± H.T. AGREEMENT REC'D, OK; FILE CLOSED

FINAL INSPECTOR M. Ripkin

DATE OF APPROVAL 12/30/02