

APPLICATION

A 02519

P 02965

SEWAGE DISPOSAL TESTING

MARYLAND STATE DEPARTMENT OF HEALTH

HOWARD COUNTY

ELLICOTT CITY

DISTRICT 5

DATE 5/27/60

Please fill out in triplicate and return to this office with a check for \$10 made payable to

HOWARD COUNTY HEALTH DEPT. - SANITATION

468 sq. ft. of tile field, behind the house, brand of tile.

750 gal septic Tank in 3 bedroom house.

TO: THE COUNTY HEALTH OFFICER
ELLICOTT CITY, MARYLAND

I, HEREBY, APPLY FOR THE NECESSARY TESTS IN ORDER TO CONSTRUCT (OR RECONSTRUCT) A SEWAGE DISPOSAL SYSTEM.

PROPERTY OWNER Bruce A. & Doris E. Pierce - sold to Detweiler, Frank.

ADDRESS 10424 Edgewood Avenue, Silver Spring, Md. PHONE JUniper 8-3527

PROPERTY LOCATION:

SUBDIVISION Greenwood Farms, Inc. LOT NO. 46

ROAD AND DESCRIPTION Greenwood Avenue off Brown Bridge Road

OCCUPANT _____ PHONE _____

PERSON TO CONSTRUCT SYSTEM _____

ADDRESS _____ PHONE _____

SIZE OF LOT 180 X 250 TYPE BLDG. 2
NUMBER OF BEDROOMS

IF NOT SINGLE RESIDENCE DESCRIBE _____

SIGNATURE OF APPLICANT Bruce P. Pierce


APPROVED BY James Hennigan FOR Tile Field DATE 6-10-60
(KIND OF SYSTEM)

REJECTED BY _____ FOR _____ DATE _____
(KIND OF SYSTEM)

HOLD PENDING FURTHER TESTS _____ DATE _____

REASONS FOR REJECTION OR HOLDING _____

THIS IS NOT A PERMIT

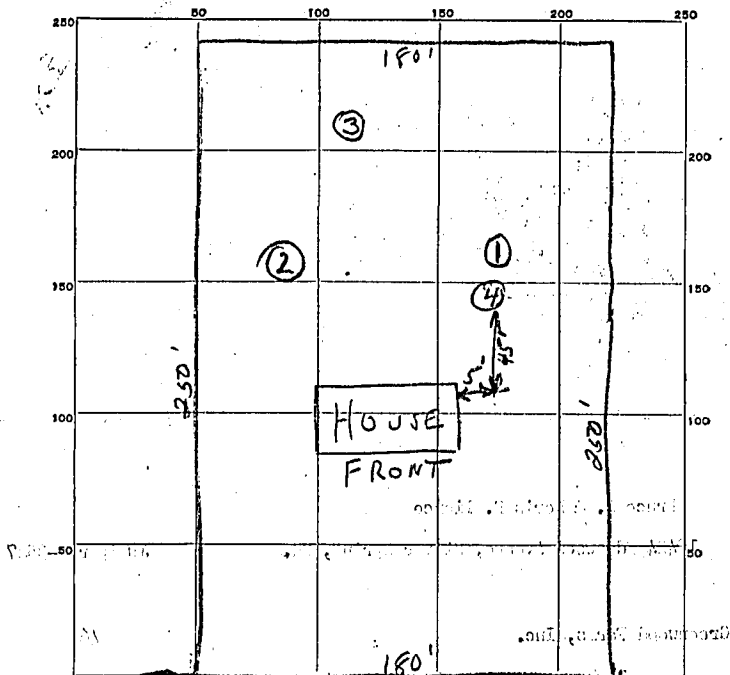

GREENWOOD DRIVE

DATE	TEST NO.	DEPTH	PRE-WET		TEST - 1" DRUP		TIME
			START	STOP	START	STOP	
6-10-60	1	3 FT	2:15	2:19	2:19	2:28	9 min
	2		2:31	2:33	2:33	2:38	5 min
	3		2:42	overtime			
9-22-60	4	9 FT	9:48	9:50	9:50	9:52	2 min

SOIL AUGER FINDING

TESTED BY

REMARKS

ALSO PRESENT

J. Hemmingway

9-22-60
 6-10-60
 Bruce R. Pierce

LOT NO. 46