

B 1 **8596** SEQUENCE NO. (OEP USE ONLY)

(THIS NUMBER IS TO BE PUNCHED IN COLS. 3-6 ON ALL CARDS)

STATE OF MARYLAND  
PERMIT TO DRILL WELL

please print or type

OEP PERMIT NUMBER  
**HO-81-1322**

fill in this form completely

Date Received

**OWNER INFORMATION**

8 **SWANN** 13 **BILL** 34  
15 Last Name Owner First Name

36 **2979 HILLTOP** 55  
Street or RFD

57 **LENDLAND** 70 State 72 **MD** 76 Zip

B 3 LOCATION OF WELL

1 2 **102200** 21  
8 COUNTY

**MAP 34 P** 42 **313**  
23 SUBDIVISION

SECTION **44** 46 LOT **2** 50

52 NEAREST TOWN **DAYTON** 71

MILES FROM TOWN (enter 0 if in town) **2.2** 73 **M I** 76 77 78

**DRILLER INFORMATION**

Driller's Name **Joseph C. Magee** 77 License No. **228** 80

Firm Name **WELL DRILLING**

Address **5512 Ridge Rd. Mt. Airy, Md. 20881**

Signature **Joseph C. Magee** Date **6/17/85**

B 4

1 2 DIRECTION OF WELL FROM TOWN (CIRCLE BOX)

11 **Highland Road** 30 NEAR WHAT ROAD

ON WHICH SIDE OF ROAD (CIRCLE APPROPRIATE BOX)

34 **270** 37 DISTANCE FROM ROAD

ENTER FT or MI **0** 38 **0** 39

NOT TO BE FILLED IN BY DRILLER HEALTH DEPARTMENT APPROVAL

B 2 WELL INFORMATION

1 2 APPROX. PUMPING RATE (GAL. PER MIN.) **5** 8 **0** 12

AVERAGE DAILY QUANTITY NEEDED (GAL. PER DAY) **500** 14 **0** 20

USE FOR WATER (CIRCLE APPROPRIATE BOX)

D HOME (SINGLE OR DOUBLE HOUSEHOLD UNIT ONLY)

F FARMING (LIVESTOCK WATERING & AGRICULTURAL IRRIGATION)

I INDUSTRIAL, COMMERCIAL, STATE AND FEDERAL GOV. OTHER (REQUIRES APPROPRIATION PERMIT)

P PUBLIC OR PRIVATE WATER COMPANY (REQUIRES APPROPRIATION PERMIT AND STATE HEALTH DEPARTMENT APPROVAL)

T TEST, OBSERVATION, MONITORING (MAY REQUIRE APPROPRIATION PERMIT)

COUNTY NAME **HOOPER** COUNTY NO. **A 18046**

OEP SIGNATURE **[Signature]** STATE HEALTH INSERT S **41**

DATE ISSUED **07/24/86**

43 NORTH GRID **49000** 48 50 SIGNATURE **[Signature]** 55 EAST GRID **0805000** 57 63 EXP. DATE

APPROXIMATE DEPTH OF WELL **200** 24 **0** 28 FEET

APPROXIMATE DIAMETER OF WELL **6** 30 **1 1/2** 34 NEAREST INCH

METHOD OF DRILLING (circle one)

BORED (or Augered)  JETTED  Jetted & DRIVEN

30-  AIR-ROTary  AIR-PERCussion  ROTARY (Hydraulic Rotary)

37  CABLE  REVerse-ROTary  DRive-POINT

other \_\_\_\_\_

SHOW MAJOR FEATURES OF BOX & LOCATE WELL WITH AN X

SOURCES OF DRILLING WATER

1. **FX**

2. **well**

3. **copy sent downtown 7/88**

WRITE THE BOX NUMBER FROM THE MAP HERE

E **8045**

N **4909** ← 000 000

REPLACEMENT OR DEEPEMED WELLS (CIRCLE APPROPRIATE BOX)

N THIS WELL WILL NOT REPLACE AN EXISTING WELL

Y THIS WELL WILL REPLACE A WELL THAT WILL BE ABANDONED AND SEALED

39  S THIS WELL WILL REPLACE A WELL THAT WILL BE USED AS A STANDBY

D THIS WELL WILL DEEPEM AN EXISTING WELL

PERMIT NUMBER OF WELL TO BE REPLACED OR DEEPEMED (IF AVAILABLE) 41 \_\_\_\_\_ 52

DRAW A SKETCH BELOW SHOWING LOCATION OF WELL IN RELATION TO NEARBY TOWNS AND ROADS AND GIVE DISTANCE FROM WELL TO NEAREST ROAD JUNCTION

N ↑


**Sketch:** A hand-drawn map showing a well location relative to roads and towns. Labels include "Nichols Drive", "Brighton", and "300'". A north arrow is present.

Not to be filled in by driller (OEP USE ONLY)

APPROP. PERMIT NUMBER \_\_\_\_\_ 54 **G A P** 63

FORCE **[Signature]** WRITE INITIALS IN BOX 67 68 PERMIT No. **HO-81-1322** 70 71 72 73 74 75 76 77 78 79

24 inch dia  
Hickory Tree

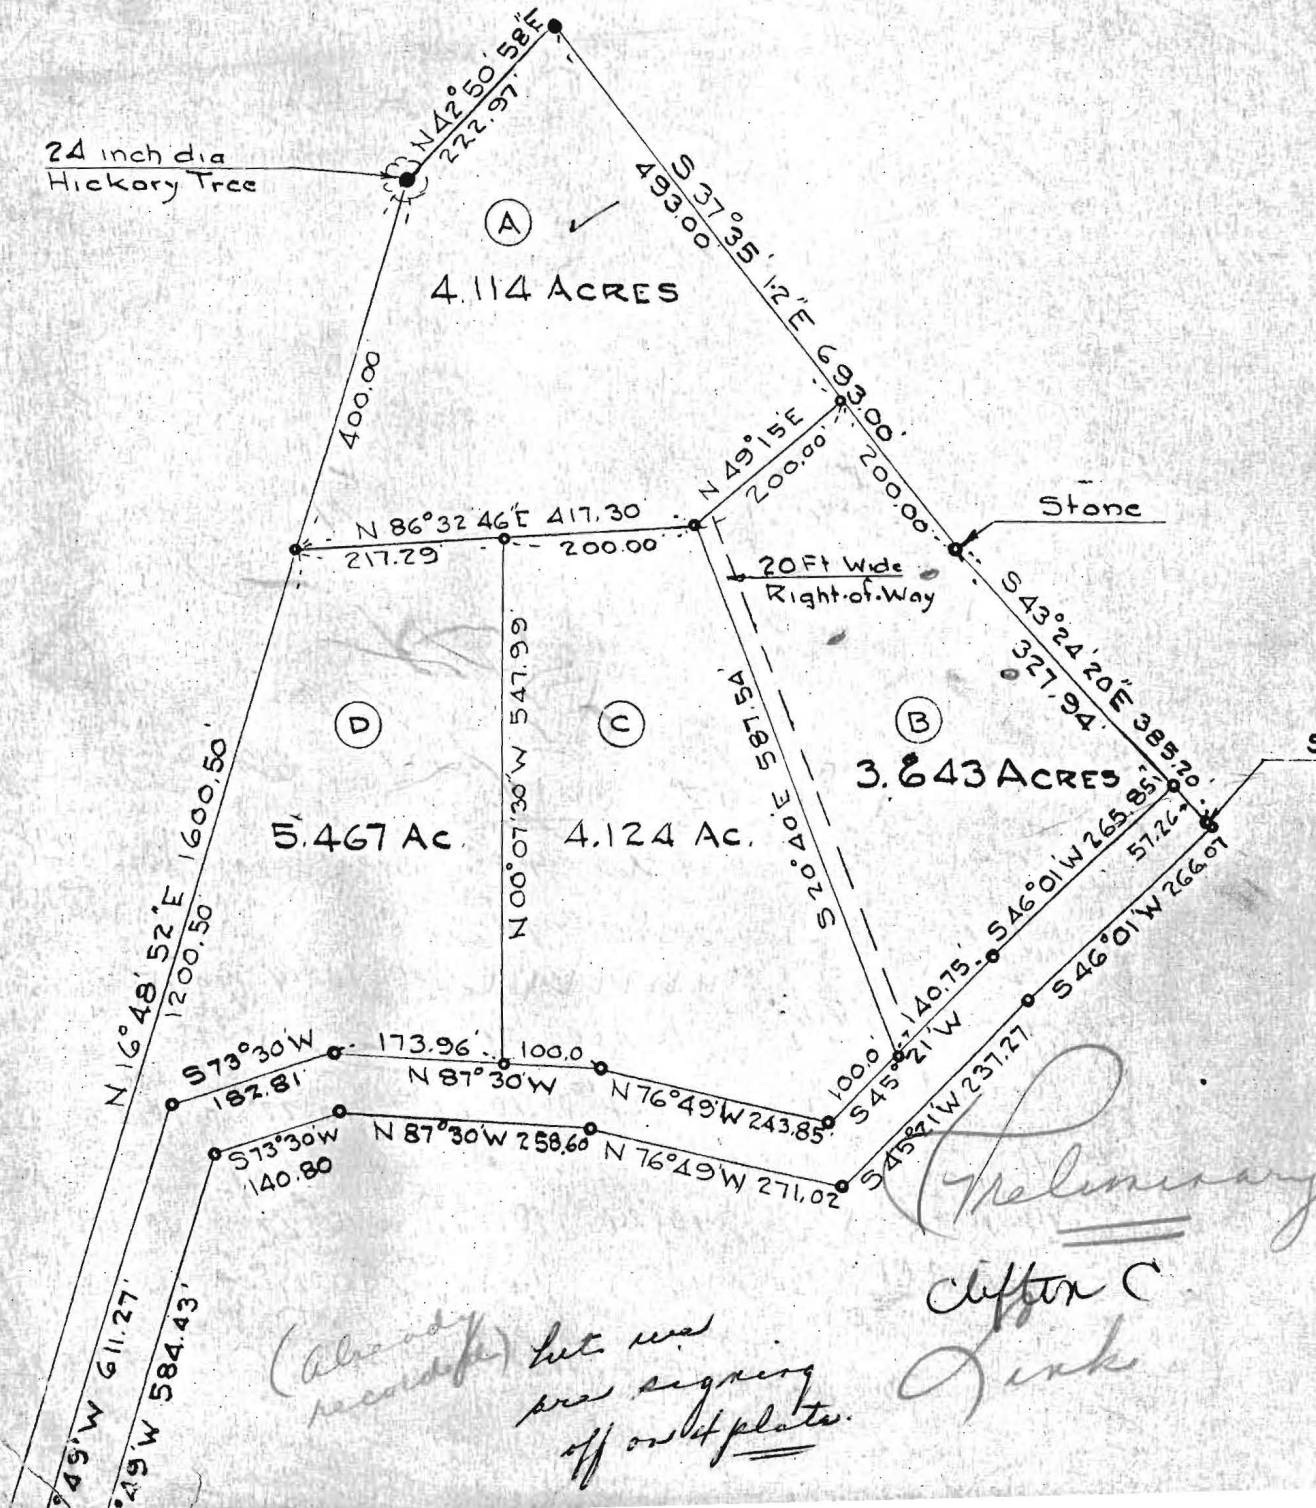

11/12/75

FURTHER TESTS - LOT  
WUZ W DOWN

9  
3+  
9:56 9:58 9:58 10:03

(5)

9-A

8 1/2

2000

2400

~~10:14 10:15 10:15 10:17~~

(2)

10-A

7 1/2

1000

3500

10:21<sup>40</sup> 10:22<sup>50</sup> 10:22<sup>50</sup> 10:25

10-A Refsd

7 1/2

11

11-A

8 1/2

10:27

10:27<sup>25</sup>

10:27<sup>25</sup>

10:28

3500

11-A Refsd

8 1/2

10:28

10:28<sup>15</sup>

10:28<sup>15</sup>

10:28<sup>45</sup>

3000