

# APPLICATION

10/25/79  
1:30 P.M.

SEWAGE DISPOSAL TESTING

A 30375

STATE OF MARYLAND - DEPARTMENT OF HEALTH AND MENTAL HYGIENE

P \_\_\_\_\_

HOWARD COUNTY HEALTH DEPARTMENT  
ENVIRONMENTAL HEALTH SERVICES  
P.O. BOX 476 ELLICOTT, MARYLAND 21043  
TELEPHONE: 992-2330

DISTRICT 4th

DATE 11/20/79  
~~10/19/79~~

TO: THE COUNTY HEALTH OFFICER  
ELLICOTT CITY, MARYLAND

I, HEREBY, APPLY FOR THE NECESSARY TEST IN ORDER TO CONSTRUCT (OR RECONSTRUCT) A SEWAGE DISPOSAL SYSTEM.

PROPERTY OWNER Dorothy Hackett

ADDRESS \_\_\_\_\_ PHONE DonCameron Co. 563-4381

PROPERTY LOCATION:

SUBDIVISION \_\_\_\_\_ LOT NO. \_\_\_\_\_

ROAD AND DESCRIPTION Bushy Park Road

SIZE OF LOT \_\_\_\_\_ TYPE BLDG. 3 or 4 bedrooms

THE SYSTEM INSTALLED UNDER THIS APPLICATION IS ACCEPTABLE ONLY UNTIL PUBLIC FACILITIES BECOME AVAILABLE.

I FULLY UNDERSTAND THE FEE CONNECTED WITH THE FILING OF THIS PERC TEST APPLICATION IS NON-REFUNDABLE UNDER

ANY CIRCUMSTANCES.

SIGNATURE OF APPLICANT Don Cameron Co.

APPROVED BY R. De Marco & DWM. FOR DRYWELL-5'x11' DATE 10/26/79  
& TRENCH



REJECTED BY \_\_\_\_\_ FOR \_\_\_\_\_ DATE \_\_\_\_\_

HOLD PENDING FURTHER TESTS \_\_\_\_\_ DATE \_\_\_\_\_

REASONS FOR REJECTION OR HOLDING \_\_\_\_\_

# THIS IS NOT A PERMIT

11/3

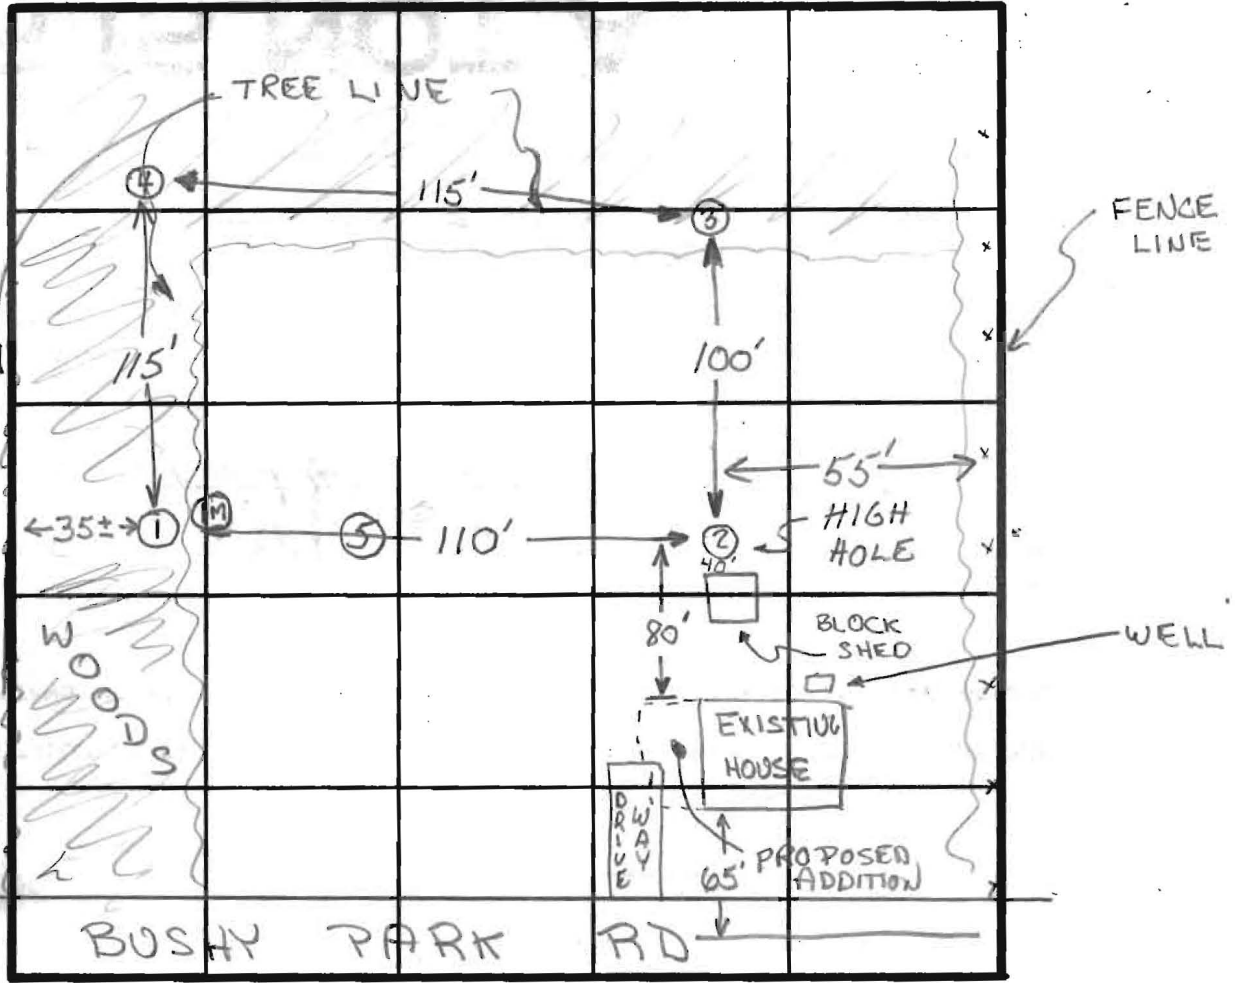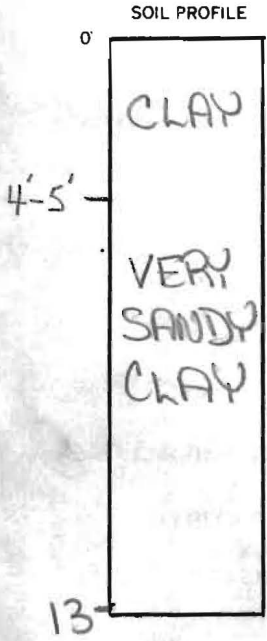

INDICATE NORTH - NAME ADJOINING ROADWAY AS BASE LINE.

DATE	TEST NO.	DEPTH	PRE-WET		TEST - 1" DROP		TIME
			START	STOP	START	STOP	
10/25/79	1S	3'	1:47	FAILED 1ST INCH			
	10	13'	1:45	1:49	1:49	1:55	6
	2S	4 1/2'	2:05	2:09	2:09	2:16	7
	2D	13'	2:05	2:10	2:10	2:20	10
	1M	5'	3:25	3:37	3:37	3:58	21
	3	13'	VISUAL SIMILAR TO #1				✓
	4S	4 1/2'	2:38	2:44	2:44	2:48	4
	4D	13'	2:37	2:42	2:42	2:48	6
	5	5'	VISUAL CLAY TO 4-4 1/2'				✓

SEWAGE PRESENTLY RUNNING OUT ON GROUND. OLD DRILLED WELL APPROX 73' DEEP.

REMARKS ARRIVED 1110, NO HOLES DUG.

TYPE OF SOIL #1 CLAY TO 5 1/2'

TESTED BY R.D. & J.S. ALSO PRESENT KEN SCHLISLER