

C 1 2848
SEQUENCE NO. (WRA USE ONLY)
1 2 3 4 5 6 (SEQ. NO.)
7 8 9 10 11 12 (THIS NUMBER IS TO BE PUNCHED IN COLS. 3-6 ON ALL CARDS)

STATE OF MARYLAND
WATER RESOURCES ADMINISTRATION
TAWES STATE OFFICE BLDG., ANNAPOLIS, MD. 21401
WELL COMPLETION REPORT

THIS REPORT MUST BE SUBMITTED WITHIN 30 DAYS AFTER WELL COMPLETION
FILL IN THIS FORM COMPLETELY
COUNTY NUMBER A18093

DATE RECEIVED (WRA USE ONLY) 3/28/78
DATE WELL COMPLETED 3/28/78

DEPTH OF WELL 160
22 (TO NEAREST FOOT) 26

PERMIT NO. FROM "PERMIT TO DRILL WELL" 11-277-447
28 29 30 31 32 33 34 35 36 37
DRILLER'S IDENTIFICATION NO. 40

OWNER MUS SAUNDERS LAWRENCE W.
STREET OR RFD 8204 COATS BRIDGE RT. POST OFFICE LEVERN, MD. 21144

WELL LOG STATE THE KIND OF FORMATIONS PENETRATED, THEIR COLOR, DEPTH, THICKNESS AND IF WATER BEARING	FEET		CHECK IF WATER BEARING
	FROM	TO	
TOP SOIL	0	2	
CLAY	2	5	
SHALE	5	12	
BROWN SLATE	12	40	
BLUE SLATE	40	72	
BROWN SLATE	72	78	✓
BLUE SLATE	78	15	
BROWN SLATE	95	17	✓
BLUE SLATE	97	160	

GROUTING RECORD
WELL HAS BEEN GROUTED (CIRCLE APPROPRIATE BOX) YES (Y) NO (N)
TYPE OF GROUTING MATERIAL (CIRCLE BOX) CEMENT (CM) BENTONITE CLAY (BC)
NO. OF BAGS 12 NO. OF POUNDS 4200
GALLONS OF WATER 160
DEPTH OF GROUT SEAL (TO NEAREST FOOT) FROM 0 FT. TO 43 FT.
ENTER 0 IF FROM SURFACE

CASING RECORD
CASING TYPES (INSERT APPROPRIATE CODE BELOW) STEEL (S) CONCRETE (C) PLASTIC (P) OTHER (O)
MAIN CASING TYPE (S) NOMINAL DIAMETER TOP (MAIN) CASING (NEAREST INCH) 16 TOTAL DEPTH OF MAIN CASING (NEAREST FOOT) 46

OTHER CASING (IF USED)
DIAMETER (INCH) DEPTH (FEET) FROM TO

SCREEN RECORD
SCREEN TYPE OR OPEN HOLE (INSERT APPROPRIATE CODE BELOW) STEEL (ST) BRASS (BR) OPEN HOLE (HO) PLASTIC (PL) OTHER (OT)

SCREEN
EACH SCREEN (CIRCLE APPROPRIATE BOX) H O
1 2 3 (SEQ. NO.) 5 DEPTH (NEAREST WHOLE FOOT) FROM TO
1 H O 44 15 17 21
2 23 24 28 30 32 36
3 38 39 41 48 47 51
SLOT SIZE 1. 2. 3.


DIAMETER OF SCREEN (NEAREST INCH) FROM TO

GRAVEL PACK (IF WELL DRILLED WAS A FLOWING WELL CIRCLE BOX) F

WRA USE ONLY (NOT TO BE FILLED IN BY DRILLER) TELESCOPE CASING LOG INDICATOR OTHER DATA AVAILABLE

PUMPING TEST
HOURS PUMPED (TO NEAREST HOUR) 2
PUMPING RATE (GALLONS PER MINUTE TO NEAREST GALLON) 10
METHOD USED TO MEASURE PUMPING RATE BUCKET
WATER LEVEL (DISTANCE FROM LAND SURFACE) BEFORE PUMPING 50 (NEAREST FOOT) WHEN PUMPING 160 (NEAREST FOOT)
TYPE OF PUMP USED (CIRCLE APPROPRIATE BOX) (FOR PUMPING TEST) AIR (A) PISTON (P) TURBINE (T) CENTRIFUGAL (C) ROTARY (R) OTHER (DESCRIBE BELOW) JET (J) SUBMERSIBLE (S)


PUMP INSTALLED
TYPE OF PUMP (WRITE APPROPRIATE LETTER IN BOX - SEE ABOVE: A, C, J, P, R, S, T, O)
DRILLER WILL INSTALL PUMP (CIRCLE APPROPRIATE BOX) YES (Y) NO (N)
CAPACITY: GALLONS PER MINUTE (TO NEAREST GALLON) 31 38
PUMP HORSE POWER 37 41
PUMP COLUMN LENGTH (NEAREST FOOT) 43 47
CASING HEIGHT (CIRCLE APPROPRIATE BOX AND ENTER CASING HEIGHT) ABOVE (A) BELOW (B) LAND SURFACE 2 (NEAREST FOOT)

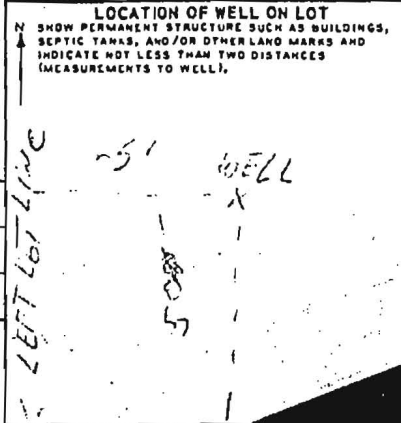

CIRCLE APPROPRIATE BOXES
A WELL WAS ABANDONED AND SEALED WHEN THIS WELL WAS COMPLETED
E ELECTRIC LOG OBTAINED
P TEST WELL CONVERTED TO PRODUCTION WELL
I HEREBY CERTIFY THAT I HAVE COMPLIED WITH ALL CONDITIONS STATED ON THE ABOVE-CAPTIONED "PERMIT TO DRILL WELL", AND THAT INFORMATION CONTAINED IN THIS REPORT IS TRUE, ACCURATE, AND COMPLETE, TO THE BEST OF MY KNOWLEDGE, INFORMATION, AND BELIEF.
DRILLER'S NAME George F. Fasteedon
SIGNATURE George F. Fasteedon


A18093

System to be on High Side

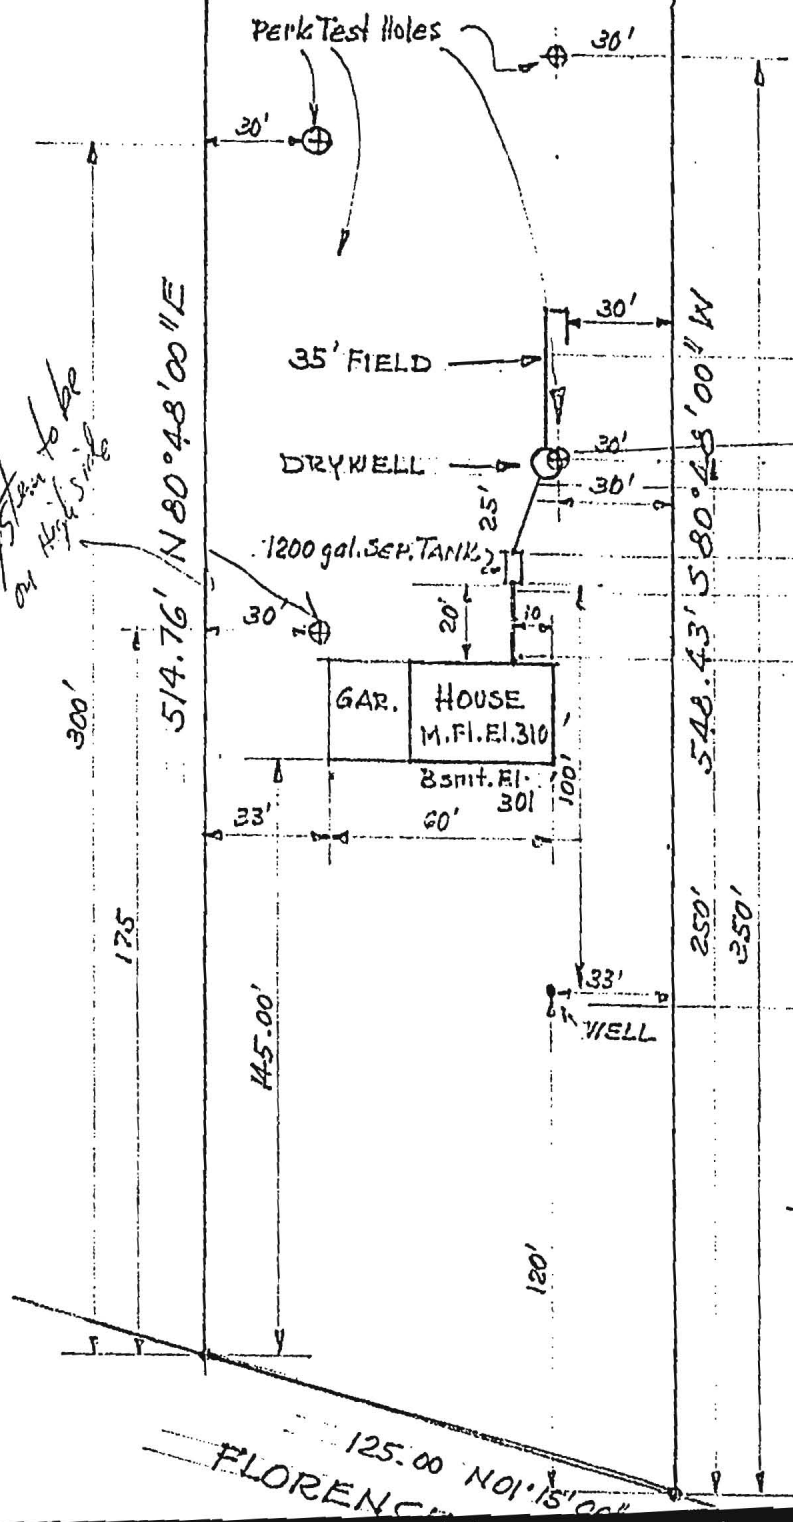

- EL 294.1' OF Field
- EXIST. EL 298.5'
- INV. EL 295'
- EXIST. EL 299'
- INV. EL 296.5'
- INV. EL 297'

~~11/13/76~~
~~...~~

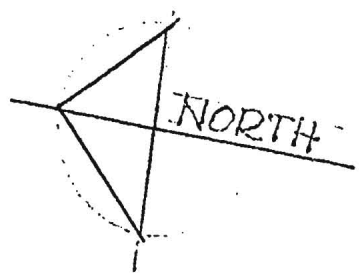

125.00 N 01° 15' 00"
FLORENCE