
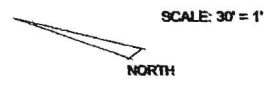


# SKETCH/AREA TABLE ADDENDUM

SUBJECT

Property Address	1231 FLORENCE ROAD		
City	MOUNT AIRY	County	HOWARD
		State	MD
Borrower			
Lender/Client	WILLIAM MUSGROVE	301-8317356	
Appraiser Name			

BOO 153044  
 8/3/05  
 Repose Pole from OK  
 (KDE)

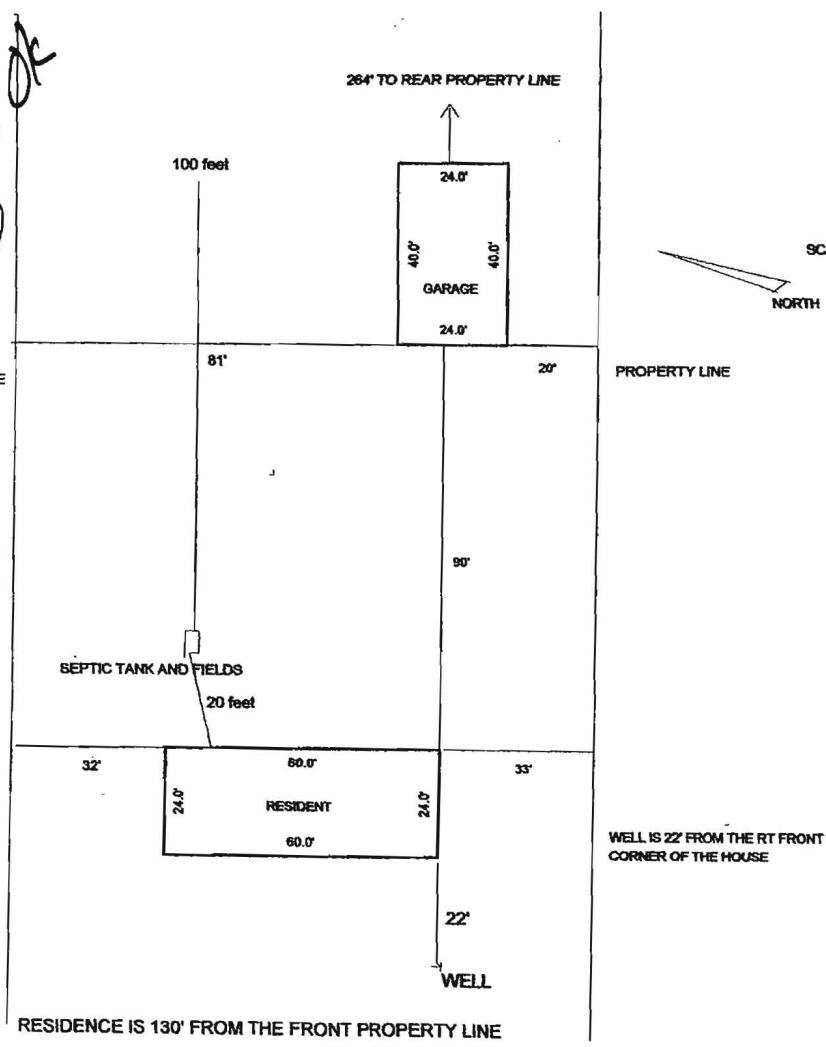

IMPROVEMENTS SKETCH