

# APPLICATION

A 18093

## SEWAGE DISPOSAL TESTING

P \_\_\_\_\_

STATE OF MARYLAND - DEPARTMENT OF HEALTH AND MENTAL HYGIENE

HOWARD COUNTY HEALTH DEPARTMENT  
ENVIRONMENTAL HEALTH SERVICES  
P. O. BOX 476, ELLICOTT CITY, MARYLAND 21043  
TELEPHONE: 465-8000, EXT. 358

DISTRICT 4th

DATE 3/16/73

TO: THE COUNTY HEALTH OFFICER  
ELLICOTT CITY, MARYLAND

I, HEREBY, APPLY FOR THE NECESSARY TEST IN ORDER TO CONSTRUCT (OR RECONSTRUCT) A SEWAGE DISPOSAL SYSTEM.

(Contract Purchaser - Lawrence A. Musgrove  
2105 Arcola Avenue, Wheaton, Md.  
Phone: 946-6947)

PROPERTY OWNER C. P. Musgrove

Any questions call Mrs. Allnutt,  
PHONE 988-9302

ADDRESS \_\_\_\_\_

PROPERTY LOCATION:

SUBDIVISION (Chestnut Estates) LOT NO. Parcel L

ROAD AND DESCRIPTION Long Corner Road

SIZE OF LOT 5.018 acres 1.5000 TYPE BLDG. 3 or 4 bedrooms

NUMBER OF BEDROOMS

IF NOT SINGLE RESIDENCE DESCRIBE \_\_\_\_\_

THE SYSTEM INSTALLED UNDER THIS APPLICATION IS ACCEPTABLE ONLY UNTIL PUBLIC FACILITIES BECOME AVAILABLE.

SIGNATURE OF APPLICANT ix /s/ Margaret Allnutt

APPROVED BY \_\_\_\_\_ FOR \_\_\_\_\_ DATE \_\_\_\_\_

(KIND OF SYSTEM)

REJECTED BY \_\_\_\_\_ FOR \_\_\_\_\_ DATE \_\_\_\_\_

(KIND OF SYSTEM)

HOLD PENDING FURTHER TESTS \_\_\_\_\_ DATE \_\_\_\_\_

REASONS FOR REJECTION OR HOLDING \_\_\_\_\_

# THIS IS NOT A PERMIT



Flat of Survey  
 PARCEL X  
 Being Part of a Tract of Land Called  
 CHESTNUT HILLS  
 Fourth District  
 Howard County Maryland  
 Scale: 1"=100'


A8093

I Hereby certify that the plan shown hereon is correct and that the lot shown hereon complies with minimum ownership, width and lot area as required by the Maryland State Department of Health Regulations.

RENN SURVEYS  
 BOX 55  
 DAMASCUS, Md.  
 Ph. 948-8822

*Elwood L. Renn*

Elwood L. Renn  
 R.P.L.S. Md. #3383  
 May 21, 1973

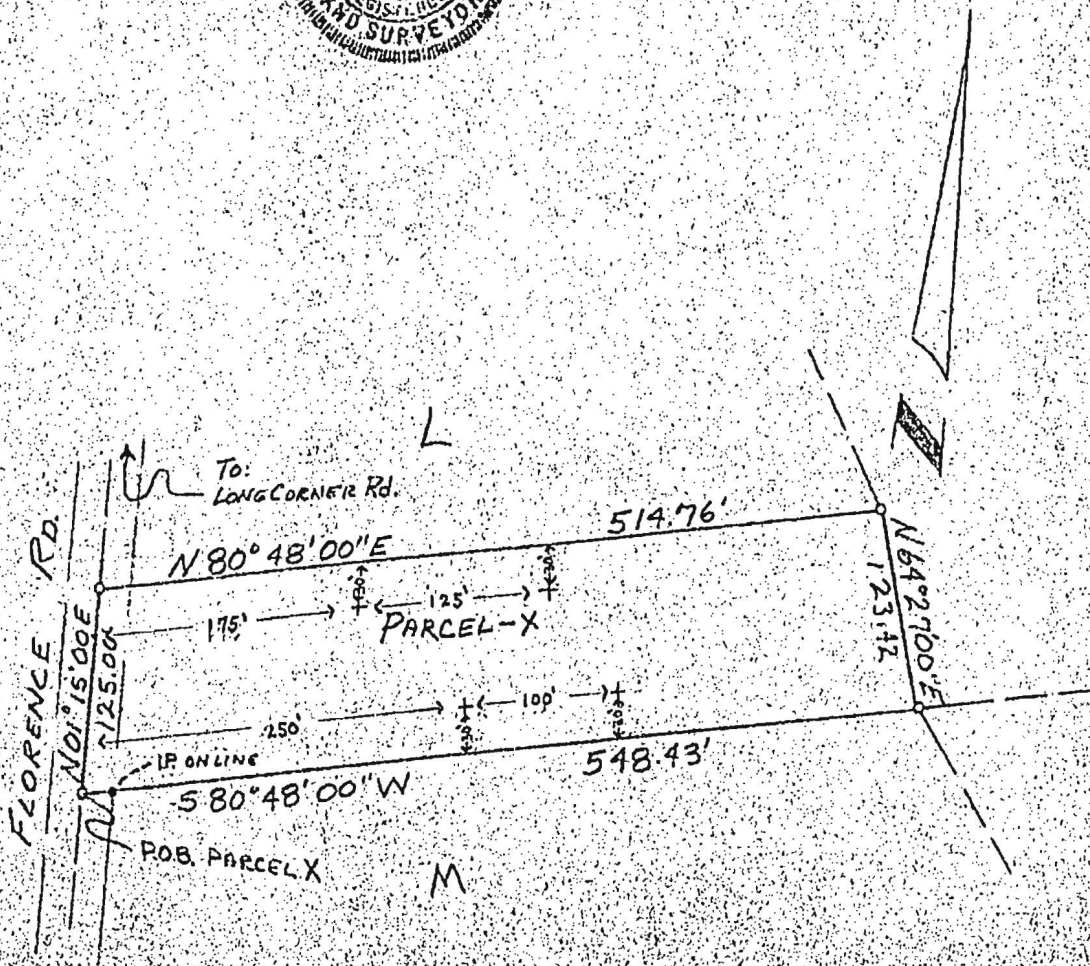

*Musgrave Son - Wm. Musgrave*