

2/21/75
if possible
p.m.

21057
18175

PERMIT

SEWAGE DISPOSAL SYSTEM

MARYLAND STATE DEPARTMENT OF HEALTH

HOWARD COUNTY

ELLICOTT CITY

DISTRICT 3

INDEXED

DATE 12/27/74

Emerson Pease

IS PERMITTED TO INSTALL 8" ALTER

ADDRESS Old Frederick Road, Woodstock, Maryland

PHONE 326-2481

A SEWAGE DISPOSAL SYSTEM LOCATED AT

SUBDIVISION Mt. Hebron

ROAD Furrow Drive

LOT 6, Blk. B, Sec. 14

PROPERTY OWNER Mt. Hebron, Inc.

ADDRESS

SPECIFICATIONS - 3 bedrooms

DRAIN FIELD DEPTH FEET. BOTTOM AREA SQ. FT.

SEEPAGE PITS ABSORBENT SIDE-WALL AREA SQ. FT.

SEPTIC TANK CAPACITY 1,000 GALLONS

FOR GARBAGE GRINDER, INCREASE DISPOSAL AREA 22% & TANK CAPACITY 50%

OTHER Drain Fields - 360 sq. ft. bottom area installed at a depth of 3 ft. below original grade. Use 2 to 3 ft. of gravel under pipe. CALL FOR INSPECTION OF TRENCHES BEFORE GRAVEL IS INSTALLED.

Place drain fields in area between 39 ft. and 166 ft. from front lot line and between 21 ft. and 117 ft. from left side line as seen when facing lot from the front.

NOTE: ALL PIPE FROM HOUSE TO DISPOSAL AREA MUST BE CAST IRON.

PERMIT VOID AFTER THREE YEARS.

NOTE: INSTALL STAND PIPES ON SEPTIC TANK. STAND PIPE MUST BE 6" IN DIA. - CAST IRON, CONCRETE OR TERRA COTTA ACCEPTED.

PLANS APPROVED BY D. W. Monaghan


DATE 10/14/74

FILL SEPTIC TANK AND DISTRIBUTION BOX WITH WATER BEFORE CALLING FOR AN INSPECTION. COVER RO WORK UNTIL INSPECTED AND APPROVED.

NEITHER THE HOWARD COUNTY COMMISSIONERS NOR THE HEALTH DEPARTMENT IS RESPONSIBLE FOR THE SUCCESSFUL OPERATION OF ANY SYSTEM.

18175

LOCATION:
 27' FROM
 100' PROPERTY LINE
 36' FROM ALLIANCE
 FIRE INSURANCE
 LINE
 41' FROM LEFT
 PROPERTY LINE

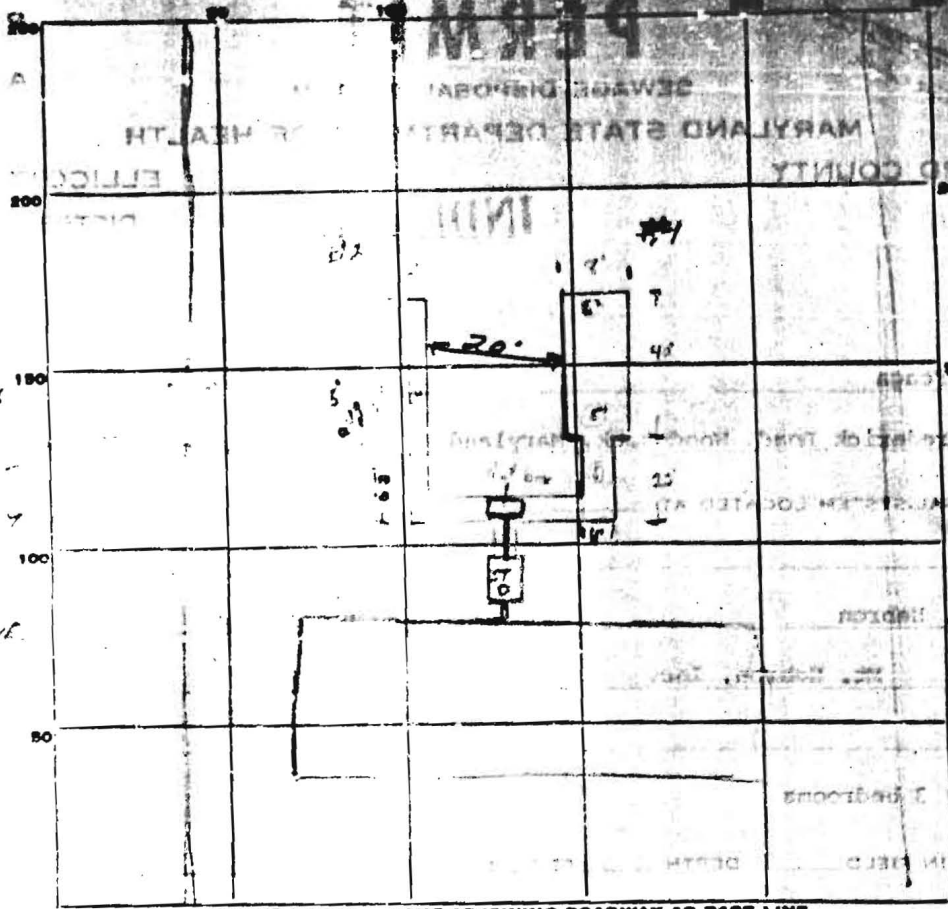

INDICATE NORTH. - NAME ADJOINING ROADWAY AS BASE LINE.

PERMIT CARD OK

SEPTIC TANK, LEVEL YES CLEANUP'S OK S.T.

DISTRIBUTION BOX, LEVEL YES

TILE FIELD, DEPTH 5 FT. TRENCH WIDTH (14+7) 2 FT.

GRAVEL DEPTH 3 FT TOTAL LENGTH 65 FT.

NUMBER OF TRENCHES 2 TOTAL BOTTOM AREA 510

SEEPAGE PITS, INSIDE DIAMETER N/A FT. DEPTH BELOW INLET N/A FT.

ABSORBENT AREA 290 SQ. FT.

REMARKS 2-20-75 4:00 pm D.A.M.

OK to Cover 1/2 2-21-75

DATE SYSTEM APPROVED 2-2-75 INSPECTOR H. S. Zhan