

VISUAL HOLE 2/12/03 1PM
FINAL 2/13/03 12-1

PUB. SEWER STATUS VERIFIED BY _____

ISSUE DATE: 02/12/03

APPROVAL DATE: 2/13/03

PERMIT INDEXED

P 518545

A REPAIR

ON-SITE SEWAGE DISPOSAL SYSTEM HOWARD COUNTY HEALTH DEPARTMENT BUREAU OF ENVIRONMENTAL HEALTH

04-322045

Hatfield's Equipment IS PERMITTED TO INSTALL ALTER

ADDRESS: 13785 Burntwoods Rd, Glenelg PHONE NUMBER: 301-854-6172

SUBDIVISION: Warfield Estates LOT NUMBER: 28, Bl A

ADDRESS: 3321 Campaigne Court PROPERTY OWNER: Helen Benoliel

SEPTIC TANK CAPACITY (GALLONS): 1250

PUMP CHAMBER CAPACITY (GALLONS): _____

NUMBER OF BEDROOMS: 4

SQUARE FEET PER BEDROOM: 180

LINEAR FEET OF TRENCH REQUIRED: 110'

TRENCHES:	Trench to be <u>2</u> feet wide. Inlet <u>6</u> feet below original grade. Bottom maximum depth <u>11</u> feet below original grade. Effective area begins at <u>6</u> feet below original grade. <u>5</u> feet of stone below distribution pipe. <u>10' CENTER TO CENTER ON TRENCHES</u>
LOCATION:	
PURPOSE:	Existing septic system has failed. Call for inspection when ground is opened so sanitarian can recommend repair.

PLANS APPROVED: [Signature] DATE: 2/12/03

- NOTE: PERMIT VOID AFTER 2 YEARS
- NOTE: CONTRACTOR RESPONSIBLE FOR SCHEDULING A PRE-CONSTRUCTION INSPECTION FOR ALL INSTALLATIONS
- NOTE: WATERTIGHT SEPTIC TANKS REQUIRED
- NOTE: ALL PARTS OF SEPTIC SYSTEM SHALL BE 100 FEET FROM ANY WATER WELL
- NOTE: MANHOLE RISERS REQUIRED ON ALL SEPTIC TANKS AND PUMP CHAMBERS


NEITHER THE HOWARD COUNTY COUNCIL NOR THE HEALTH DEPARTMENT IS RESPONSIBLE FOR THE SUCCESSFUL OPERATION OF ANY SYSTEM PERMITTEE RESPONSIBLE FOR OBTAINING FINAL APPROVAL ON THIS PERMIT CALL 410-313-2640 FOR INSPECTION OF SEPTIC SYSTEM

P 518345

2/12/03

NOT TO SCALE

INDEXED

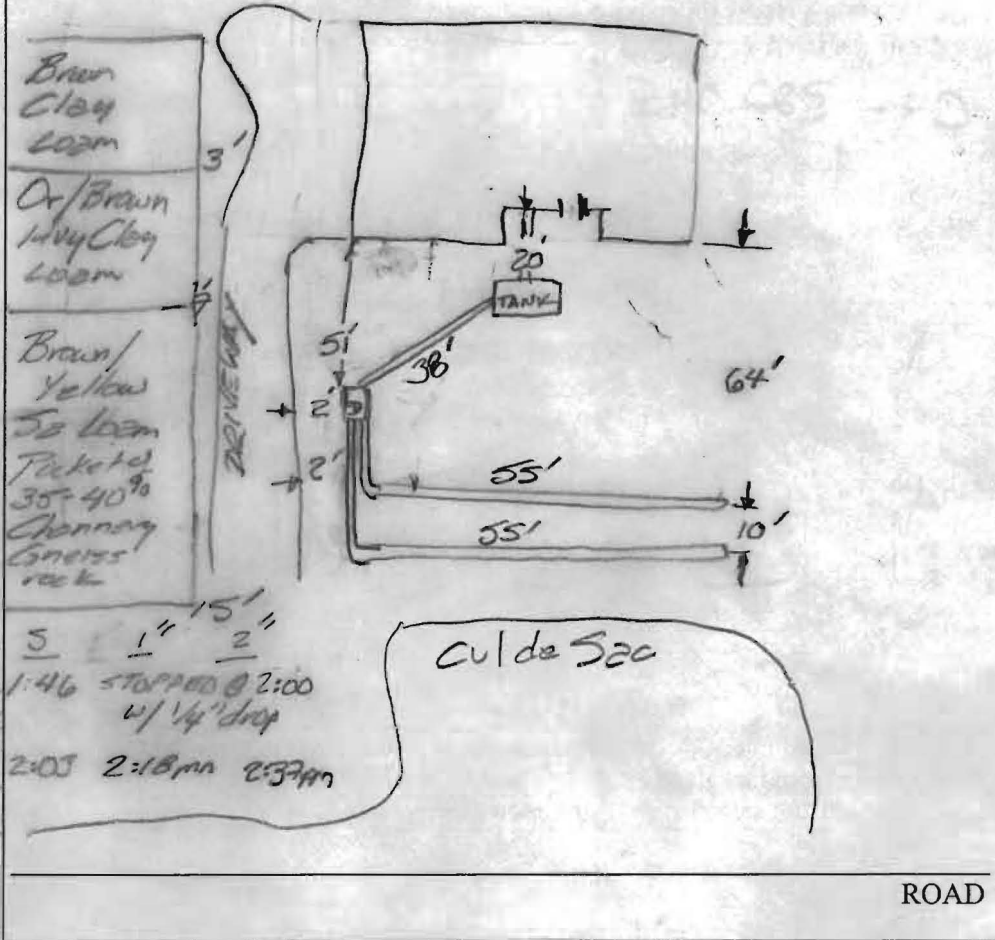

TRENCH/DRAINFIELD DATA		
WIDTH	INLET	BOTTOM
2'	6'	11"
NUMBER OF TRENCHES		2
TOTAL LENGTH		110
ABSORPTION AREA		550 sq ft
DISTRIBUTION BOX LEVEL		40
DISTRIBUTION BOX BAFFLE		✓
DISTRIBUTION BOX PORT		—

SEPTIC TANK DATA	
SEPTIC TANK 1 LEVEL	
CAPACITY	EXISTING 1200 GAL
SEAM LOC	MID
TANK LID DEPTH	1'
BAFFLES	1/2 S
BAFFLE FILTER	—
MANHOLE LOC	—
6" PORT LOC	—
WATERTIGHT TEST	—
SEPTIC TANK 2 LEVEL	
CAPACITY	— GAL
SEAM LOC	—
TANK LID DEPTH	—
BAFFLES	N/A
BAFFLE FILTER	N/A
MANHOLE LOC	—
6" PORT LOC	—
WATERTIGHT TEST	—

PRE-CONSTRUCTION _____

2/12/03

INSTALLATION 11' bottom on trench w/ 6" invert; Trenches (2) 55' long spaced 10' center-to-center (FA); 2/13/03 Verified all dimensions on installation. Allowed to cover box & trenches. (FA)

FINAL INSPECTOR _____

[Signature]

DATE OF APPROVAL _____

2/13/03