

LAYOUT _____ INSP 4 _____

INSP 2 _____ INSP 5 _____

INSP 3 _____ INSP 6 _____

ISSUE DATE: 2/14/78

P 27551

APPROVAL DATE: _____

A _____

PERMIT INDEXED

ON-SITE SEWAGE DISPOSAL SYSTEM HOWARD COUNTY HEALTH DEPARTMENT BUREAU OF ENVIRONMENTAL HEALTH

Jack Fyock IS PERMITTED TO INSTALL ALTER

ADDRESS: Glenelg, MD PHONE NUMBER: _____

SUBDIVISION: Warfield Estates LOT NUMBER: 28, Bl A

ADDRESS: 3321 Campaigne Court PROPERTY OWNER: Charles Spiegelman

SEPTIC TANK CAPACITY (GALLONS): _____ OUTLET BAFFLE FILTER REQUIRED

PUMP CHAMBER CAPACITY (GALLONS): _____ COMPARTMENTED TANK REQUIRED

NUMBER OF BEDROOMS: 1

SQUARE FEET PER BEDROOM: _____

LINEAR FEET OF TRENCH REQUIRED: _____

TRENCHES:	Trench to be _____ feet wide. Inlet _____ feet below original grade. Bottom maximum depth _____ feet below original grade. Effective area begins at _____ feet below original grade. _____ feet of stone below distribution pipe.
LOCATION:	BUILDING PERMIT SIGNED AND RETURNED
NOTES: <u>5/6/99</u>	<u>B00117754 INGROUND POOL</u>

PLANS APPROVED: _____ DATE: _____

NOTE: PERMIT VOID AFTER 2 YEARS

NOTE: CONTRACTOR RESPONSIBLE FOR SCHEDULING A PRE-CONSTRUCTION INSPECTION FOR ALL INSTALLATIONS

NOTE: WATERTIGHT SEPTIC TANKS REQUIRED

NOTE: ALL PARTS OF SEPTIC SYSTEM SHALL BE 100 FEET FROM ANY WATER WELL

NOTE: MANHOLE RISERS REQUIRED ON ALL SEPTIC TANKS AND PUMP CHAMBERS UNLESS SPECIFICALLY AUTHORIZED

**NEITHER THE HOWARD COUNTY COUNCIL NOR THE HEALTH DEPARTMENT IS
RESPONSIBLE FOR THE SUCCESSFUL OPERATION OF ANY SYSTEM
PERMITTEE RESPONSIBLE FOR OBTAINING FINAL APPROVAL ON THIS PERMIT
CALL 410-313-2640 FOR INSPECTION OF SEPTIC SYSTEM**

P
27551

12/22/78
perfect copy
em

PERMIT

SEWAGE DISPOSAL SYSTEM

MARYLAND STATE DEPARTMENT OF HEALTH

27551

A 1499

HOWARD COUNTY

ELLCOTT CITY

DISTRICT 42

INDEXED

DATE 2/14/78

Jack Fung IS PERMITTED TO INSTALL X ALTER

ADDRESS Glenns, Md. PHONE _____

SUBDIVISION Marfield Estates 3371 ROAD Campaigne Court LOT 208, Sec. 3

PROPERTY OWNER Marie Hill Park Assoc. BENOLIEL

ADDRESS Seabrook, Md.

SPECIFICATIONS 4 bedrooms

SEPTIC TANK CAPACITY 1250 GALLONS

DRAIN FIELD _____ DEPTH _____ FEET. BOTTOM AREA _____ SQ. FT.

DEEP TRENCH _____ DEPTH _____ FEET. BOTTOM AREA _____ SQ. FT.

BEEPAGE PITS _____ ABSORBENT SIDE-WALL AREA 120 SQ. FT. PER BEDROOM

INLET PIPE 4 1/2 FT. BELOW ORIGINAL GRADE. MAXIMUM DEPTH 11 FT. BELOW ORIGINAL GRADE

EFFECTIVE DEPTH AT _____ FT. BELOW ORIGINAL GRADE.

LOCATE DISPOSAL AREA 110 FT. FROM EXORT LOT LINE AND 70 FT. FROM 1st LOT LINE AS SEEN WHEN

FACING LOT FROM Campaigne Court.

75
x 6.5
375
487.5

967

12-20-78. OK for trench 75 ft long - 11' deep - 6" top stone - off concrete on
on 1st. - follow contour of ground - trench to be completed before
gravel is installed DWM

PLANS APPROVED BY T. Wright DATE 12/2/69

COVER NO WORK UNTIL INSPECTED AND APPROVED.

NEITHER THE HOWARD COUNTY COUNCIL NOR THE HEALTH DEPARTMENT IS RESPONSIBLE FOR THE SUCCESSFUL OPERATION OF ANY SYSTEM.

NOTE: IF TRENCH IS USED CALL FOR INSPECTION BEFORE PLACING GRAVEL IN TRENCH.

NOTE: NO DRY WELL SHALL EXCEED 15 FOOT IN DIAMETER.

NOTE: ALL PIPE FROM HOUSE TO DISPOSAL AREA MUST BE CAST IRON.

PERMIT VOID AFTER THREE YEARS.

NOTE: INSTALL STAND PIPE ON SEPTIC TANK AND DRY WELL. STAND PIPES MUST BE SIZES BY DIAMETER. CAST IRON, CONCRETE OR TERRA

COTTA ACCEPTED

ORIGINAL PERMIT SIGNED

AND RETURNED 5-6-99

Serial # B1117754
Howard PD

14969


27551

*INSTALLER IS RESPONSIBLE FOR OBTAINING FINAL APPROVAL ON THIS PERMIT.

HO - 23

Need letter from owner stating this is
a 3 bedroom house

DATE SYSTEM APPROVED

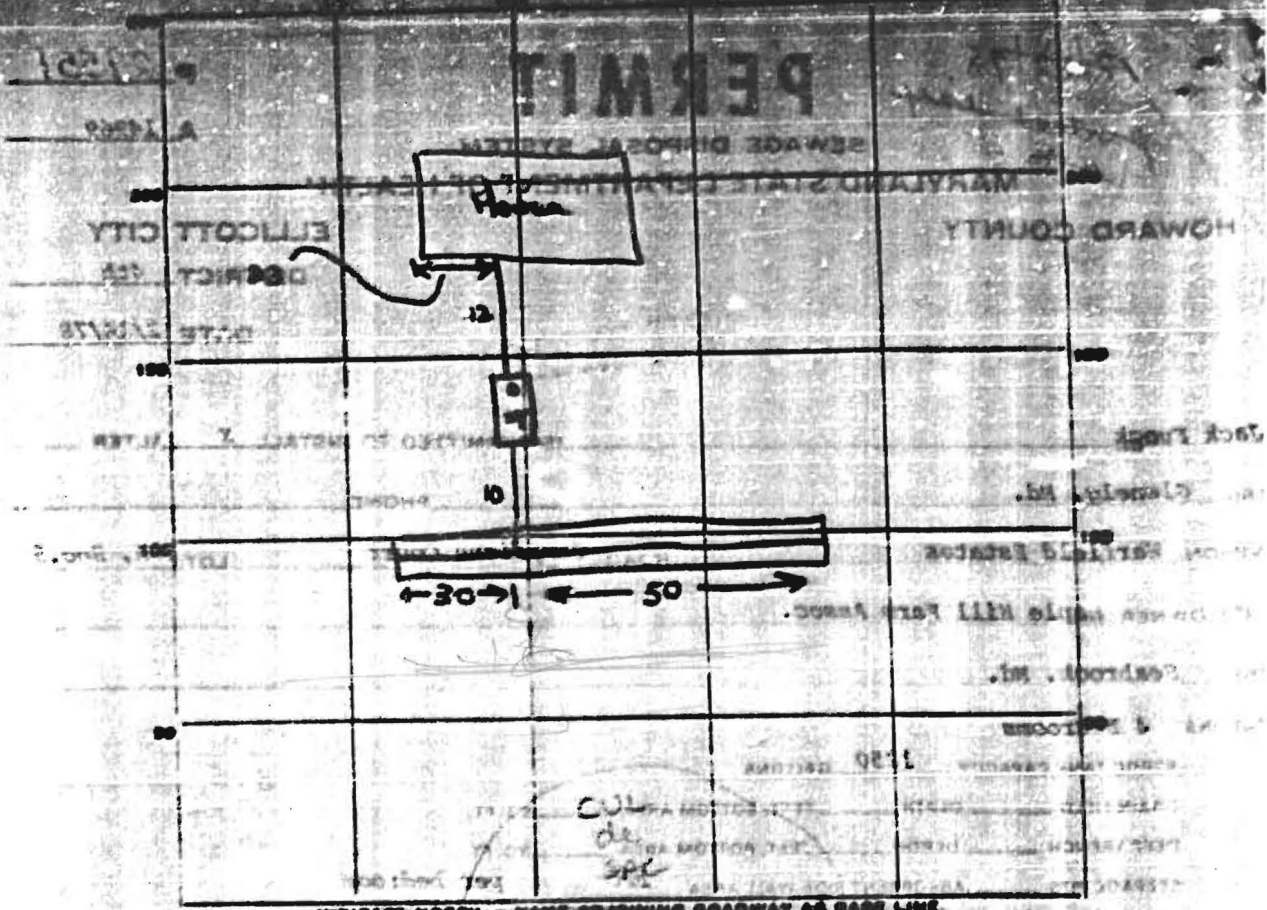

INDICATE NORTH - NAME JOINING ROADWAY AS BASE LINE.

PERMIT CARD under permit ST
 SEPTIC TANK, LEVEL CLEANOUTS two extra
 DISTRIBUTION BOX, LEVEL No
 TILE FIELD, DEPTH 11 FT. TRENCH WIDTH 2 FT.
 GRAVEL, DEPTH 6 1/2 IN. TOTAL LENGTH 80 FT.
 NUMBER OF TRENCHES 1 TOTAL COVER AREA 520
 SEEPAGE FITS, INSIDE DIAMETER _____ FT. DEPTH BELOW INLET _____ FT.

ABSORBENT AREA +520 SQ. FT.

REMARKS 22 DEC 78 - Call for final when cleanout is installed & gravel is added to trench. (GLK) Enough materials on job to complete system; gravel, perforated pipe, & cleanout. (GLK) (Om)
Final OK 22 Dec 78 (GLK)

DATE SYSTEM APPROVED 22 DEC 78 INSPECTOR A. Keller