

LAYOUT _____ INSP 4 _____

INSP 2 _____ INSP 5 _____

INSP 3 _____ INSP 6 _____

ISSUE DATE: _____

APPROVAL DATE: _____

PERMIT INDEXED

P _____

A 518512-A

ON-SITE SEWAGE DISPOSAL SYSTEM HOWARD COUNTY HEALTH DEPARTMENT BUREAU OF ENVIRONMENTAL HEALTH

04-332474

IS PERMITTED TO INSTALL ALTER

ADDRESS: _____ PHONE NUMBER: _____

SUBDIVISION: Middle Trail LOT NUMBER: 23-C

ADDRESS: 16417 Old Frederick Road PROPERTY OWNER: Donald Wickesser

SEPTIC TANK CAPACITY (GALLONS): _____ OUTLET BAFFLE FILTER REQUIRED

PUMP CHAMBER CAPACITY (GALLONS): _____ COMPARTMENTED TANK REQUIRED

NUMBER OF BEDROOMS: _____

SQUARE FEET PER BEDROOM: _____

LINEAR FEET OF TRENCH REQUIRED: _____

TRENCHES:	Trench to be _____ feet wide. Inlet _____ feet below original grade. Bottom maximum depth _____ feet below original grade. Effective area begins at _____ feet below original grade. _____ feet of stone below distribution pipe.
LOCATION:	
NOTES:	

PLANS APPROVED: _____ DATE: _____

- NOTE: PERMIT VOID AFTER 2 YEARS
- NOTE: CONTRACTOR RESPONSIBLE FOR SCHEDULING A PRE-CONSTRUCTION INSPECTION FOR ALL INSTALLATIONS
- NOTE: WATERTIGHT SEPTIC TANKS REQUIRED
- NOTE: ALL PARTS OF SEPTIC SYSTEM SHALL BE 100 FEET FROM ANY WATER WELL
- NOTE: MANHOLE RISERS REQUIRED ON ALL SEPTIC TANKS AND PUMP CHAMBERS UNLESS SPECIFICALLY AUTHORIZED

NEITHER THE HOWARD COUNTY COUNCIL NOR THE HEALTH DEPARTMENT IS RESPONSIBLE FOR THE SUCCESSFUL OPERATION OF ANY SYSTEM PERMITTEE RESPONSIBLE FOR OBTAINING FINAL APPROVAL ON THIS PERMIT

BUILDING PERMIT SIGNED 313-2640 FOR INSPECTION OF SEPTIC SYSTEM

AND RETURNED

*11/5/03 800139974 FINISH BASEMENT
1/10/04 800149857-Sunborn*

A 518512-A

Phyllis
Kevin

Post-It brand fax transmittal memo 7671 # of pages 1

To: Kevin
From: ~~Kevin~~
Co.:
Phone #: ~~410-891-6547~~
Dept.:
Fax #: ~~410-891-6547~~


We, the undersigned, do hereby certify that the improvements as shown hereon have not changed since the date of this survey.

Donald R. Wickless 10/9/92

Deed Reference: Liber 0112 Page 32

Jan M. Wickless 10/9/92

10/6/98 proposed garage location as shown.

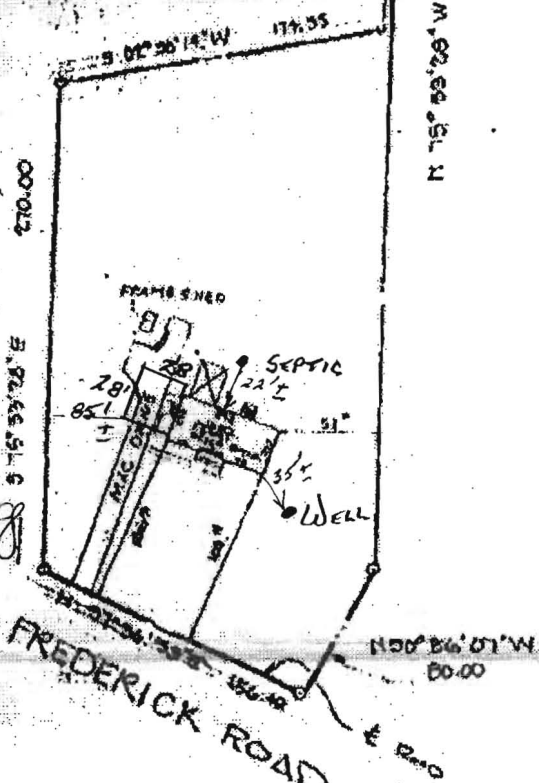

I HEREBY CERTIFY THAT I HAVE MADE A SURVEY OF THIS LOT FOR THE PURPOSE OF LOCATING THE IMPROVEMENTS THEREON AND THAT THEY ARE LOCATED AS SHOWN. THIS PLAN IS NOT INTENDED FOR USE IN ESTABLISHING PROPERTY LINES.

John C. Mellema Sr.

REG. NO. 107



LOCATION SURVEY

16417 OLD FREDERICK ROAD HOWARD CO MD

JOHN C. MELLEMA SR., INC.
LAND SURVEYORS

6100 BALTIMORE NATIONAL PIKE - BALTIMORE, MARYLAND 21220

SCALE

1"=40'

DATE

12-5-92

JOB NO.

051272