

3525 H Ellicott Mills Drive, Ellicott City, MD 21043

(410) 313-2640 Fax (410) 313-2648

TDD (410) 313-2323 Toll Free 1-866-313-6300

website: www.hchealth.org

Penny E. Borenstein, M.D., M.P.H., Health Officer

September 28, 2004

Donald and Joan Wickesser
16417 Old Frederick Road
Mt. Airy, MD 21771

RE: 16417 Old Frederick Road

Dear Mr. & Mrs. Wickesser;

We have received a variance requesting the required 10' setback to a foundation for a septic tank at the above referenced property be waived to 7'. This agency will grant your **approval** for the variance at the property as long as no part of the deck overhand is within 7' of the deck and post and pier footers are utilized.

Any questions regarding this decision may be directed to the Well and Septic Program of the Howard County Health Department.

Respectfully,

John A. Boris, Jr., R.S., Supervisor
Well and Septic Program

cc:


File

WICKESSEY
Wickesser
property
16417
OLD FRED ROAD
MD 21774


fy that
e not
y.

8/9/92

10/9/92

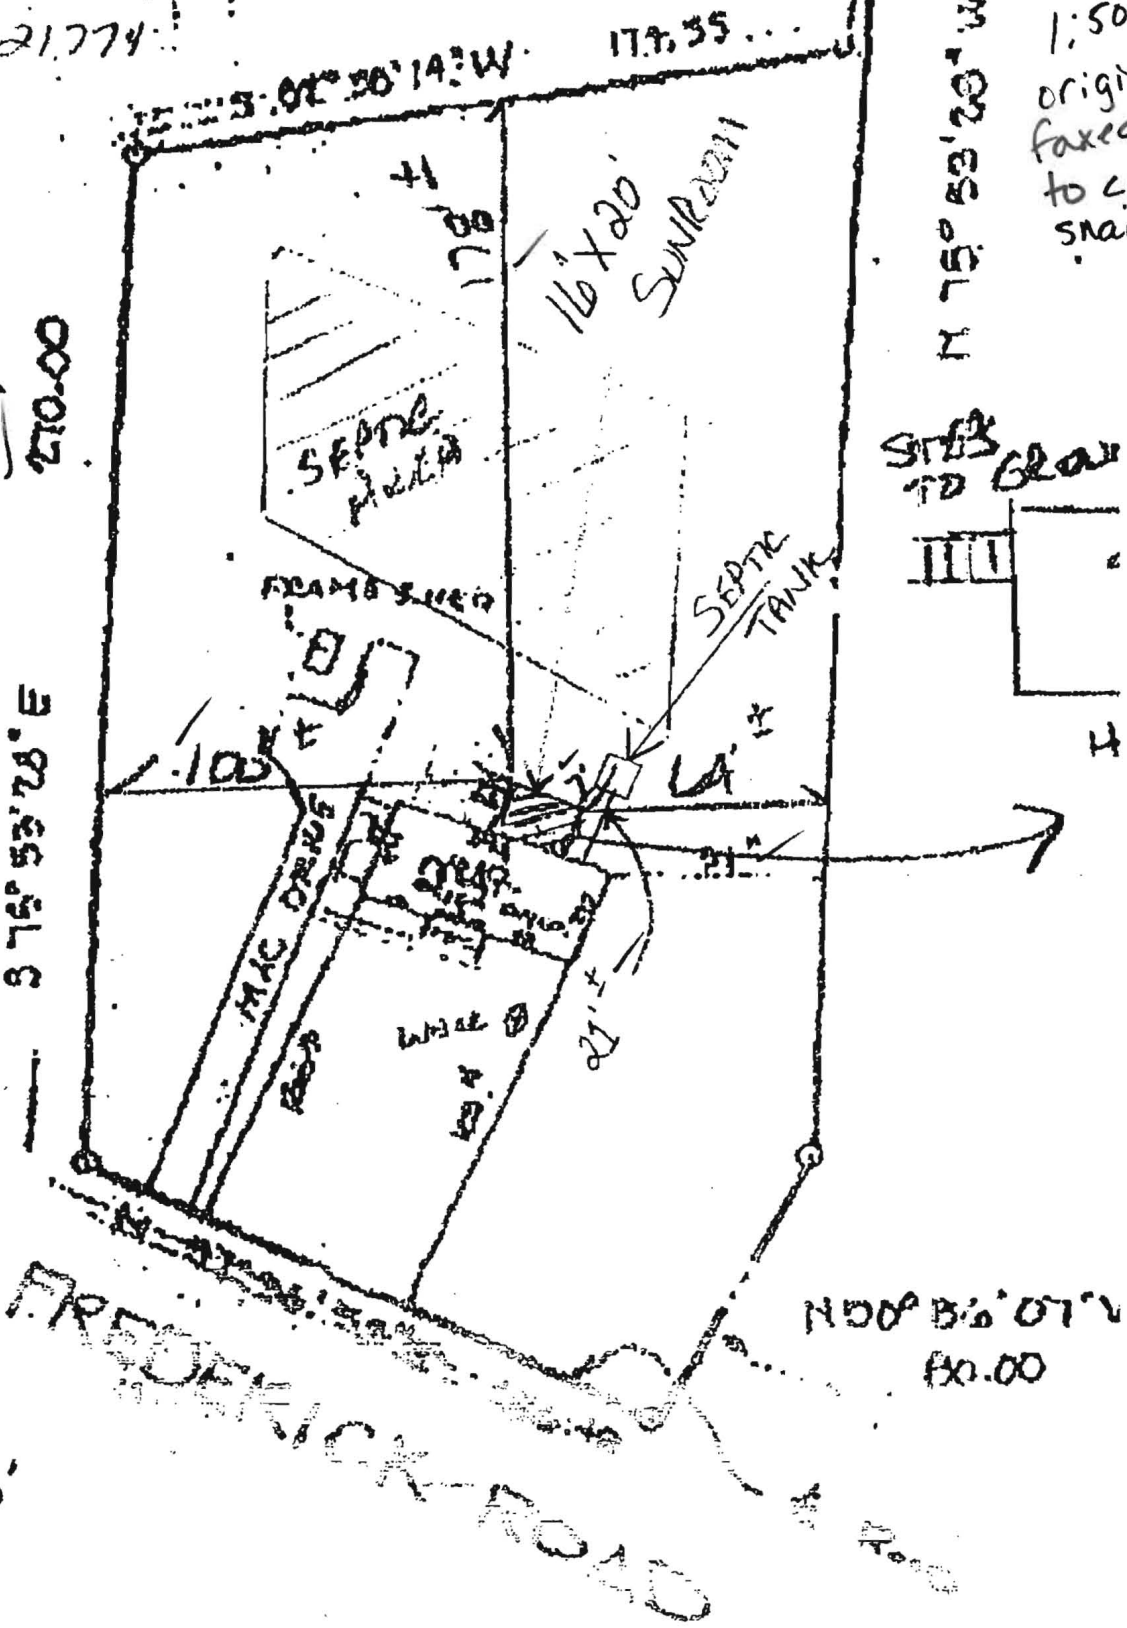

9/13/04
✓ distances
1:50 scale
original, non-
faxed copy
to come
snail mail.
(KN)

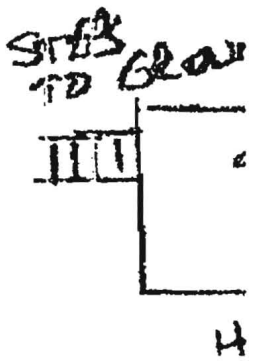

OLD

FREDRICK ROAD

1" = 50'