

PERMIT

P. 0663

A. 07637

SEWAGE DISPOSAL SYSTEM

MARYLAND STATE DEPARTMENT OF HEALTH

HOWARD COUNTY

ELLICOTT CITY

DISTRICT 5

INDEXED

DATE 7/2/66

Caroline Albert IS PERMITTED TO INSTALL X ALTER

ADDRESS Silver Spring, Maryland 20901 PHONE 594-6308

A SEWAGE DISPOSAL SYSTEM LOCATED AT _____

SUBDIVISION _____ ROAD _____ LOT _____

PROPERTY OWNER Edward Offutt

ADDRESS Box 1 - Box 121 - Spockville, Maryland

SPECIFICATIONS 3 bedrooms

DRAIN FIELD _____ DEPTH _____ FEET, BOTTOM AREA _____ SQ. FT.

SEEPAGE PITS _____ ABSORBENT SIDE-WALL AREA _____ SQ. FT.

SEPTIC TANK CAPACITY 750 GALLONS

FOR GARBAGE GRINDER, INCREASE DISPOSAL AREA 22% & TANK CAPACITY 50%.

OTHER Dry well - 12" dia diameter and 9 ft. deep below the inlet pipe.
Place dry well about 139 ft. from rear lot line and about 45 ft.
from right side line as seen when facing lot from Brighton Ave.
road.


PLANS APPROVED BY Donald V. Monahan DATE 12/4/63

FILL SEPTIC TANK AND DISTRIBUTION BOX WITH WATER BEFORE CALLING FOR AN INSPECTION. COVER HO WORK UNTIL INSPECTED AND APPROVED.

NEITHER THE HOWARD COUNTY COMMISSIONERS NOR THE HEALTH DEPARTMENT IS RESPONSIBLE FOR THE SUCCESSFUL OPERATION OF ANY SYSTEM.

A07637

A# 07637

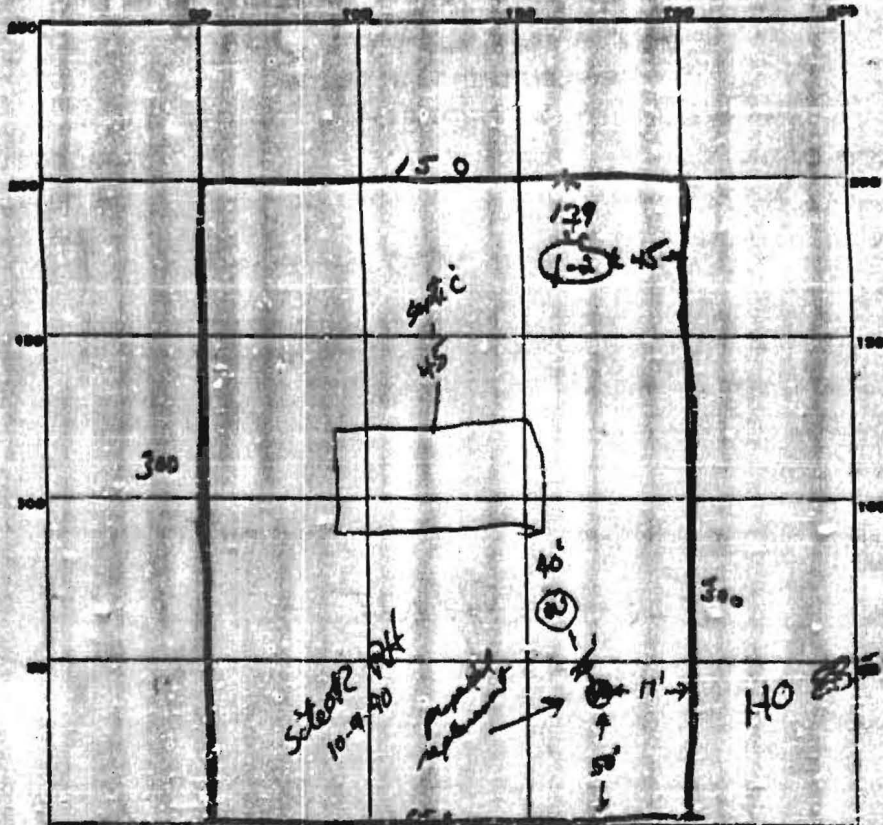

DATE	TEST NO.	DEPTH	PRE-WET		TEST - 1" DROP		TIME
			START	STOP	START	STOP	
12/1/63	1	94	946	950	950	955	955 5min
	2	48	947	950	950	955	956 6min

SOIL AUGER FINDING _____

TESTED BY: DM 12/4/63

REMARKS: *[Signature]*

ALSO PRESENT _____ LOT NO. _____