





TDL, LIMITED

16220 FREDERICK AVENUE
GAITHERSBURG, MARYLAND 20877
(301) 840-9747

PLAT 8233

BOO 124433
of 100
MER
P.B. 10 P. 97

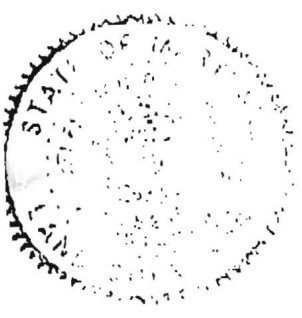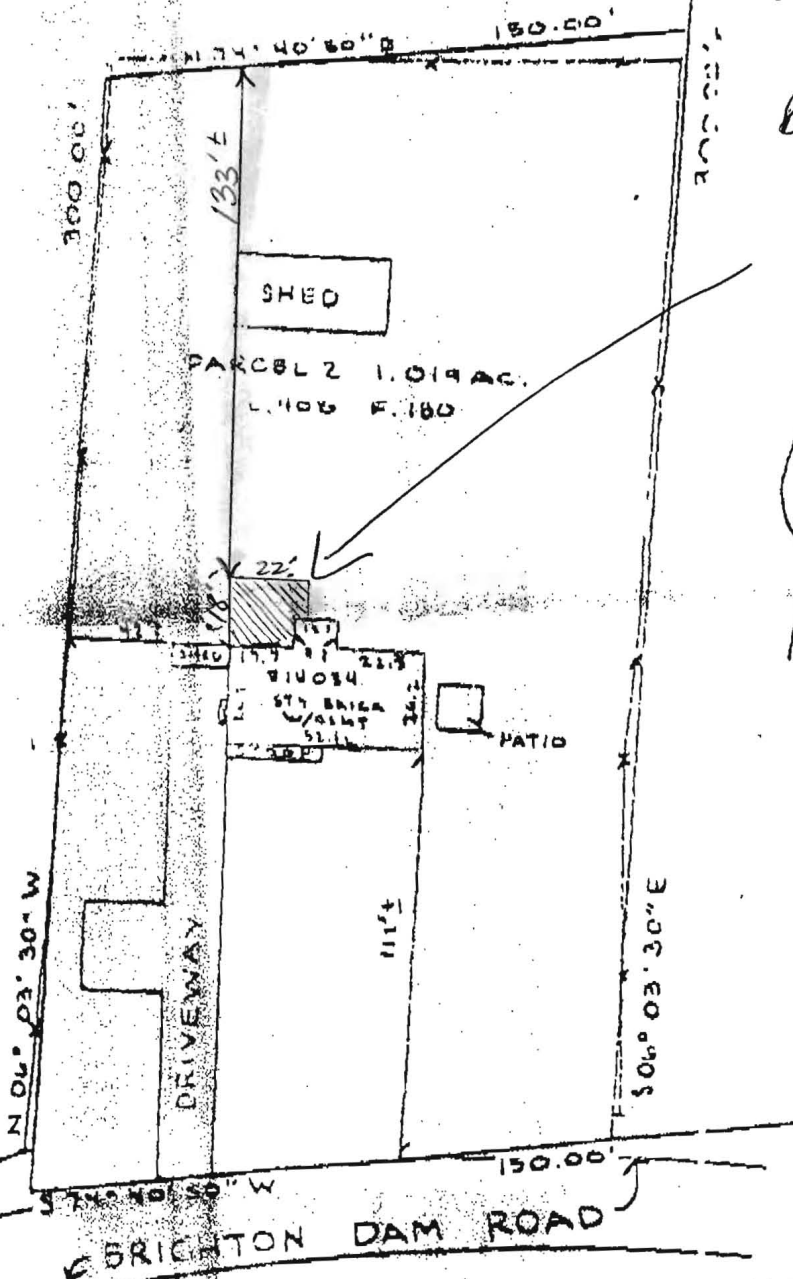

91591

Property shown hereon is not in a flood plain per existing records unless otherwise noted.

1" = 20'
RECORDED IN
BOOK LIBER: 408
FOLIO 180

HOUSE LOCATION
PARCEL 2
#14034 BRIGHTON DAM ROAD
HOWARD COUNTY, MD

This drawing is not intended to show property lines nor are any other markings shown. All information shown herein is taken from the land records only in which the property is located. Do not attempt to erect any improvements without the information contained herein.

I hereby certify that to the best of my knowledge and belief, the position of all the existing improvements on the above described property has been established by accepted field practices.

Date: May 30, 1991

Jefferson D. Lawrence
JEFFERSON D. LAWRENCE,
PROFESSIONAL LAND SURVEYOR #5216

THIS DRAWING TO BE USED FOR TITLE PURPOSES ONLY