

APPLICATION

PERCOLATION TESTING

A REPAIR
P 518547

HOWARD COUNTY HEALTH DEPARTMENT
BUREAU OF ENVIRONMENTAL HEALTH
3525-H ELLICOTT MILLS DRIVE/ELLICOTT CITY, MARYLAND 21043
TELEPHONE: 313-2640

DISTRICT _____
DATE 2/13/03

TO: THE COUNTY HEALTH OFFICER
ELLICOTT CITY, MARYLAND

I HEREBY APPLY FOR THE NECESSARY TEST PRIOR TO APPLICATION FOR PERMIT TO CONSTRUCT (OR RECONSTRUCT) A SEWAGE DISPOSAL SYSTEM.

PROPERTY OWNER Manh Nguy

ADDRESS 7188 Sanner Rd PHONE _____

AGENT OR PROSPECTIVE BUYER _____

ADDRESS _____ PHONE _____

PROPERTY LOCATION:

SUBDIVISION _____ LOT NO. _____

ROAD AND DESCRIPTION 7188 Sanner Rd

TAX MAP _____ PARCEL # _____

SIZE OF LOT _____ TYPE BLDG. _____
(SINGLE FAMILY DWELLING OR COMMERCIAL)

THE SYSTEM INSTALLED UNDER THIS APPLICATION IS ACCEPTABLE ONLY UNTIL PUBLIC FACILITIES BECOME AVAILABLE. I FULLY UNDERSTAND THE FEE CONNECTED WITH THE FILING OF THIS PERC TEST APPLICATION IS NON-REFUNDABLE UNDER ANY CIRCUMSTANCES. I ALSO AGREE TO COMPLY WITH ALL M.O.S.H.A. REQUIREMENTS IN TESTING THIS LOT.

(SIGNATURE OF APPLICANT)

APPROVED BY _____ FOR _____ DATE _____

DISAPPROVED BY _____ FOR _____ DATE _____

HOLD PENDING FURTHER TESTS _____

REASONS FOR REJECTION OR HOLDING _____

PERCOLATION TEST PLAT/PRELIMINARY PLAT - TITLE OR I.D. # _____ DATE _____

SITE DEVELOPMENT PLAN/FINAL PLAT - TITLE OR I.D. # _____ DATE _____


THIS IS NOT A PERMIT

518547



Trailer NOT TO SCALE

COUNTY #

SOIL PROFILE

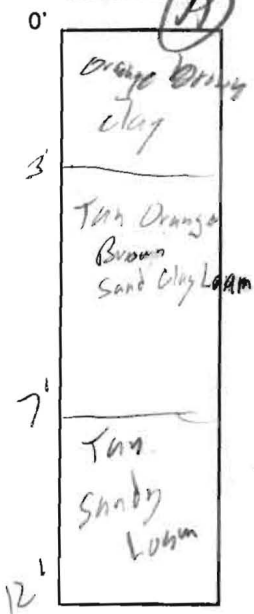

SOIL PROFILE

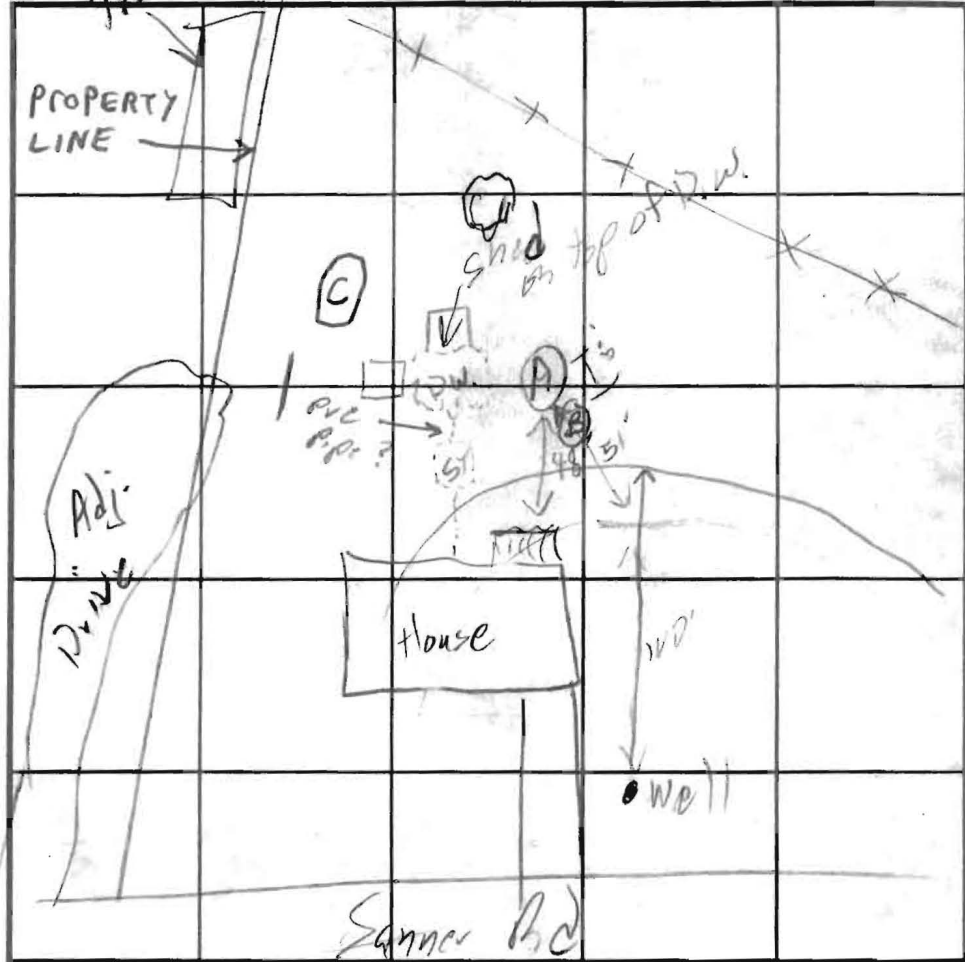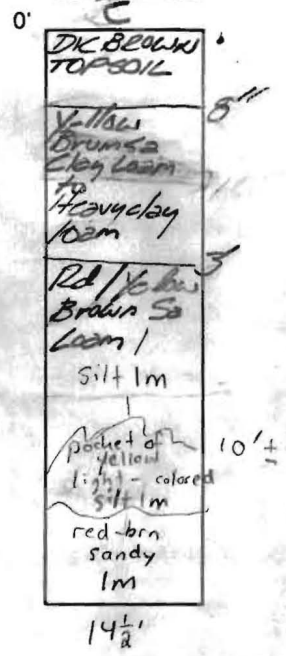

INDICATE NORTH - NAME ADJOINING ROADWAY AS BASE LINE.


DATE	TEST NO.	DEPTH	PRE-WET		TEST - 1" DROP		TIME
			START	STOP	START	STOP	
3/7/03	A	3.5' / 12' V	2:48	2:50	No movement		
		4.5'	3:01	3:20	3:20	3:50	Pipe Pulled
	B	6.5'			1/2' 7 min		
3/14/03	C	5.5' / 14' 6" V	1:12	1:17	1:17	1:27	10 min

REMARKS: Hole C - better soil material than A or B

TYPE OF SOIL: SD & SRK/FA on 3/14/03
 TESTED BY: SD & SRK/FA on 3/14/03 ALSO PRESENT: Dave, Richard
 TRENCH DESIGN DATA: AVERAGE PERCOLATION TIME: 8-15 TRENCH WIDTH: 3
 INLET DEPTH: 4.5 MAXIMUM BOTTOM DEPTH: 10.5 SQ. FT./BEDROOM: 210



District - 05 Account Number - 343267

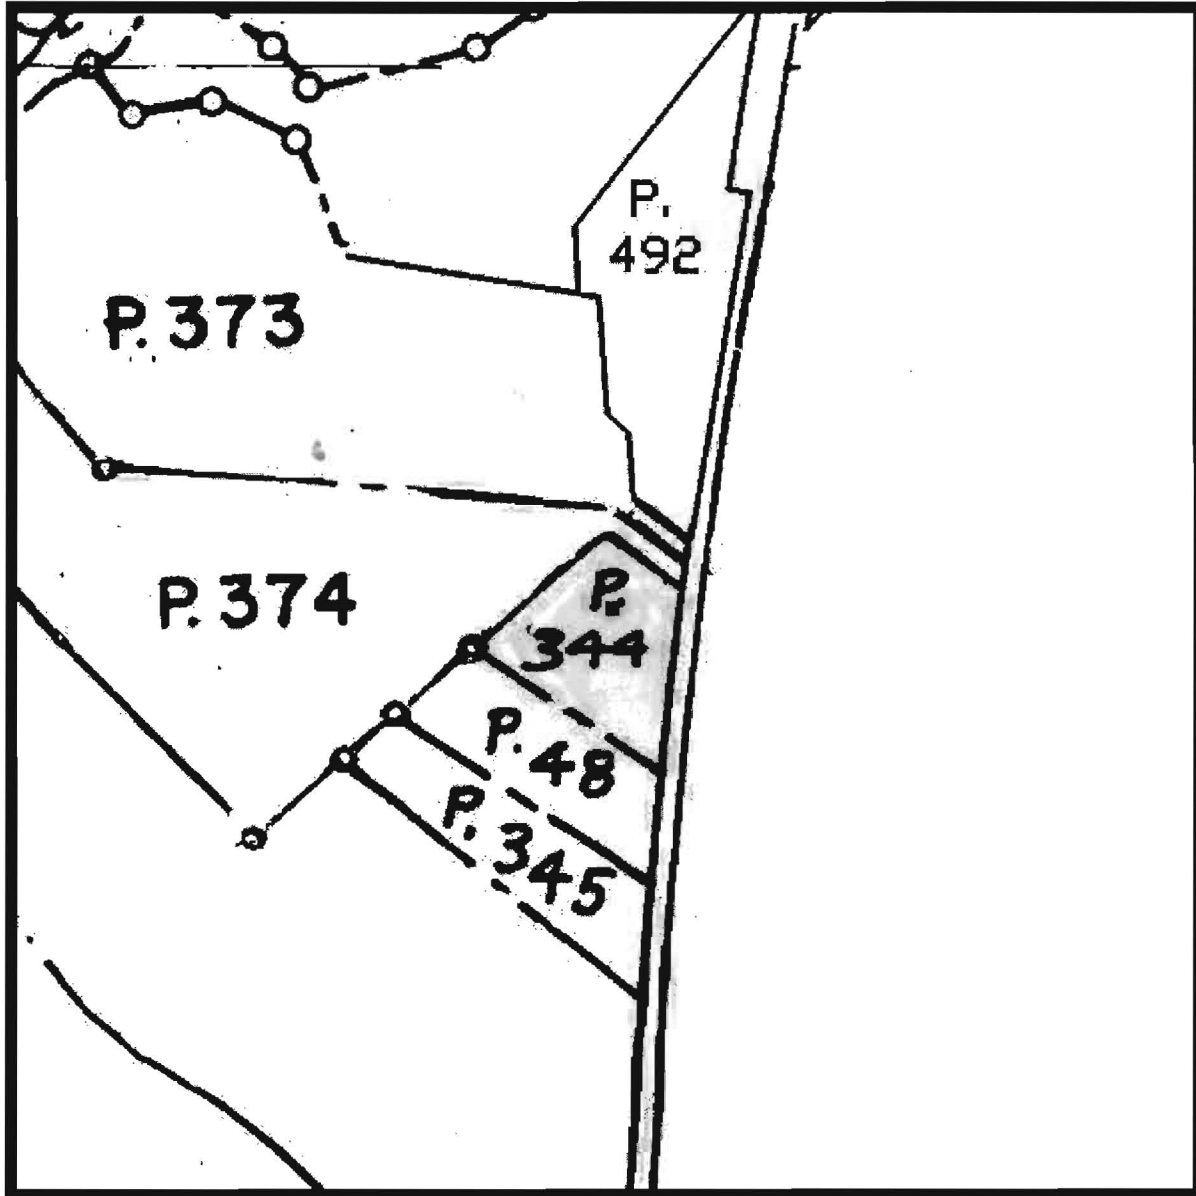

Property maps provided courtesy of the Maryland Department of Planning ©2001.
For more information on electronic mapping applications, visit the Maryland Department of Planning
web site at www.mdp.state.md.us

Click here for a plain text ADA compliant screen.

	Maryland Department of Assessments and Taxation HOWARD COUNTY Real Property Data Search	Go Back View Map New Search
---	--	---

Account Identifier: District - 05 Account Number - 343267

Owner Information

Owner Name:	NGUY NORMAN HANH NGUY JACQUELINE HUU DO	Use:	RESIDENTIAL
		Principal Residence:	YES
Mailing Address:	7188 SANNER RD CLARKSVILLE MD 21029-1803	Deed Reference:	1) / 6395/ 76 2)

Location & Structure Information

Premises Address 7188 SANNER RD CLARKSVILLE 21029	Zoning RRDEO	Legal Description LOT 3 (.922A) 7188 SANNER RD CLARKSVILLE
--	------------------------	--

Map	Grid	Parcel	Sub District	Subdivision	Section	Block	Lot	Group	Plat No:
41	10	344					3	81	Plat Ref:

Special Tax Areas	Town Ad Valorem Tax Class	NO A/V, NO M/P, RURAL FIRE TAX
--------------------------	----------------------------------	--------------------------------

Primary Structure Built 1971	Enclosed Area 864 SF	Property Land Area 40,075.00 SF	County Use
--	--------------------------------	---	-------------------

Stories 1	Basement YES	Type STANDARD UNIT	Exterior FRAME
---------------------	------------------------	------------------------------	--------------------------

Value Information

	Base Value	Value As Of 01/01/2002	Phase-in Assessments As Of 07/01/2002	As Of 07/01/2003
Land:	87,250	116,270		
Improvements:	55,380	76,800		
Total:	142,630	193,070	159,443	176,256
Preferential Land:	0	0	0	0

Transfer Information

Seller: MYERS JAMES E	Date: 09/05/2002	Price: \$176,000
Type: IMPROVED ARMS-LENGTH	Deed1: / 6395/ 76	Deed2:
Seller: BLACKSTON HATTIE H &	Date: 09/09/1985	Price: \$0
Type: NOT ARMS-LENGTH	Deed1: / 1390/ 100	Deed2:
Seller:	Date:	Price:
Type:	Deed1:	Deed2:

Exemption Information

Partial Exempt Assessments	Class	07/01/2002	07/01/2003
County	000	0	0
State	000	0	0
Municipal	000	0	0

Tax Exempt: NO	Special Tax Recapture:
Exempt Class:	* NONE *