

8/20/71
after 9:30
would like to amend
specifications as early as
possible please

Approved Final C. B. S.
8/20/71

PERMIT

SEWAGE DISPOSAL SYSTEM

MARYLAND STATE DEPARTMENT OF HEALTH

HOWARD COUNTY

INDEXED

P. 14835

A. 14839

ELLICOTT CITY

DISTRICT 2

DATE 8/27/71

Norman Sisk IS PERMITTED TO INSTALL ALTER

ADDRESS Old Annapolis Road, Washine, MD. PHONE 489-4724

A SEWAGE DISPOSAL SYSTEM LOCATED AT _____

SUBDIVISION _____ ROAD 7188 Sander LOT 3

PROPERTY OWNER Mattie Blackston

ADDRESS _____

SPECIFICATIONS 3 bedrooms

DRAIN FIELD _____ DEPTH _____ FEET. BOTTOM AREA _____ SQ. FT.

SEEPAGE PITS _____ ABSORBENT SIDE-WALL AREA _____ SQ. FT.

SEPTIC TANK CAPACITY 1,000 GALLONS

FOR GARBAGE GRINDER, INCREASE DISPOSAL AREA 22% & TANK CAPACITY 50%

OTHER Dry well - 100 sq. ft. absorbent sidewall area per bedroom to begin below the first 4 ft. of original soil. Maximum depth permitted for dry well is 11 ft. below original grade. Locate dry well 56 ft. off left side line and 46 ft. off rear property line as seen from Sander Road.


NOTE: ALL PIPE FROM HOUSE TO SEPTIC TANK MUST BE CAST IRON.
PERMIT VOID AFTER THREE YEARS.

PLANS APPROVED BY Robert V. Torres DATE 9/2/71

FILL SEPTIC TANK AND DISTRIBUTION BOX WITH WATER BEFORE CALLING FOR AN INSPECTION COVER NO WORK UNTIL INSPECTED AND APPROVED.

NEITHER THE HOWARD COUNTY COMMISSIONERS NOR THE HEALTH DEPARTMENT IS RESPONSIBLE FOR THE SUCCESSFUL OPERATION OF ANY SYSTEM

14839

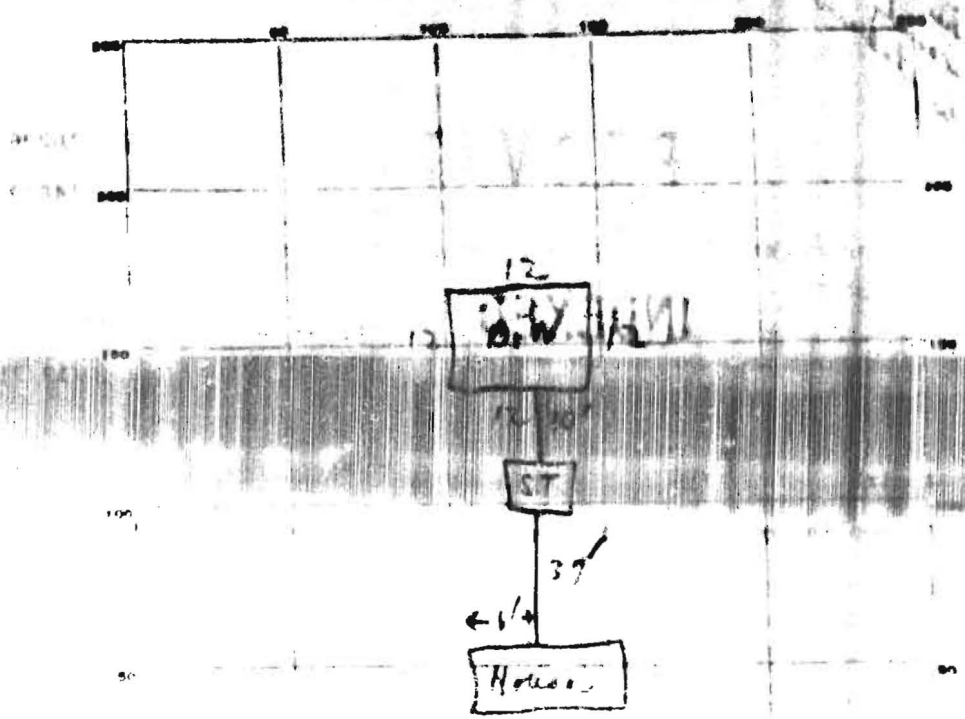


INDICATE NORTH NAME ADJOINING ROADWAY AS BASE LINE

TRAP TANK LEVEL OK CLEANOUTS OK
 DISTRIBUTION BOX LEVEL _____
 TRENCH DEPTH _____ FT. TRENCH WIDTH _____ FT.
 GRAVEL DEPTH _____ IN. TOTAL LENGTH _____ FT.
 NUMBER OF BENCHES _____ TOTAL BOTTOM AREA _____
 DEPTH BELOW IN. LT. 7 FT.
 ABSORBENT AREA 336 SQ. FT.

REMARKS _____

APPROVED 8/20/71 INSPECTOR C. Straker

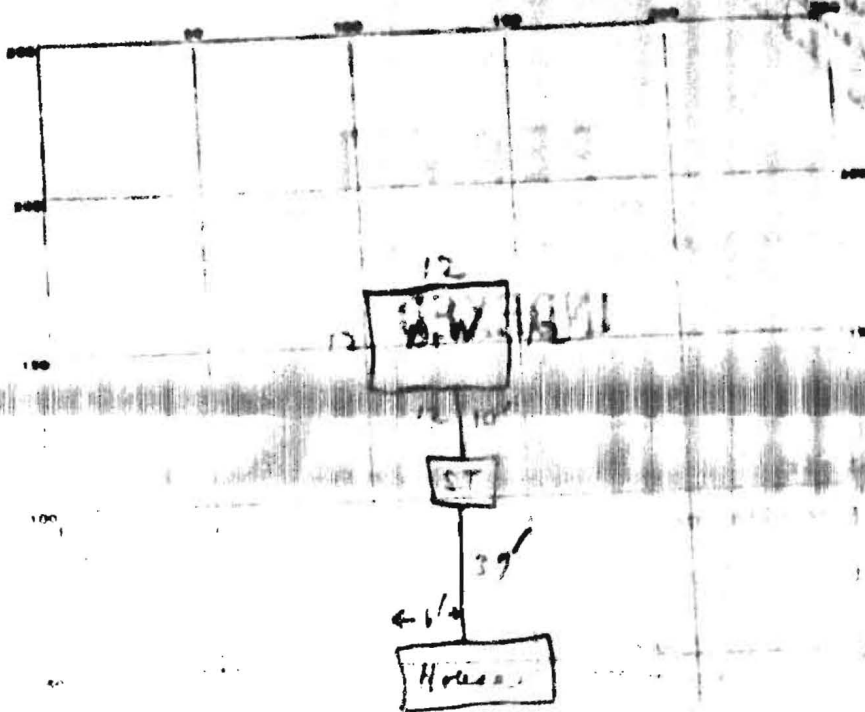

INDICATE NORTH NAME ADJOINING ROADWAY AT BASE LINE

PERMIT CARD NO. 1491

LITIC TANK LEVEL OK CLEANOUTS OK

DISTRIBUTION BOX LEVEL _____

PILE FIELD DEPTH _____ FT. TRENCH WIDTH _____ FT.

GRAVEL DEPTH _____ IN. TOTAL LENGTH _____ FT.

NUMBER OF BENCHES _____ TOTAL BOTTOM AREA _____

PERPAGE FITS. INGRESS OR EGRESS Perimeter 48 FT. DEPTH BELOW INLET 7 FT.

ABSORBENT AREA 33 6 SQ FT

REMARKS _____

DATE SYSTEM APPROVED 8/20/71 INSPECTOR C. Straker