


APPLICATION

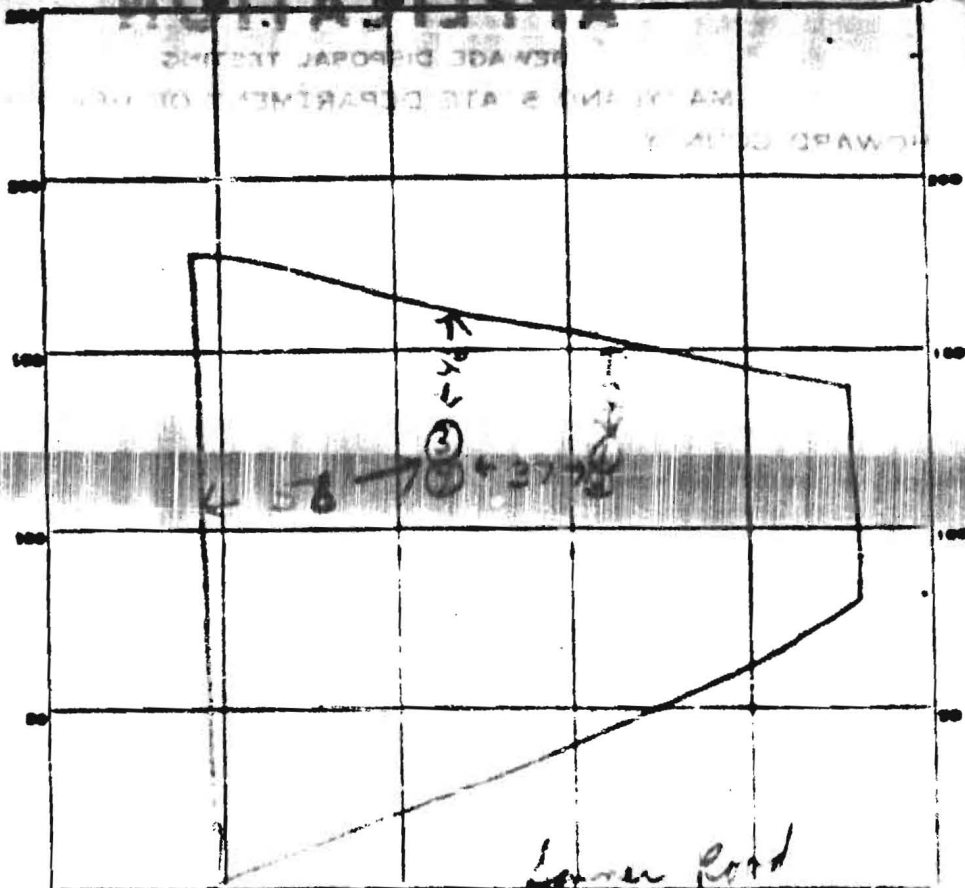


INDICATE NORTH - NAME ADJOINING ROADWAY AS BASE LINE

DATE	TEST NO.	DEPTH	PRE-WET		TEST - 1" DROP		TIME
			START	STOP	START	STOP	
	1	10 1/2 ft	10 43	10 44	10 46	10 56	8 min
	2	5 ft	10 45	10 47	10 47	10 51	4 min
	3	11 ft	10 58	11 02	11 02	11 11	9 min
	4	4 1/2 ft	10 57	10 59	10 59	10 03	4 min

SOIL AUGER FINDING _____
 TESTED BY R. Toner
 REMARKS _____

THIS IS A TOP OF SHEET

APPLICATION

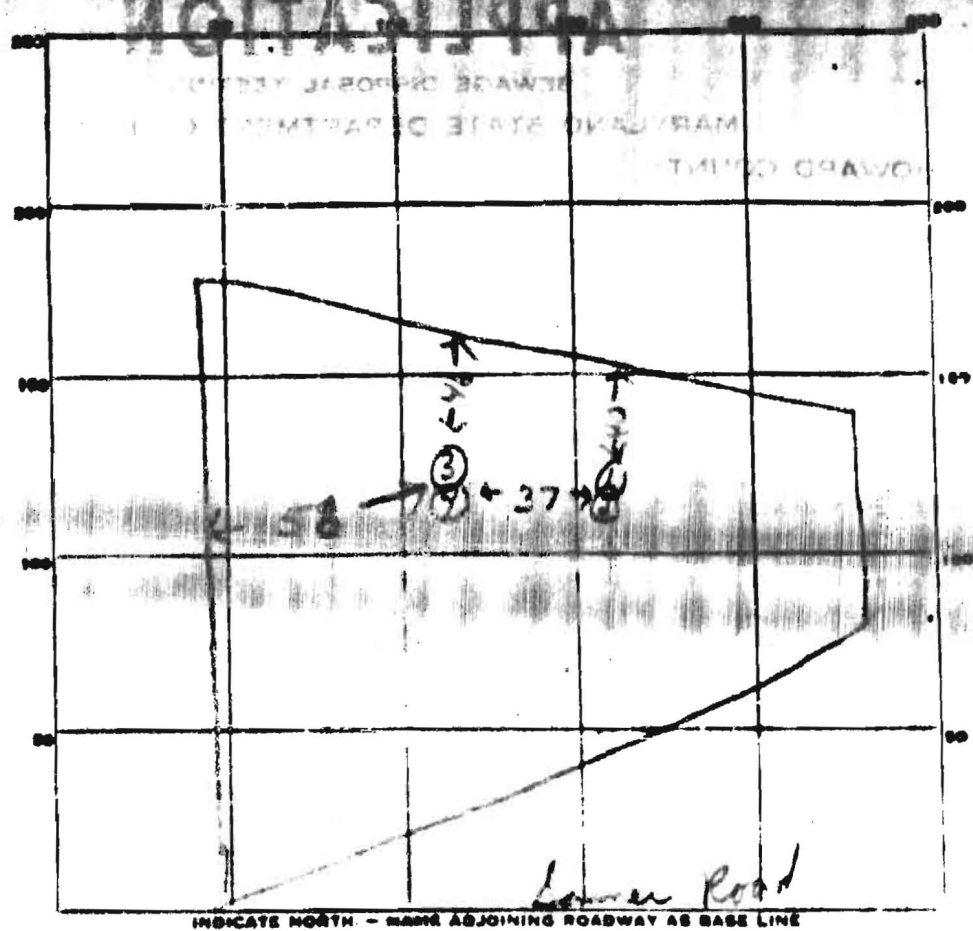

INDICATE NORTH - NAME ADJOINING ROADWAY AS BASE LINE

DATE	TEST NO.	DEPTH	PRE-WET		TEST - 1" DROP		TIME
			START	STOP	START	STOP	
	1	10 1/2 ft	10 43	10 46	10 46	10 56	8 min
	2	5 ft	10 45	10 47	10 47	10 51	4 min
	3	11 ft	10 58	11 02	11 02	11 11	9 min
	4	4 1/2 ft	10 57	10 59	10 59	10 03	4 min

SOIL AUGER FINDING _____

TESTED BY R. Jones

REMARKS _____