

PUB. SEWER STATUS VERIFIED BY _____

ISSUE DATE: _____

APPROVAL DATE: _____

PERMIT INDEXED

P 518570-B

A re-index

ON-SITE SEWAGE DISPOSAL SYSTEM HOWARD COUNTY HEALTH DEPARTMENT BUREAU OF ENVIRONMENTAL HEALTH

04-313003

IS PERMITTED TO INSTALL ALTER

ADDRESS: _____ PHONE NUMBER: _____

SUBDIVISION: _____ LOT NUMBER: _____

ADDRESS: 15860 A E Mullinix Road PROPERTY OWNER: Flook

SEPTIC TANK CAPACITY (GALLONS): _____

PUMP CHAMBER CAPACITY (GALLONS): _____

NUMBER OF BEDROOMS: _____

SQUARE FEET PER BEDROOM: _____

LINEAR FEET OF TRENCH REQUIRED: _____

TRENCHES:	Trench to be _____ feet wide. Inlet _____ feet below original grade. Bottom maximum depth _____ feet below original grade. Effective area begins at _____ feet below original grade. _____ feet of stone below distribution pipe.
LOCATION:	
PURPOSE:	Re-index file, building permit addition approved 3/31/03

PLANS APPROVED: _____ DATE: _____

NOTE: PERMIT VOID AFTER 2 YEARS

NOTE: CONTRACTOR RESPONSIBLE FOR SCHEDULING A PRE-CONSTRUCTION INSPECTION FOR ALL INSTALLATIONS

NOTE: WATERTIGHT SEPTIC TANKS REQUIRED

NOTE: ALL PARTS OF SEPTIC SYSTEM SHALL BE 100 FEET FROM ANY WATER WELL

NOTE: MANHOLE RISERS REQUIRED ON ALL SEPTIC TANKS AND PUMP CHAMBERS

NEITHER THE HOWARD COUNTY COUNCIL NOR THE HEALTH DEPARTMENT IS RESPONSIBLE FOR THE SUCCESSFUL OPERATION OF ANY SYSTEM PERMITTEE RESPONSIBLE FOR OBTAINING FINAL APPROVAL ON THIS PERMIT CALL 410-313-2640 FOR INSPECTION OF SEPTIC SYSTEM

P518570-B

PERMIT INDEXED

SEWAGE DISPOSAL SYSTEM

MARYLAND STATE DEPARTMENT OF HEALTH

HOWARD COUNTY

ELICOTT CITY

DISTRICT 4

DATE 7/8/76

Thomas P. Dow, Jr. IS PERMITTED TO INSTALL 1 ALTER

ADDRESS 2002 91st B. Highway Park Lane, Laurel, Md. PHONE 422-0130

A SEWAGE DISPOSAL SYSTEM LOCATED AT _____

SUBDIVISION _____ ROAD 15th A. E. Hillside Blot

PROPERTY OWNER Thomas P. Dow, Jr.

ADDRESS _____

SPECIFICATIONS - 2 bedrooms

DRAIN FIELD _____ DEPTH _____ FEET, BOTTOM AREA _____ SQ. FT.

SEEPAGE PITS _____ ABSORBENT SIDE-WALL AREA _____ SQ. FT.

SEPTIC TANK CAPACITY 1,000 GALLONS

FOR GARAGE GRINDER, INCREASE DISPOSAL AREA 25% & TANK CAPACITY 50% (7/7/76)

OTHER: Dry well to have 125 sq. ft. effective absorbent sidewall area below final pipe bed minimum 300 sq. ft. effective absorbent area. Inlet to be 4 ft. below original grade and minimum depth 1 1/2 ft. Location 210 ft. from left

Notes in front of permit (2nd). See above if not clear see hole (1 & 2).

NOTE: ALL PIPE FROM HOUSE TO DISPOSAL AREA MUST BE CAST IRON.
PERMIT VOID AFTER THREE YEARS.

NOTE: INSTALL STAIN PIPE ON SEPTIC TANK AND DRY WELL. STAIN PIPE MUST BE 6" IN DIA.,

PLANS APPROVED BY C. Stegatz DATE 7/8/76
CAST IRON, CONCRETE OR TERRA COTTA ACCEPTED.

FILL SEPTIC TANK AND DISTRIBUTION BOX WITH WATER BEFORE CALLING FOR AN INSPECTION. COVER NO WORK UNTIL INSPECTED AND APPROVED.

(Mr. Paltzell called 7/7/76 see above)


NEITHER THE HOWARD COUNTY COMMISSIONERS NOR THE HEALTH DEPARTMENT IS RESPONSIBLE FOR THE SUCCESSFUL OPERATION OF ANY SYSTEM.

BLDG. PERMIT SIGNED AND RETURNED 4/29/83
Serial # 545-93
Law

18081

9 E. Mathews Rd

PERMIT
SEWAGE DISPOSAL SYSTEM
MARYLAND STATE DEPARTMENT OF HEALTH

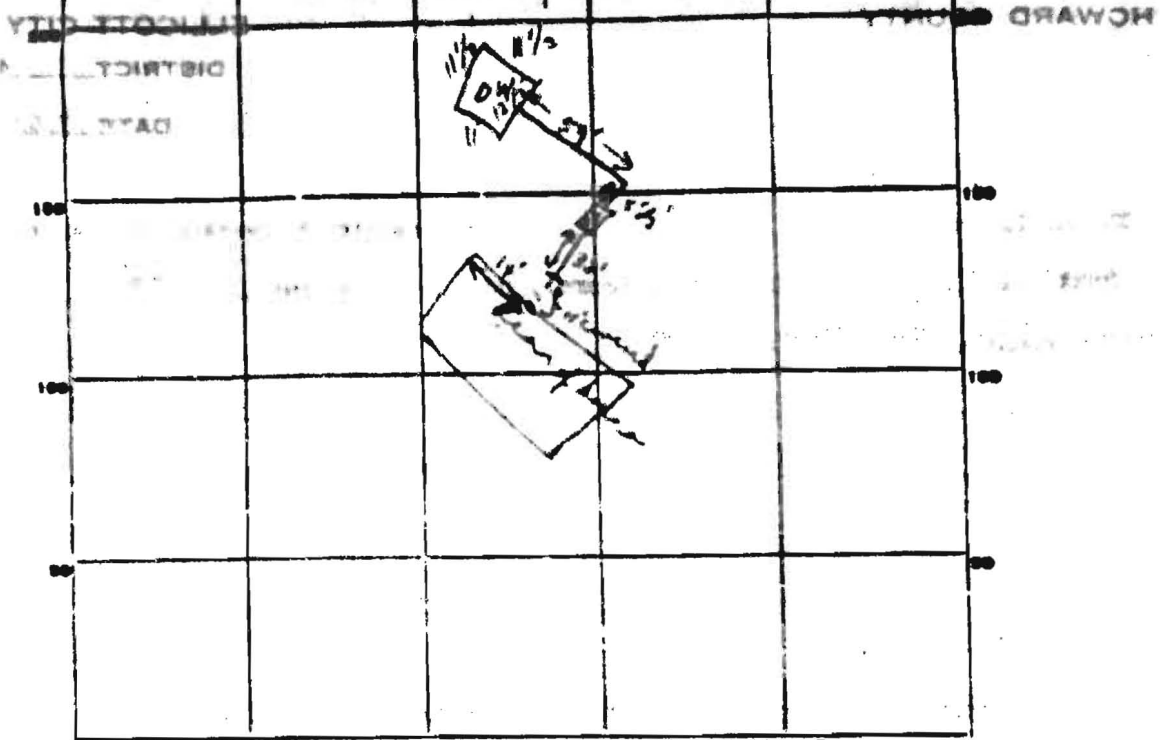

PERMIT CARD _____ yes on house at front S.T. / P.W.
 SEPTIC TANK, LEVEL _____ 4 1/2 CLEANOUTS _____ ok / ok (w/ ground)
 DISTRIBUTION BOX, LEVEL _____
 TRENCH, DEPTH _____ FT. TRENCH WIDTH _____ FT.
 GRAVEL DEPTH _____ IN. TOTAL LENGTH _____ FT.
 NUMBER OF TRENCHES _____ TOTAL BOTTOM AREA _____
 SEWAGE PITS, INSIDE DIAMETER _____ 4 1/2 FT. DEPTH BELOW INLET _____ 6'-9" FT.
 ABSORBENT AREA _____ 302 + 98 FT.

REMARKS _____ 3/26/76 Hold for water test of pipe-covered
 _____ part 11' out from house, or uncovers pipe
 _____ 10/23/90 see attached letter

DATE SYSTEM APPROVED _____ 10/26/46 INSPECTOR _____ Pat O'Neill