

ci 8544  
 SEQUENCE NO. (WRA USE ONLY)  
 1 2 3 (SEQ. NO.) 8  
 (THIS NUMBER IS TO BE PUNCHED IN COLD, 3-0 ON ALL CARDS)

STATE OF MARYLAND  
 WATER RESOURCES ADMINISTRATION  
 TAWES STATE OFFICE BLDG., ANNAPOLIS, MD. 21401  
 WELL COMPLETION REPORT

THIS REPORT MUST BE SUBMITTED WITHIN 30 DAYS AFTER WELL COMPLETION  
 FILL IN THIS FORM COMPLETELY  
 COUNTY NUMBER

DATE RECEIVED (WRA USE ONLY) \_\_\_\_\_ DEPTH OF WELL 30 A20791 PERMIT NO. FROM "PERMIT TO DRILL WELL" 71-73-2020  
 DATE WELL COMPLETED \_\_\_\_\_ 22 (TO NEAREST FOOT) 20  
 8-13 \_\_\_\_\_ DRILLERS IDENTIFICATION NO. 42

OWNER Clark Thomas  
 LAST NAME FIRST NAME  
 STREET OR RFD POST OFFICE

WELL LOG

DESCRIPTION (USE ADDITIONAL SHEETS IF NECESSARY)	FEET		CHECK IF WATER BEARING
	FROM	TO	
Top Soil	0	2	
Shaly	2	10	
MICA	10	22	
SAND Stone	22	45	✓
MICA	45	80	✓

2" casing  
 1" P. open  
 5" open  
 R.P.M.  
 3 ft 7"

GROUTING RECORD

WELL HAS BEEN GROUTED (CIRCLE APPROPRIATE BOX) YES (Y) NO (N)  
 TYPE OF GROUTING MATERIAL (CIRCLE BOX)  
 CEMENT (C) M BENTONITE CLAY (B) C  
 NO. OF BAGS NO. OF POUNDS  
 GALLONS OF WATER  
 DEPTH OF GROUT SEAL (TO NEAREST FOOT)  
 FROM 0 FT. TO 17 FT.  
 (ENTER 0 IF FROM SURFACE)

CASING RECORD

CASING TYPES (INSERT APPROPRIATE CODE BELOW)  
 STEEL (S) CONCRETE (C)  
 PLASTIC (P) OTHER (O)  
 MAIN CASING TYPE NOMINAL DIAMETER TOP (MAIN) CASING (NEAREST INCH) TOTAL DEPTH OF MAIN CASING (NEAREST FOOT)  
 5 7 4 21

OTHER CASING (IF USED)  
 DIAMETER (INCH) DEPTH (FEET) FROM TO

SCREEN RECORD

SCREEN TYPE OR OPEN HOLE (INSERT APPROPRIATE CODE BELOW)  
 STEEL (S) BRASS OR BRONZE (B) OPEN HOLE (H) O  
 PLASTIC (P) OTHER (O)  
 C 2 (SEQ. NO.) 8  
 DEPTH (NEAREST WHOLE FOOT) FROM 14 TO 50  
 8 9 11 15 17 21  
 23 24 26 30 32 36  
 38 39 41 45 47 51  
 SLOT SIZE 1, 2, 3

PUMPING TEST

HOURS PUMPED (TO NEAREST HOUR) 2  
 PUMPING RATE (GALLONS PER MINUTE TO NEAREST GALLON) 30  
 METHOD USED TO MEASURE PUMPING RATE Bucket  
 WATER LEVEL (DISTANCE FROM LAND SURFACE) BEFORE PUMPING 17 (NEAREST FOOT) 20  
 WHEN PUMPING 22 (NEAREST FOOT) 25  
 TYPE OF PUMPED USE (CIRCLE APPROPRIATE BOX) (FOR PUMPING TEST)  
 AIR (A) PISTON (P) TURBINE (T)  
 CENTRIFUGAL (C) ROTARY (R) OTHER (DESCRIBE BELOW) (O)  
 JET (J) SUBMERSIBLE (S)


PUMP INSTALLED

TYPE OF PUMP (WRITE APPROPRIATE LETTER IN BOX - SEE ABOVE: A, C, J, P, R, S, T, O)  
 DRILLER WILL INSTALL PUMP (CIRCLE APPROPRIATE BOX) YES (Y) NO (N)  
 CAPACITY:  
 GALLONS PER MINUTE (TO NEAREST GALLON) 31 35  
 PUMP HORSE POWER 37 41  
 PUMP COLUMN LENGTH (NEAREST FOOT) 43 47

CASING HEIGHT

(CIRCLE APPROPRIATE BOX AND ENTER CASING HEIGHT)  
 ABOVE (A) LAND SURFACE (NEAREST FOOT) 2  
 BELOW (B) 49 51

LOCATION OF WELL ON LOT

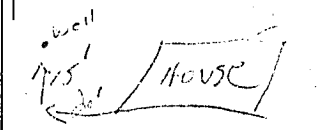

CIRCLE APPROPRIATE BOXES

A A WELL WAS ABANDONED AND SEALED WHEN THIS WELL WAS COMPLETED  
 E ELECTRIC LOG OBTAINED  
 P TEST WELL CONVERTED TO PRODUCTION WELL

I HEREBY CERTIFY THAT I HAVE COMPLIED WITH ALL CONDITIONS STATED ON THE ABOVE-CAPTIONED "PERMIT TO DRILL WELL", AND THAT INFORMATION CONTAINED IN THIS REPORT IS TRUE, ACCURATE, AND COMPLETE TO THE BEST OF MY KNOWLEDGE, INFORMATION AND BELIEF.

DRILLERS NAME  
 (PLEASE PRINT) F. S. ...

SIGNATURE

DIAMETER OF SCREEN 26 30 (NEAREST INCH) FROM TO

GRAVEL PACK

IF WELL DRILLED WAS A FLOWING WELL CIRCLE BOX 68 F

WRA USE ONLY (NOT TO BE FILLED IN BY DRILLER)  
 T (E.P.O.S.) W O  
 70 72 74 75 76 OTHER DATA AVAILABLE