

Prep.
4/2/84
9:30

APPLICATION

SEWAGE DISPOSAL TESTING

STATE OF MARYLAND - DEPARTMENT OF HEALTH AND MENTAL HYGIENE

A 33680

P _____

HOWARD COUNTY HEALTH DEPARTMENT
ENVIRONMENTAL HEALTH SERVICES

P. O. BOX 476 ELLICOTT CITY, MARYLAND 21043
TELEPHONE: 992-2330

DISTRICT 5

DATE 3/12/84

TO: THE COUNTY HEALTH OFFICER
ELLICOTT CITY, MARYLAND

I, HEREBY, APPLY FOR THE NECESSARY TEST IN ORDER TO CONSTRUCT (OR RECONSTRUCT) A SEWAGE DISPOSAL SYSTEM.

PROPERTY OWNER Edwin G. Wilton Land Develop. Corp.

ADDRESS Box 32 Ashton Md 20861 PHONE 854 0300

PROPERTY LOCATION:

SUBDIVISION Fox Pause 6700 Guilford Rd. LOT NO. LOT 11
~~#~~ Revised 4-23-84

ROAD AND DESCRIPTION Corner Route 32 + Halls Shop Rd

SIZE OF LOT 3.15 acres TYPE BLDG. 991 Family 4 Bed
(NUMBER OF BEDROOMS)

THE SYSTEM INSTALLED UNDER THIS APPLICATION IS ACCEPTABLE ONLY UNTIL PUBLIC FACILITIES BECOME AVAILABLE. I FULLY UNDERSTAND THE FEE CONNECTED WITH THE FILING OF THIS PERC TEST APPLICATION IS NON-REFUNDABLE UNDER ANY CIRCUMSTANCES. I ALSO AGREE TO COMPLY

WITH ALL M.O.S.H.A. REQUIREMENTS IN TESTING THIS LOT. Edwin G. Wilton
(SIGNATURE OF APPLICANT)

APPROVED BY Sidney Abel FOR Deep Trenches BLDG. PERMIT 1-7-87
AND RETURNED 1-7-87 8766

REJECTED BY _____ FOR _____ DATE 049609


HOLD PENDING FURTHER TESTS _____ DATE _____

REASONS FOR REJECTION OR HOLDING 3-27-85 Perc. Results SATISFACTORY, Hold For Certified Hole
LOCATION, House + well site. SAME 5/20/86 SPBES
WRITTEN

THIS IS NOT A PERMIT

① ② ③
④
SOIL PROFILE

0"
9"
3.5'
AP
RED BROWN
CLAY LOAM
LO %
SAPROCLITE
RED BROWN
SILTY SAND
MICACEOUS
10-20%
SAPROCLITE

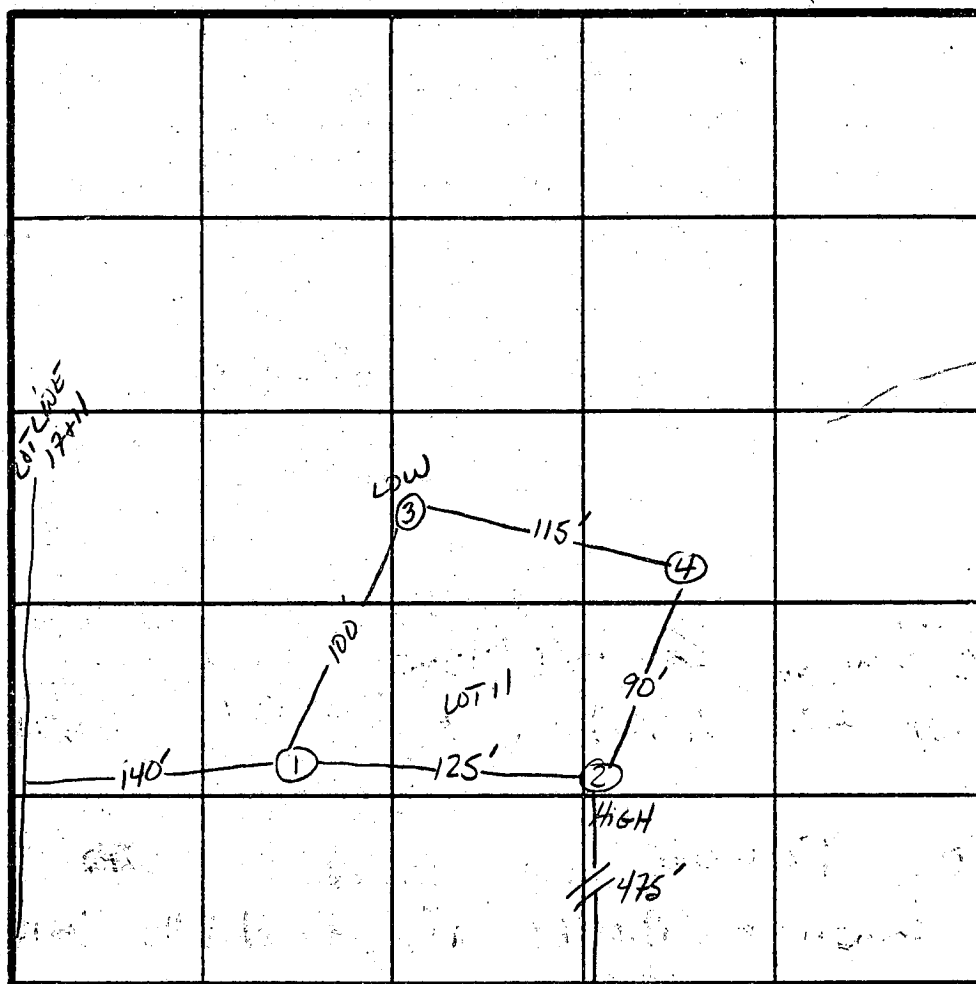

4.190
230
9.50
350
47.5

INDICATE NORTH - NAME ADJOINING ROADWAY AS BASE LINE.
HALL SHOP Rd.

DATE	TEST NO.	DEPTH	PRE-WET		TEST - 1" DROP		TIME
			START	STOP	START	STOP	
3/27/85	1S 1V 12.5'	4'	10:20	10:23	10:23	10:28	5min
	2S 2V	3.5' 12.5'	10:24	10:27	10:27	10:34	7min
	3S 3V	4' 13'	10:31	10:33	10:33	10:38	5min
	4S 4V	4' 13'	10:34	10:36	10:36	10:38	2min

REMARKS _____

TYPE OF SOIL _____

TESTED BY S. Abel ALSO PRESENT Skip, Terry - BACKHOE

EH-12-1079

APPLICATION

SEWAGE DISPOSAL TESTING

STATE OF MARYLAND - DEPARTMENT OF HEALTH AND MENTAL HYGIENE

A 33681

P _____

HOWARD COUNTY HEALTH DEPARTMENT
ENVIRONMENTAL HEALTH SERVICES

P. O. BOX 476 ELLICOTT CITY, MARYLAND 21043
TELEPHONE: 992-2330

DISTRICT 5

DATE 3/12/54

TO: THE COUNTY HEALTH OFFICER
ELLICOTT CITY, MARYLAND

I. HEREBY. APPLY FOR THE NECESSARY TEST IN ORDER TO CONSTRUCT (OR RECONSTRUCT) A SEWAGE DISPOSAL SYSTEM.

PROPERTY OWNER Edwin G. Wilson

ADDRESS Box 32 Ashton Md 20861 PHONE 854 0300

PROPERTY LOCATION:

SUBDIVISION Fox Pause LOT NO. 11

ROAD AND DESCRIPTION corner RT 32 & Hall's Shop Rd

SIZE OF LOT 3,04 Acre TYPE BLDG. 59/ Family 4 Bed

(NUMBER OF BEDROOMS)

THE SYSTEM INSTALLED UNDER THIS APPLICATION IS ACCEPTABLE ONLY UNTIL PUBLIC FACILITIES BECOME AVAILABLE. I FULLY UNDERSTAND THE FEE CONNECTED WITH THE FILING OF THIS PERC TEST APPLICATION IS NON-REFUNDABLE UNDER ANY CIRCUMSTANCES. I ALSO AGREE TO COMPLY WITH ALL M.O.S.H.A. REQUIREMENTS IN TESTING THIS LOT. Edwin G. Wilson

(SIGNATURE OF APPLICANT)

APPROVED BY _____ FOR _____ DATE _____

REJECTED BY _____ FOR _____ DATE _____

HOLD PENDING FURTHER TESTS _____ DATE _____


REASONS FOR REJECTION OR HOLDING _____

THIS IS NOT A PERMIT

LOT NEW 10-

SEE PLAT 16

3
SOIL PROFILE
0 BROWN CLAY
3
PURPLE BROWN SAND LOAM
13

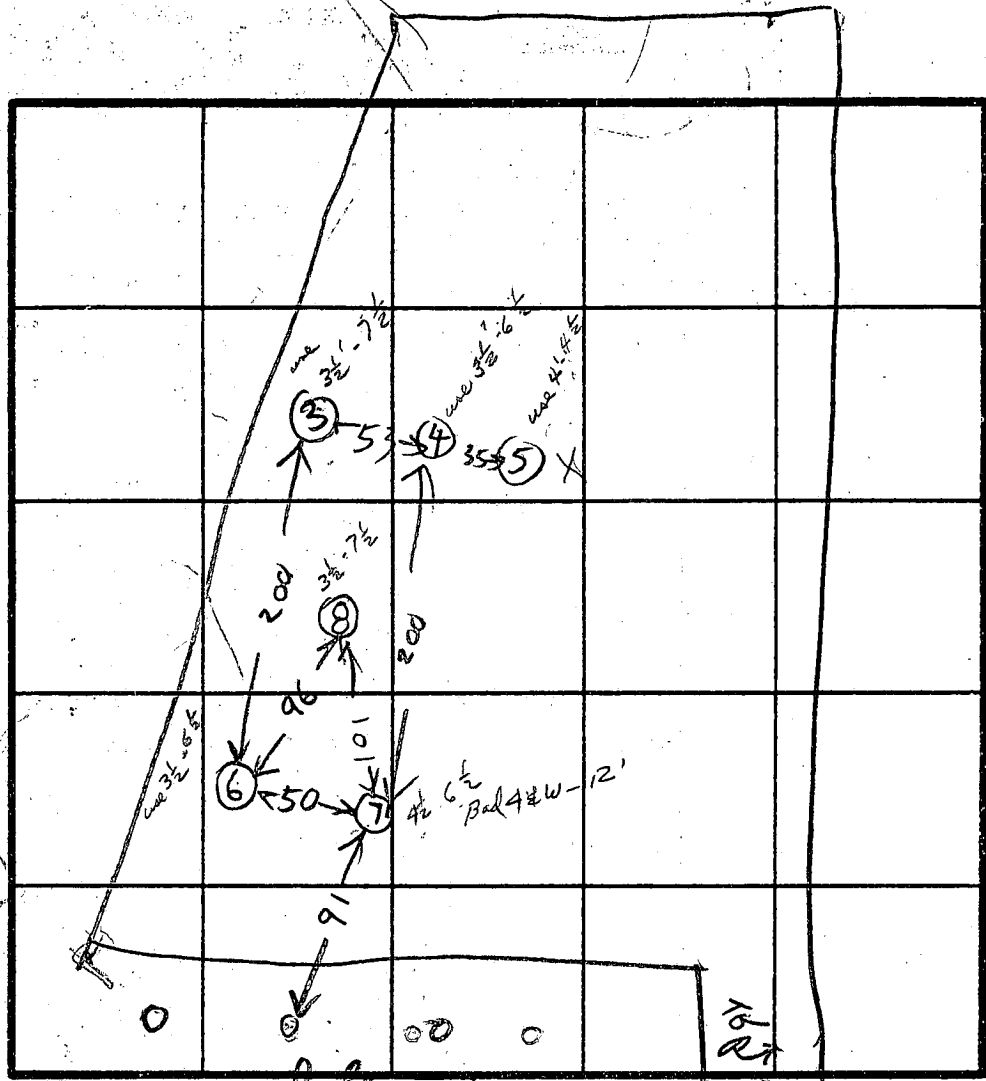

0 BROWN CLAY
3
PURPLE SAND LOAM
12

3
BROWN CLAY
3
PURPLE SAND LOAM
13

4
BROWN CLAY
3
PURPLE BROWN SAND LOAM
12
12 1/2

5
RED BROWN CLAY
4
PURPLE SAND LOAM
10
10 1/2

7
RED CLAY LOAM
4
BROWN & PINK SAND CLAY LOAM
12
12 1/2 WATER

DATE	TEST NO.	DEPTH	PRE-WET		TEST 1" DROP		TIME
			START	STOP	START	STOP	
4/27/84	1V	14	WATER		8 FT.	on old 11	
11/11	2V	14	WATER		8 FT.	on old 11	
	3 S	4	145	149	149	159	10.
	3 D	8	145	149	149	155	6
	3 V	13	LOOKS OK				
	4 S	4	150	155	155	205	10
	4 V	12 1/2	WATER		12 FT.		
	5 V	10 1/2	WATER		10 FT.		
	6 S	3	217	227	227	257	24
	6 V	12	LOOKS OK				
	7 S	4	221	253	water pen SLOW		
	7 V	12 1/2	WATER		12 FT UNSAT		
4/27/84	8 V	13	LOOKS OK				

REMARKS

TYPE OF SOIL

TESTED BY

R. HODGES

FUCK LARRY SKIP

ALSO PRESENT

EH-12-1079