

ISSUE DATE: _____

APPROVAL DATE: _____

PERMIT INDEXED

P 518560-D

A re-indexed

ON-SITE SEWAGE DISPOSAL SYSTEM HOWARD COUNTY HEALTH DEPARTMENT BUREAU OF ENVIRONMENTAL HEALTH

04-321278

IS PERMITTED TO INSTALL ALTER

ADDRESS: _____ PHONE NUMBER: _____

SUBDIVISION: _____ LOT NUMBER: _____

ADDRESS: 2322 Millers Mill PROPERTY OWNER: James Lee

SEPTIC TANK CAPACITY (GALLONS): _____

PUMP CHAMBER CAPACITY (GALLONS): _____

NUMBER OF BEDROOMS: _____

SQUARE FEET PER BEDROOM: _____

LINEAR FEET OF TRENCH REQUIRED: _____

TRENCHES:	Trench to be _____ feet wide. Inlet _____ feet below original grade. Bottom maximum depth _____ feet below original grade. Effective area begins at _____ feet below original grade. _____ feet of stone below distribution pipe.
LOCATION:	_____
PURPOSE:	_____

PLANS APPROVED: _____ DATE: _____

NOTE: PERMIT VOID AFTER 2 YEARS

NOTE: CONTRACTOR RESPONSIBLE FOR SCHEDULING A PRE-CONSTRUCTION INSPECTION FOR ALL INSTALLATIONS

NOTE: WATERTIGHT SEPTIC TANKS REQUIRED

NOTE: ALL PARTS OF SEPTIC SYSTEM SHALL BE 100 FEET FROM ANY WATER WELL

NOTE: MANHOLE RISERS REQUIRED ON ALL SEPTIC TANKS AND PUMP CHAMBERS

**NEITHER THE HOWARD COUNTY COUNCIL NOR THE HEALTH DEPARTMENT IS
RESPONSIBLE FOR THE SUCCESSFUL OPERATION OF ANY SYSTEM
PERMITTEE RESPONSIBLE FOR OBTAINING FINAL APPROVAL ON THIS PERMIT
CALL 410-313-2640 FOR INSPECTION OF SEPTIC SYSTEM**

P518560-D

PERMIT

SEWAGE DISPOSAL SYSTEM

MARYLAND STATE DEPARTMENT OF HEALTH

HOWARD COUNTY

ELLICOTT CITY

INDEXED

DISTRICT 4

DATE 8/16/74

P 15148

A 15142

Burgmeister-Dell IS PERMITTED TO INSTALL ALTER

SS Beltsford, Maryland PHONE _____

AGE DISPOSAL SYSTEM LOCATED AT _____

VISION _____ ROAD 2322 Miller's Mill (see application for better directions) LOT _____

PROPERTY OWNER James Lee

ADDRESS 1108 Presbury Street, Baltimore, Md.

REQUIREMENTS - 3 bedrooms

DRAIN FIELD _____ DEPTH _____ FEET. BOTTOM AREA _____ SQ. FT.

SEEPAGE PITS _____ ABSORBENT SIDE-WALL AREA _____ SQ. FT.

SEPTIC TANK CAPACITY 1,000 GALLONS

FOR GARBAGE GRINDER, INCREASE DISPOSAL AREA 22% & TANK CAPACITY 80%.

OTHER Dry well 429 sq. ft. sidewall area below inlet. Inlet no deeper than 4 ft.

Bottom of dry well no deeper than 12 ft. Place dry well 120 ft. from edge of Miller's

road and 200 ft. from edge of the private drive located along the right side of the

as seen when facing the lot from Miller's Mill Road.

ALL PIPE FROM HOUSE TO DRY WELL MUST BE CAST IRON.

IT VOID AFTER THREE YEARS.

INSTALL STAND PIPE ON SEPTIC TANK AND DRY WELL.


IS APPROVED BY Raymond Hodges DATE 8/3/72

SEPTIC TANK AND DISTRIBUTION BOX WITH WATER BEFORE CALLING FOR AN INSPECTION. COVER NO WORK UNLESS INSPECTED AND APPROVED

NEITHER THE HOWARD COUNTY COMMISSIONERS NOR THE HEALTH DEPARTMENT IS RESPONSIBLE FOR THE SUCCESSFUL OPERATION OF ANY SYSTEM.

A 1514

2705

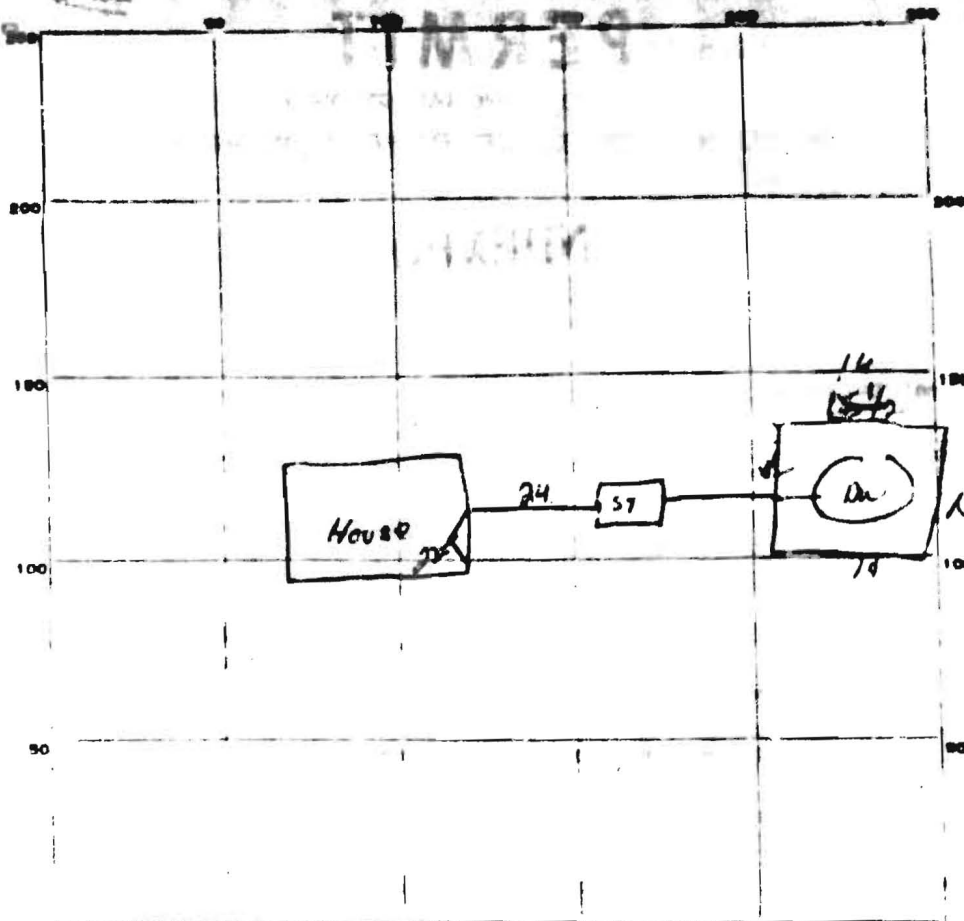

INDICATE NORTH - NAME ADJOINING ROADWAY AS BASE LINE
Mellie Mull Lane

PERMIT CARD 012

SEPTIC TANK LEVEL 012

CLEANOUTS d 12

DISTRIBUTION BOX LEVEL _____

FIELD DEPTH _____ FT. TRENCH WIDTH _____ FT.

GRAVEL DEPTH _____ IN. TOTAL LENGTH _____ FT.

NUMBER OF TRENCHES _____ TOTAL BOTTOM AREA _____

PERIMETER _____
 PAGE FITS. INSIDE DIAMETER 58 FT. DEPTH BELOW INLET 7 FT.

ABSORBENT AREA 406 SQ. FT.

MARKS _____

