

# APPLICATION

SEWAGE DISPOSAL TESTING

A 15162

P \_\_\_\_\_

MARYLAND STATE DEPARTMENT OF HEALTH

HOWARD COUNTY

ELLICOTT CITY

DISTRICT 4

DATE 8/9/70

THE COUNTY HEALTH OFFICER  
ELLICOTT CITY, MARYLAND

I, HEREBY, APPLY FOR THE NECESSARY TESTS IN ORDER TO CONSTRUCT OR RECONSTRUCT A SEWAGE DISPOSAL SYSTEM.

PROPERTY OWNER Miss Theresa H. Parker

ADDRESS 8505 Springvale Road, Silver Spring, Md. PHONE 301-589-5815

PROPERTY LOCATION:

DIVISION \_\_\_\_\_ LOT NO. \_\_\_\_\_

ROAD AND DESCRIPTION Miller's Mill Road - Use Rt. 97 and - 1st house on left  
pass  
continue on to the sharp curve and the land is to your left  
all clear land. Mark with a red flag

OCCUPANT \_\_\_\_\_ PHONE \_\_\_\_\_

PERSON TO CONSTRUCT SYSTEM \_\_\_\_\_

ADDRESS \_\_\_\_\_ PHONE \_\_\_\_\_

SIZE OF LOT 3.534 acres TYPE BLOG 3 of 4

NOT SINGLE RESIDENCE DESCRIBE \_\_\_\_\_  
*(Single Family Property)*

SIGNATURE OF APPLICANT Theresa H. Parker

APPROVED BY \_\_\_\_\_ FOR \_\_\_\_\_ DATE \_\_\_\_\_  
(NAME OF SYSTEM)

REJECTED BY \_\_\_\_\_ FOR \_\_\_\_\_ DATE \_\_\_\_\_  
(NAME OF SYSTEM)


OLD PENDING FURTHER TESTS \_\_\_\_\_ DATE \_\_\_\_\_

REASONS FOR REJECTION OR HOLDING \_\_\_\_\_

# APPLICATION

SEWERAGE AND WATERWORKS DEPARTMENT  
MARYLAND STATE DEPARTMENT

*attached  
right  
hole*

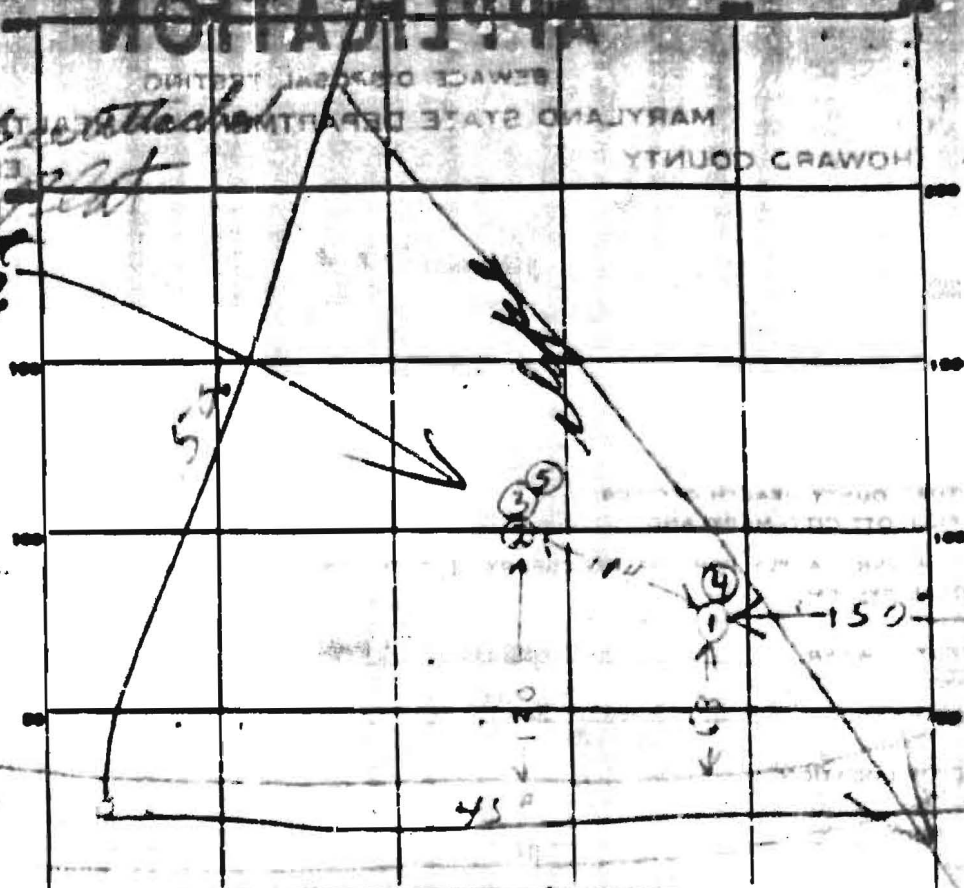

INCREASE 1/4" DIA. - HOME ADDRESS ROADWAY AS GAGE LINE.

DATE	TEST NO.	DEPTH	PRE-TEST		TEST - 1" DROP		TIME
			START	STOP	START	STOP	
2/2/72	1		1115	1120	1120	1130	10
	2		1144	1215	dirt falls		
	3	5 1/2	1154	1206	1206	1202	6
	4	6 1/2	1220	1225	1225	1230	5
	5	7	1235	1250	about 1/2 inch to 15		
	5	8	105	109	109	114	5

SOIL AUGER FINDING

TESTED BY *B. C. Jones*

6577

650