

PUB. SEWER STATUS VERIFIED BY KN / N.A.

ISSUE DATE: 5/2/2003
APPROVAL DATE: _____

PERMIT

INDEXED

P 518650-B
A REPAIR

ON-SITE SEWAGE DISPOSAL SYSTEM HOWARD COUNTY HEALTH DEPARTMENT BUREAU OF ENVIRONMENTAL HEALTH

04-310152

Jack Fyock Septic Service IS PERMITTED TO INSTALL ALTER

ADDRESS: PO Box 89, Glenelg, MD 21737 PHONE NUMBER: 410-988-9270

SUBDIVISION: _____ LOT NUMBER: _____

ADDRESS: 14250 Burntwoods Road PROPERTY OWNER: Karen Compton

SEPTIC TANK CAPACITY (GALLONS): Existing 750 410-489-5734

PUMP CHAMBER CAPACITY (GALLONS): N/A

NUMBER OF BEDROOMS: 4 (3 existing) 1 proposed in future

SQUARE FEET PER BEDROOM: NA

LINEAR FEET OF TRENCH REQUIRED: Existing trench

TRENCHES: <u>N/A</u>	Trench to be _____ feet wide. Inlet _____ feet below original grade. Bottom maximum depth _____ feet below original grade. Effective area begins at _____ feet below original grade. _____ feet of stone below distribution pipe.
LOCATION:	<u>It appears a repair may have been done in recent past. NEED to upgrade S.T. to at least 21250 gallon.</u>
PURPOSE:	In support of building permit. Call for inspection when ground is opened so sanitarian can recommend repair.

PLANS APPROVED: (KN) DATE: 5-7-03
5/2/2003

- NOTE: PERMIT VOID AFTER 2 YEARS
- NOTE: CONTRACTOR RESPONSIBLE FOR SCHEDULING A PRE-CONSTRUCTION INSPECTION FOR ALL INSTALLATIONS
- NOTE: WATERTIGHT SEPTIC TANKS REQUIRED
- NOTE: ALL PARTS OF SEPTIC SYSTEM SHALL BE 100 FEET FROM ANY WATER WELL
- NOTE: MANHOLE RISERS REQUIRED ON ALL SEPTIC TANKS AND PUMP CHAMBERS


NEITHER THE HOWARD COUNTY COUNCIL NOR THE HEALTH DEPARTMENT IS RESPONSIBLE FOR THE SUCCESSFUL OPERATION OF ANY SYSTEM PERMITTEE RESPONSIBLE FOR OBTAINING FINAL APPROVAL ON THIS PERMIT CALL 410-313-2640 FOR INSPECTION OF SEPTIC SYSTEM

P518650-B

WOODS

NOT TO SCALE

o-Ex well, no tag

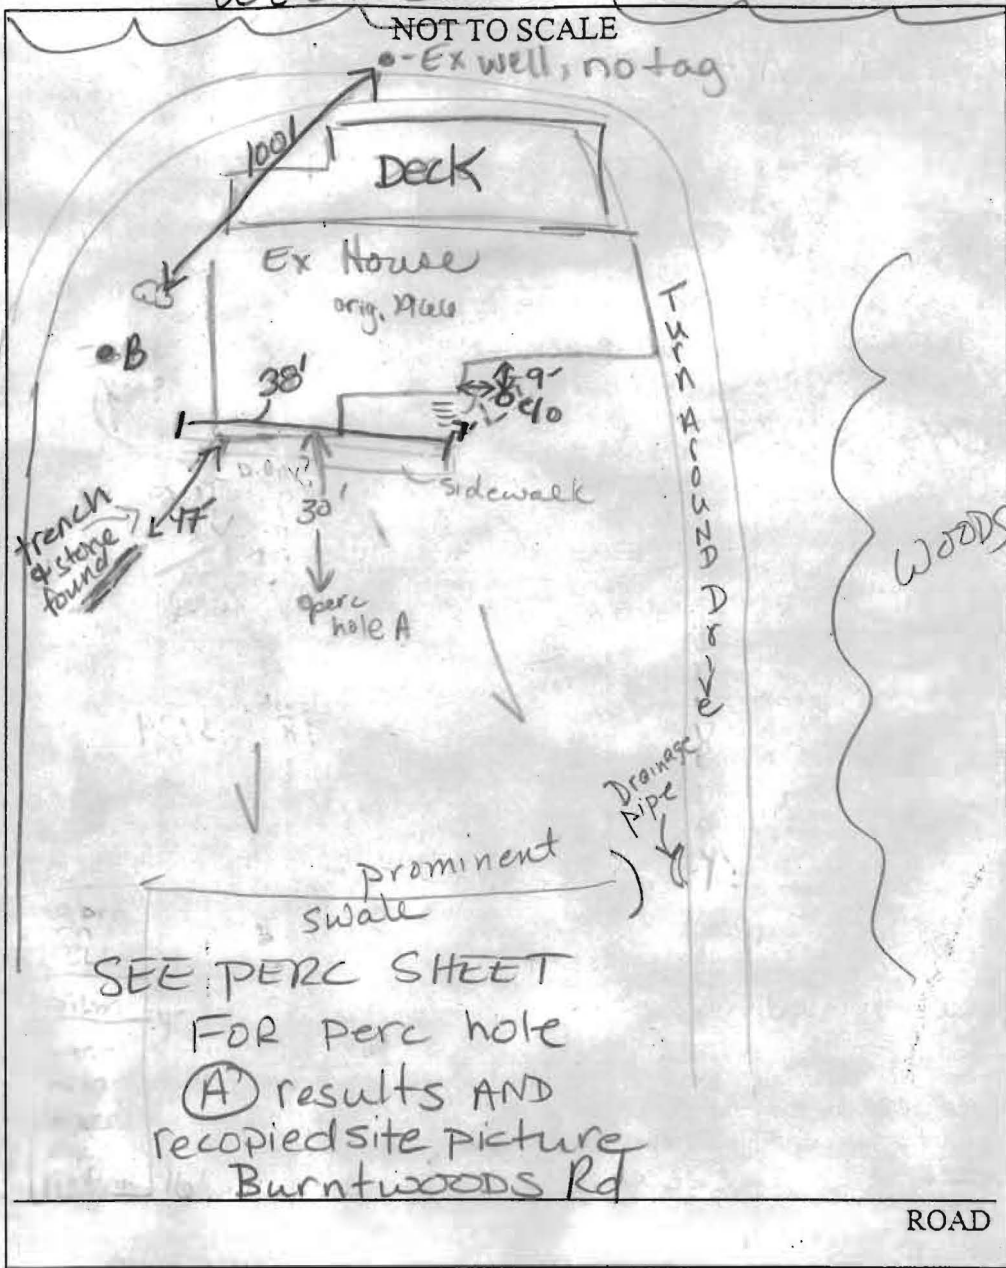

SEE PERC SHEET
FOR perc hole
(A) results AND
recopied site picture
Burntwoods Rd

TRENCH/DRAINFIELD DATA		
WIDTH	INLET	BOTTOM
_____	_____	_____
NUMBER OF TRENCHES _____		
TOTAL LENGTH _____		
ABSORPTION AREA _____		
DISTRIBUTION BOX LEVEL _____		
DISTRIBUTION BOX BAFFLE _____		
DISTRIBUTION BOX PORT _____		

SEPTIC TANK DATA	
SEPTIC TANK 1 LEVEL _____	
CAPACITY _____	GAL
SEAM LOC _____	
TANK LID DEPTH _____	
BAFFLES _____	
BAFFLE FILTER _____	
MANHOLE LOC _____	
6" PORT LOC _____	
WATERTIGHT TEST _____	
SEPTIC TANK 2 LEVEL _____	
CAPACITY _____	GAL
SEAM LOC _____	
TANK LID DEPTH _____	
BAFFLES _____	
BAFFLE FILTER _____	
MANHOLE LOC _____	
6" PORT LOC _____	
WATERTIGHT TEST _____	

PRE-CONSTRUCTION (A) 4 1/2 M / 110' V 9:13⁴⁵ 9:15³⁵ 9:22 7min

beautiful soil. Hole B - No TRENCH Present. Trenches appear fairly

INSTALLATION new. Replace S.T. due to difficulty tying in another tank. Install at least 1250 gallon S.Tank and tie into existing system. Owner said repair maybe in 6 mo. (KN)

It appears the old records are A11854 since the age of the house & 1/2 mi location from the high school. Because the trench seemed hardly used, a repair may have been done without a permit. (KN) 10/6/03 Called Fyock - no septic tank size ↑. Hold permit until S.T. replaced. (KN)

FINAL INSPECTOR _____ DATE OF APPROVAL _____