

AFTER COMPLETION OF THE WELL

WELL COMPLETION REPORT

WELL DESCRIPTION

WELL LOG
the kind of formations penetrated, their depth, their thickness, and if water-bearing

CASING AND SCREEN RECORD
State the kind and size and position of casing, liner, shoe, screen, and other accessories (if no casing used, give diameter of well).

	FEET		DIAM (inches)	FEET	
	from	to		from	to
Top of soil	0	0	Steel 6 1/2" OD	0	32
Sandy	0	3.25			
and rock	3.25	25.50			
very much	25.50	50.120			
water	50				

Permit Number Well No. 70
 Owner George L. Smith
 Address _____
 Subdivision _____
 Section _____ Lot _____


PUMPING TEST
 Hours Pumped _____
 Type of Pump Used Electric
 Pumping Rate _____
 Gallons per Minute 40

WATER LEVEL
 (State on lead string is used)
 Before Pumping 40 Ft.
 When Pumping 120 Ft.

APPEARANCE OF WATER
 Color Clear Cloudy _____
 Taste _____
 Odor _____
 Height of Casing Above Land _____

PUMP INSTALLED
 Type _____
 Capacity _____
 Gallons per Minute _____
 Gallons per Hour _____
 Pump Casing Length _____ Ft.

LOCATION OF WELL ON LOT
 Show permanent structures such as buildings, septic tank, and/or other landmarks and indicate not less than 7 distances (measurements) to well.

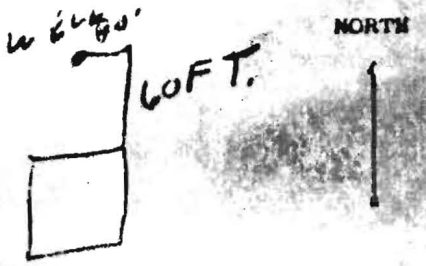

I hereby affirm that this report contains no willful misrepresentations or falsifications and that information given in this report is true, accurate and complete to the best of my knowledge and belief.

J. F. Eastman, Well Driller
 Well Driller License No. 70

WAS
 LETED
 ✓
 11-66