

MARYLAND STATE DEPARTMENT OF HEALTH

HOWARD COUNTY

ELLCOTT CITY

DISTRICT 1

DATE 5/22/66

*Septic Tank 250 gallons
Dry well 324 sq ft absorbent sidewall
over below 2 1/2 inch pipe, located 135 ft from
front lot line and 10 1/2 ft from right side lot
line as seen when facing lot from Burntwoods
Rd.*

?

#11854

TO: THE COUNTY HEALTH OFFICER
ELLCOTT CITY, MARYLAND

I, HEREBY, APPLY FOR THE NECESSARY TESTS IN ORDER TO CONSTRUCT OR RECONSTRUCT A SEWAGE
DISPOSAL SYSTEM

PROPERTY OWNER George H. Forrester & Elizabeth A.

ADDRESS Burnt Woods Rd., Glenwood, Md. PHONE 301 9-1871

PROPERTY LOCATION:

SUBDIVISION _____ LOT NO. _____

ROAD AND DESCRIPTION Using Rt. 32
Burnt Woods Rd. - 1/4 mile past Glen High School on right
side - wooded area - between brown and white
fence - sign says "ONE MILE"

OCCUPANT _____ PHONE _____

PERSON TO CONSTRUCT SYSTEM _____

ADDRESS _____ PHONE _____

SIZE OF LOT 1.975 ACRES TYPE RES NUMBER OF RESIDERS _____

IF NOT SINGLE RESIDENCE DESCRIBE _____

SIGNATURE OF APPLICANT George O. Forrester


APPROVED BY J.H. Kuhn FOR Dry well DATE 6/1/66

REJECTED BY _____ FOR _____ DATE _____

HOLD PENDING FURTHER TESTS _____ DATE _____

REASONS FOR REJECTION OR HOLDING _____

THIS IS NOT A PERMIT

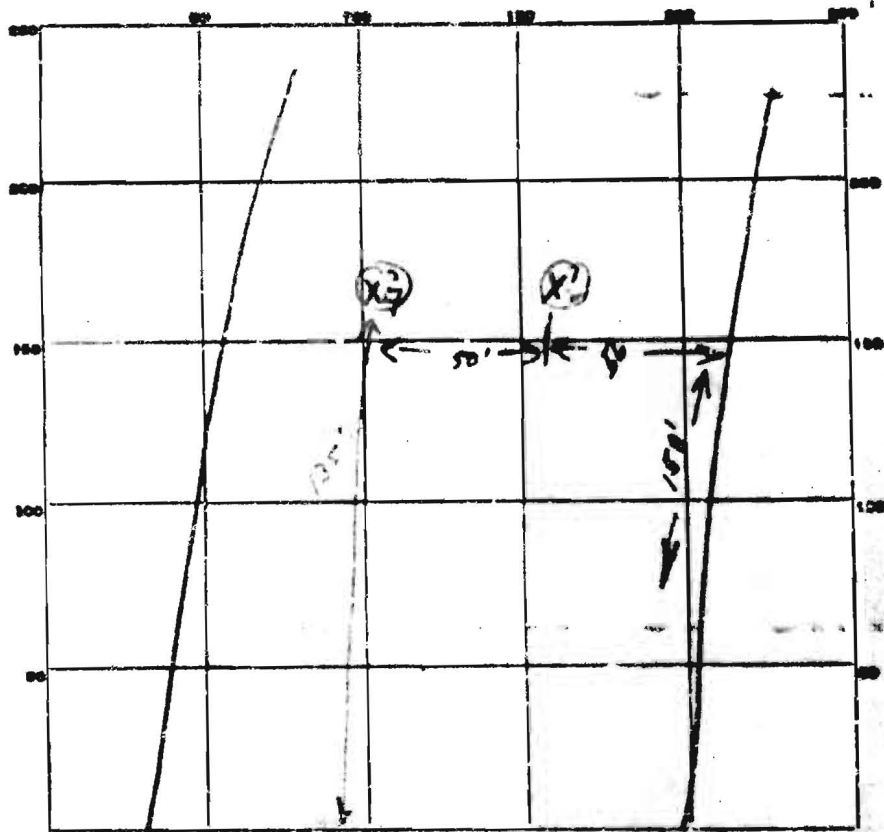

INDICATE NORTH - NAME ADJOINING ROADWAY AS BASE LINE

BURNTHOOD RD

DATE	TEST NO.	DEPTH	PRE-WET		TEST - 1' DROP		TIME
			START	STOP	START	STOP	
6-1-66	1	8'9"	9:54	9:55	9:55	10:00	5 min
	2	8'5"	9:55 1/2	9:59 1/2	9:59 1/2	10:08 1/2	9 min
	3	9'	10:04	10:05	10:05	10:09	4 min
	4	5'	10:05 1/2	10:11 1/2	10:11 1/2	10:21 1/2	10 min

SOIL AUGER FINDING _____

TESTED BY: JHK + FF

REMARKS _____