

# APPLICATION

A 25703

## SEWAGE DISPOSAL TESTING

P \_\_\_\_\_

STATE OF MARYLAND - DEPARTMENT OF HEALTH AND MENTAL HYGIENE

HOWARD COUNTY HEALTH DEPARTMENT  
ENVIRONMENTAL HEALTH SERVICES  
P. O. BOX 476, ELLICOTT CITY, MARYLAND 21043  
TELEPHONE: 465-5000, EXT. 356

DISTRICT 3rd

DATE 4/22/77

*Rodney Dize*

TO: THE COUNTY HEALTH OFFICER  
ELLICOTT CITY, MARYLAND

I, HEREBY, APPLY FOR THE NECESSARY TEST IN ORDER TO CONSTRUCT (OR RECONSTRUCT) A SEWAGE DISPOSAL SYSTEM.

PROPERTY OWNER Lee R. Stirn Enterprises, Inc.

ADDRESS 11686 Old Frederick Rd., Marriottsville, Md. 21104 PHONE \_\_\_\_\_

PROPERTY LOCATION:

SUBDIVISION \_\_\_\_\_ LOT NO. 6

ROAD AND DESCRIPTION Indian Hill Drive 12455 Howard Lodge Rd.

SIZE OF LOT 5 acres more or less TYPE BLDG. 3 or 4  
NUMBER OF BEDROOMS

IF NOT SINGLE RESIDENCE DESCRIBE \_\_\_\_\_

THE SYSTEM INSTALLED UNDER THIS APPLICATION IS ACCEPTABLE ONLY UNTIL PUBLIC FACILITIES BECOME AVAILABLE.

SIGNATURE OF APPLICANT /s/ Lee Roy Stirn

BLDG. PERMIT SIGNED  
AND RETURNED 4/27/78  
*Serial No. 35557*

APPROVED BY \_\_\_\_\_ FOR \_\_\_\_\_ DATE \_\_\_\_\_  
(KIND OF SYSTEM)


REJECTED BY \_\_\_\_\_ FOR \_\_\_\_\_ DATE \_\_\_\_\_  
(KIND OF SYSTEM)

HOLD PENDING FURTHER TESTS \_\_\_\_\_ DATE \_\_\_\_\_

REASONS FOR REJECTION OR HOLDING \_\_\_\_\_

# THIS IS NOT A PERMIT

0 —  
↓ sandy  
13 loam

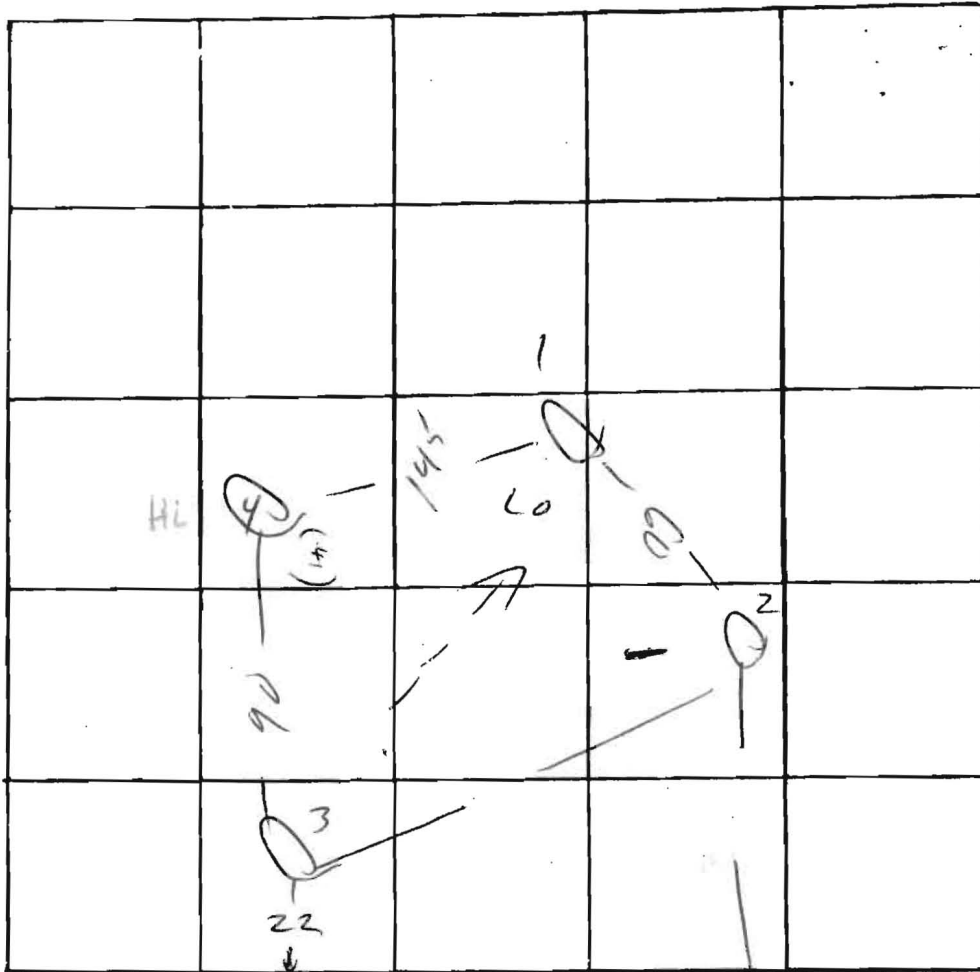

INDICATE NORTH. - NAME ADJOINING ROADWAY AS BASE LINE

Howard Lodge Rd

DATE	TEST NO.	DEPTH	PRE-WET		TEST - 1" DROP		TIME
			START	STOP	START	STOP	
15/1/77	1	2 1/2	2 50	2 52	2 52	2 57	5
	1A	13	"	"	"	2 59	7
	2	2 1/2	2 00	2 02	2 02	2 07	5
	2A	12	"	"	"	2 11	9
	3	13	vis		Same		
	4	2 1/2	2 03	2 05	2 05	2 11	6
	4A	13	2 03	2 02	2 09	2 24	13

REMARKS \_\_\_\_\_

TYPE OF SOIL sandy loam

TESTED BY M ALSO PRESENT: F York