


- ⊙ Percolation Test Hole (Field Location)
- ⊗ Well (Field Location)

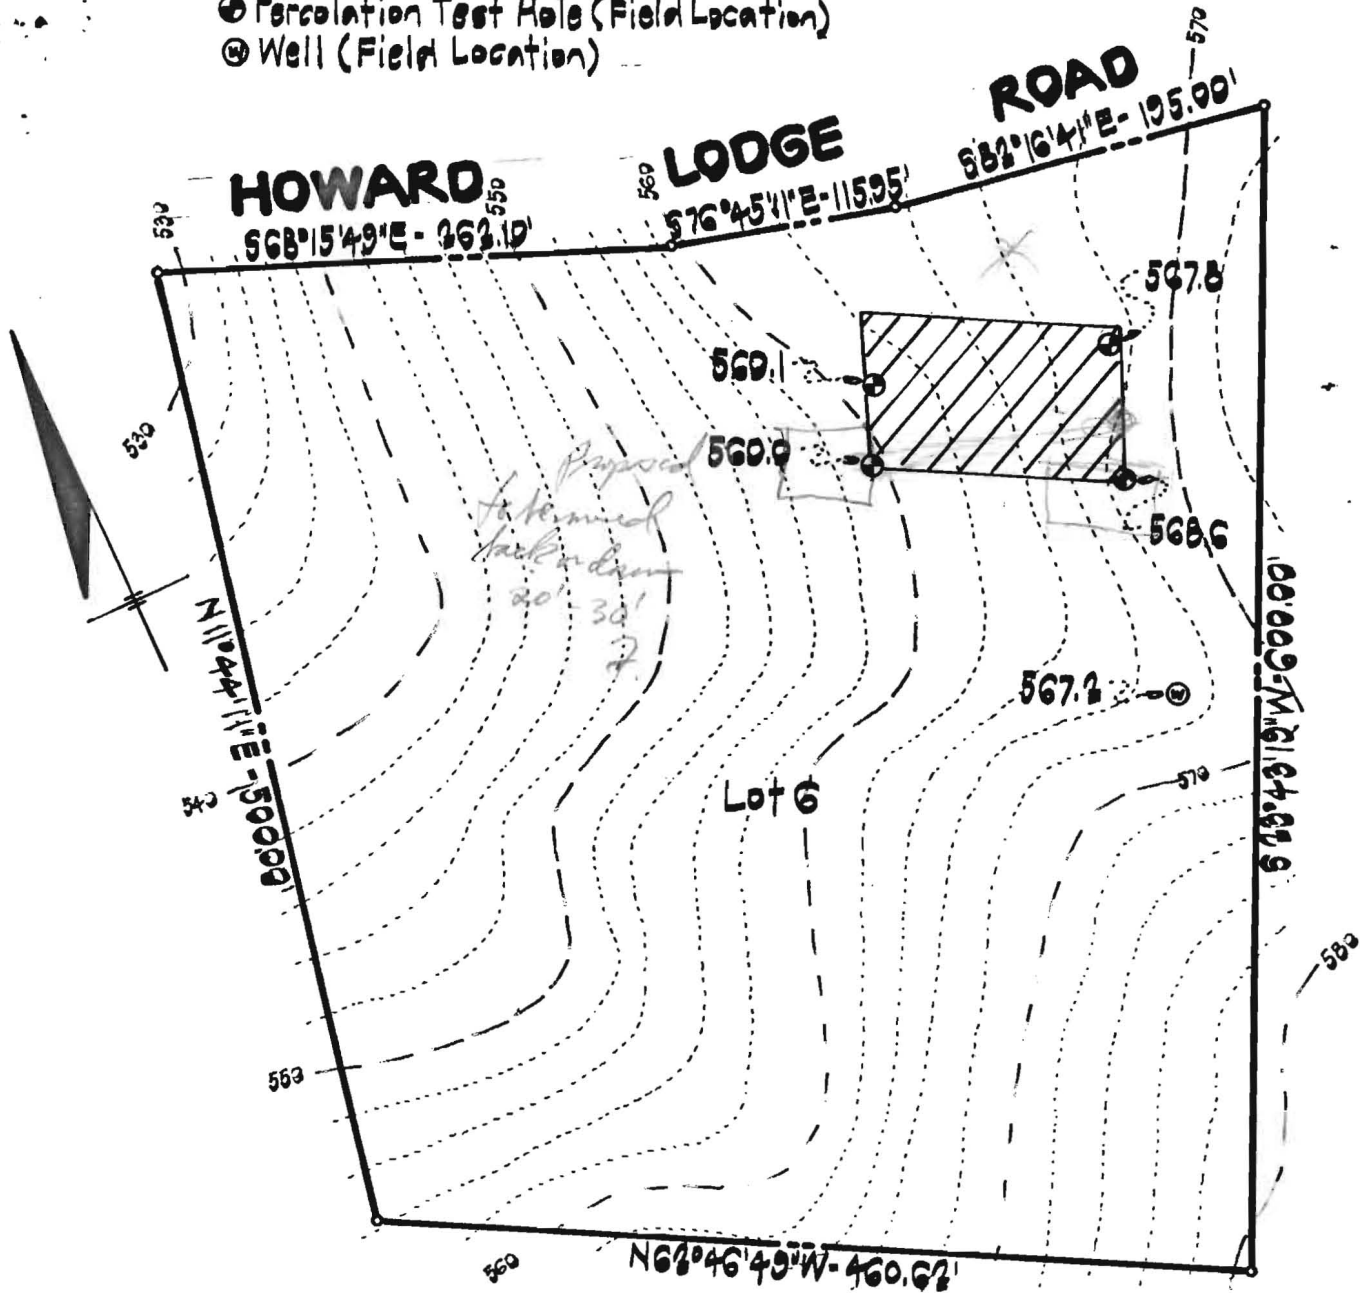

I certify that the elevations shown are true and correct for this property (field located).

Walter Park April 7, 1978
 Walter Park, Reg. No. 5599 Date

CROVO & ASSOC., INC.

CIVIL ENGINEERING
 LAND SURVEYING


8669 OAK ROAD
 BALTIMORE, MD. 21234
 301-661-9973



**PROPERTY OF
 L.R. STIRN
 ENTPR. INC.**

LOT 6
 3RD DELEG. DISTRICT HOWARD CO., MD.
 APRIL 5, 1978 SCALE 1" = 100'

- ⊙ Percolation Test Hole (Field Location)
- ⊙ Well (Field Location)

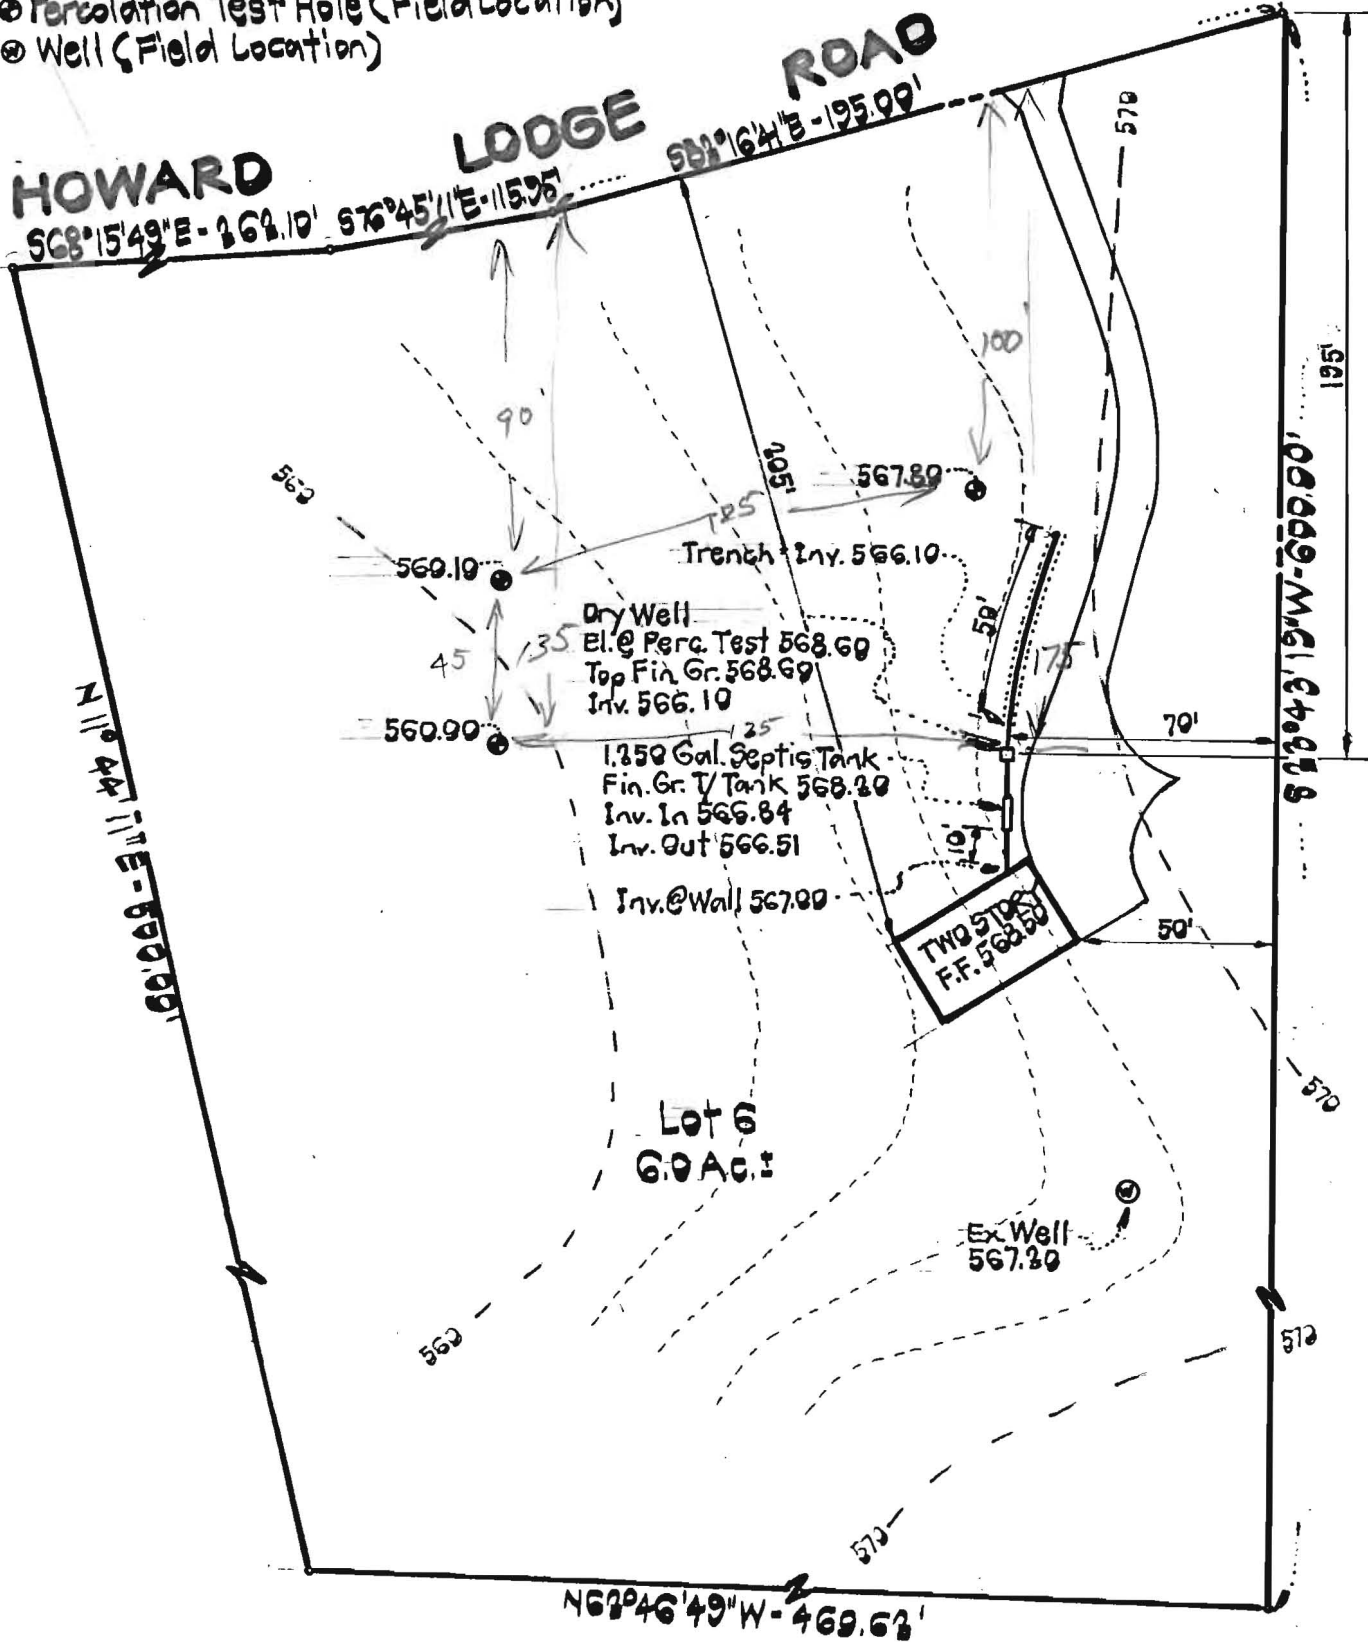

I certify that the above measurements and elevations are actual and correct for this property.

Signed: Walter Lee

CROVO & ASSOC, INC.

CIVIL ENGINEERING
 LAND SURVEYING

8669 OAK ROAD
 BALTIMORE, MD. 21234
 301-661-9373

**PROPERTY OF
 L.R. STIRN
 ENTPR. INC.**

LOT 6
 3rd BLEG. DISTRICT HOWARD CO., MD.
 APRIL 17, 1978 SCALE: 1" = 50'