

PUB. SEWER STATUS VERIFIED BY SRKN/A

ISSUE DATE: 3/12/03

P 518571

APPROVAL DATE: \_\_\_\_\_

A REPAIR

# PERMIT

## INDEXED

ON-SITE SEWAGE DISPOSAL SYSTEM  
HOWARD COUNTY HEALTH DEPARTMENT  
BUREAU OF ENVIRONMENTAL HEALTH

**03-282775**

Hatfield's Equipment IS PERMITTED TO INSTALL  ALTER

ADDRESS: 13785 Burntwoods Road PHONE NUMBER: 301-854-6172

SUBDIVISION: \_\_\_\_\_ LOT NUMBER: \_\_\_\_\_

ADDRESS: 12455 Howard Lodge Road PROPERTY OWNER: Curry

SEPTIC TANK CAPACITY (GALLONS): \_\_\_\_\_

PUMP CHAMBER CAPACITY (GALLONS): \_\_\_\_\_

NUMBER OF BEDROOMS: \_\_\_\_\_

SQUARE FEET PER BEDROOM: \_\_\_\_\_

LINEAR FEET OF TRENCH REQUIRED: \_\_\_\_\_

TRENCHES:	Trench to be _____ feet wide. Inlet _____ feet below original grade. Bottom maximum depth _____ feet below original grade. Effective area begins at _____ feet below original grade. _____ feet of stone below distribution pipe.
LOCATION:	_____
PURPOSE:	In support of building permit addition.

PLANS APPROVED: Steven R. Krieg DATE: \_\_\_\_\_

- NOTE: PERMIT VOID AFTER 2 YEARS
- NOTE: CONTRACTOR RESPONSIBLE FOR SCHEDULING A PRE-CONSTRUCTION INSPECTION FOR ALL INSTALLATIONS
- NOTE: WATERTIGHT SEPTIC TANKS REQUIRED
- NOTE: ALL PARTS OF SEPTIC SYSTEM SHALL BE 100 FEET FROM ANY WATER WELL
- NOTE: MANHOLE RISERS REQUIRED ON ALL SEPTIC TANKS AND PUMP CHAMBERS

NEITHER THE HOWARD COUNTY COUNCIL NOR THE HEALTH DEPARTMENT IS RESPONSIBLE FOR THE SUCCESSFUL OPERATION OF ANY SYSTEM  
**PERMITTEE RESPONSIBLE FOR OBTAINING FINAL APPROVAL ON THIS PERMIT**  
**BUILDING PERMITS SIGNED AND RETURNED**  
CALL 410-313-2640 FOR INSPECTION OF SEPTIC SYSTEM

3-12-03 800140418-4 STALL BAYON  
4/27/06 800159218-IG POOL

518571

NOT TO SCALE

**TRENCH/DRAINFIELD DATA**

WIDTH \_\_\_\_\_ INLET \_\_\_\_\_ BOTTOM \_\_\_\_\_

NUMBER OF TRENCHES \_\_\_\_\_

TOTAL LENGTH \_\_\_\_\_

ABSORPTION AREA \_\_\_\_\_

DISTRIBUTION BOX LEVEL \_\_\_\_\_

DISTRIBUTION BOX BAFFLE \_\_\_\_\_

DISTRIBUTION BOX PORT \_\_\_\_\_

**SEPTIC TANK DATA**

SEPTIC TANK 1 LEVEL \_\_\_\_\_

CAPACITY \_\_\_\_\_ GAL

SEAM LOC \_\_\_\_\_

TANK LID DEPTH \_\_\_\_\_

BAFFLES \_\_\_\_\_

BAFFLE FILTER \_\_\_\_\_

MANHOLE LOC \_\_\_\_\_

6" PORT LOC \_\_\_\_\_

WATERTIGHT TEST \_\_\_\_\_

SEPTIC TANK 2 LEVEL \_\_\_\_\_

CAPACITY \_\_\_\_\_ GAL

SEAM LOC \_\_\_\_\_

TANK LID DEPTH \_\_\_\_\_

BAFFLES \_\_\_\_\_

BAFFLE FILTER \_\_\_\_\_

MANHOLE LOC \_\_\_\_\_

6" PORT LOC \_\_\_\_\_

WATERTIGHT TEST \_\_\_\_\_


ROAD

PRE-CONSTRUCTION 3/17/03 - MET W/HATFIELDS, DISCUSSED OPTION OF INSTALLING & CONN. NEW S.T. W/PUMP TO EX. SEPTIC SYSTEM, WILL FOLLOW UP LATER - (SRK)  
FOR DETACHED GAR. PRIOR TO EX SEPTIC TANK

INSTALLATION 5/8/03 - PER STEVE GRIFFIN (BUILDER) HOMEOWNERS RAN OUT OF \$ & WILL NOT PROCEED W/ GARAGE REMODELING AT THIS TIME - (SRK)

BUILDING PERMIT SIGNED  
AND RETURNED

FINAL INSPECTOR \_\_\_\_\_ DATE OF APPROVAL \_\_\_\_\_

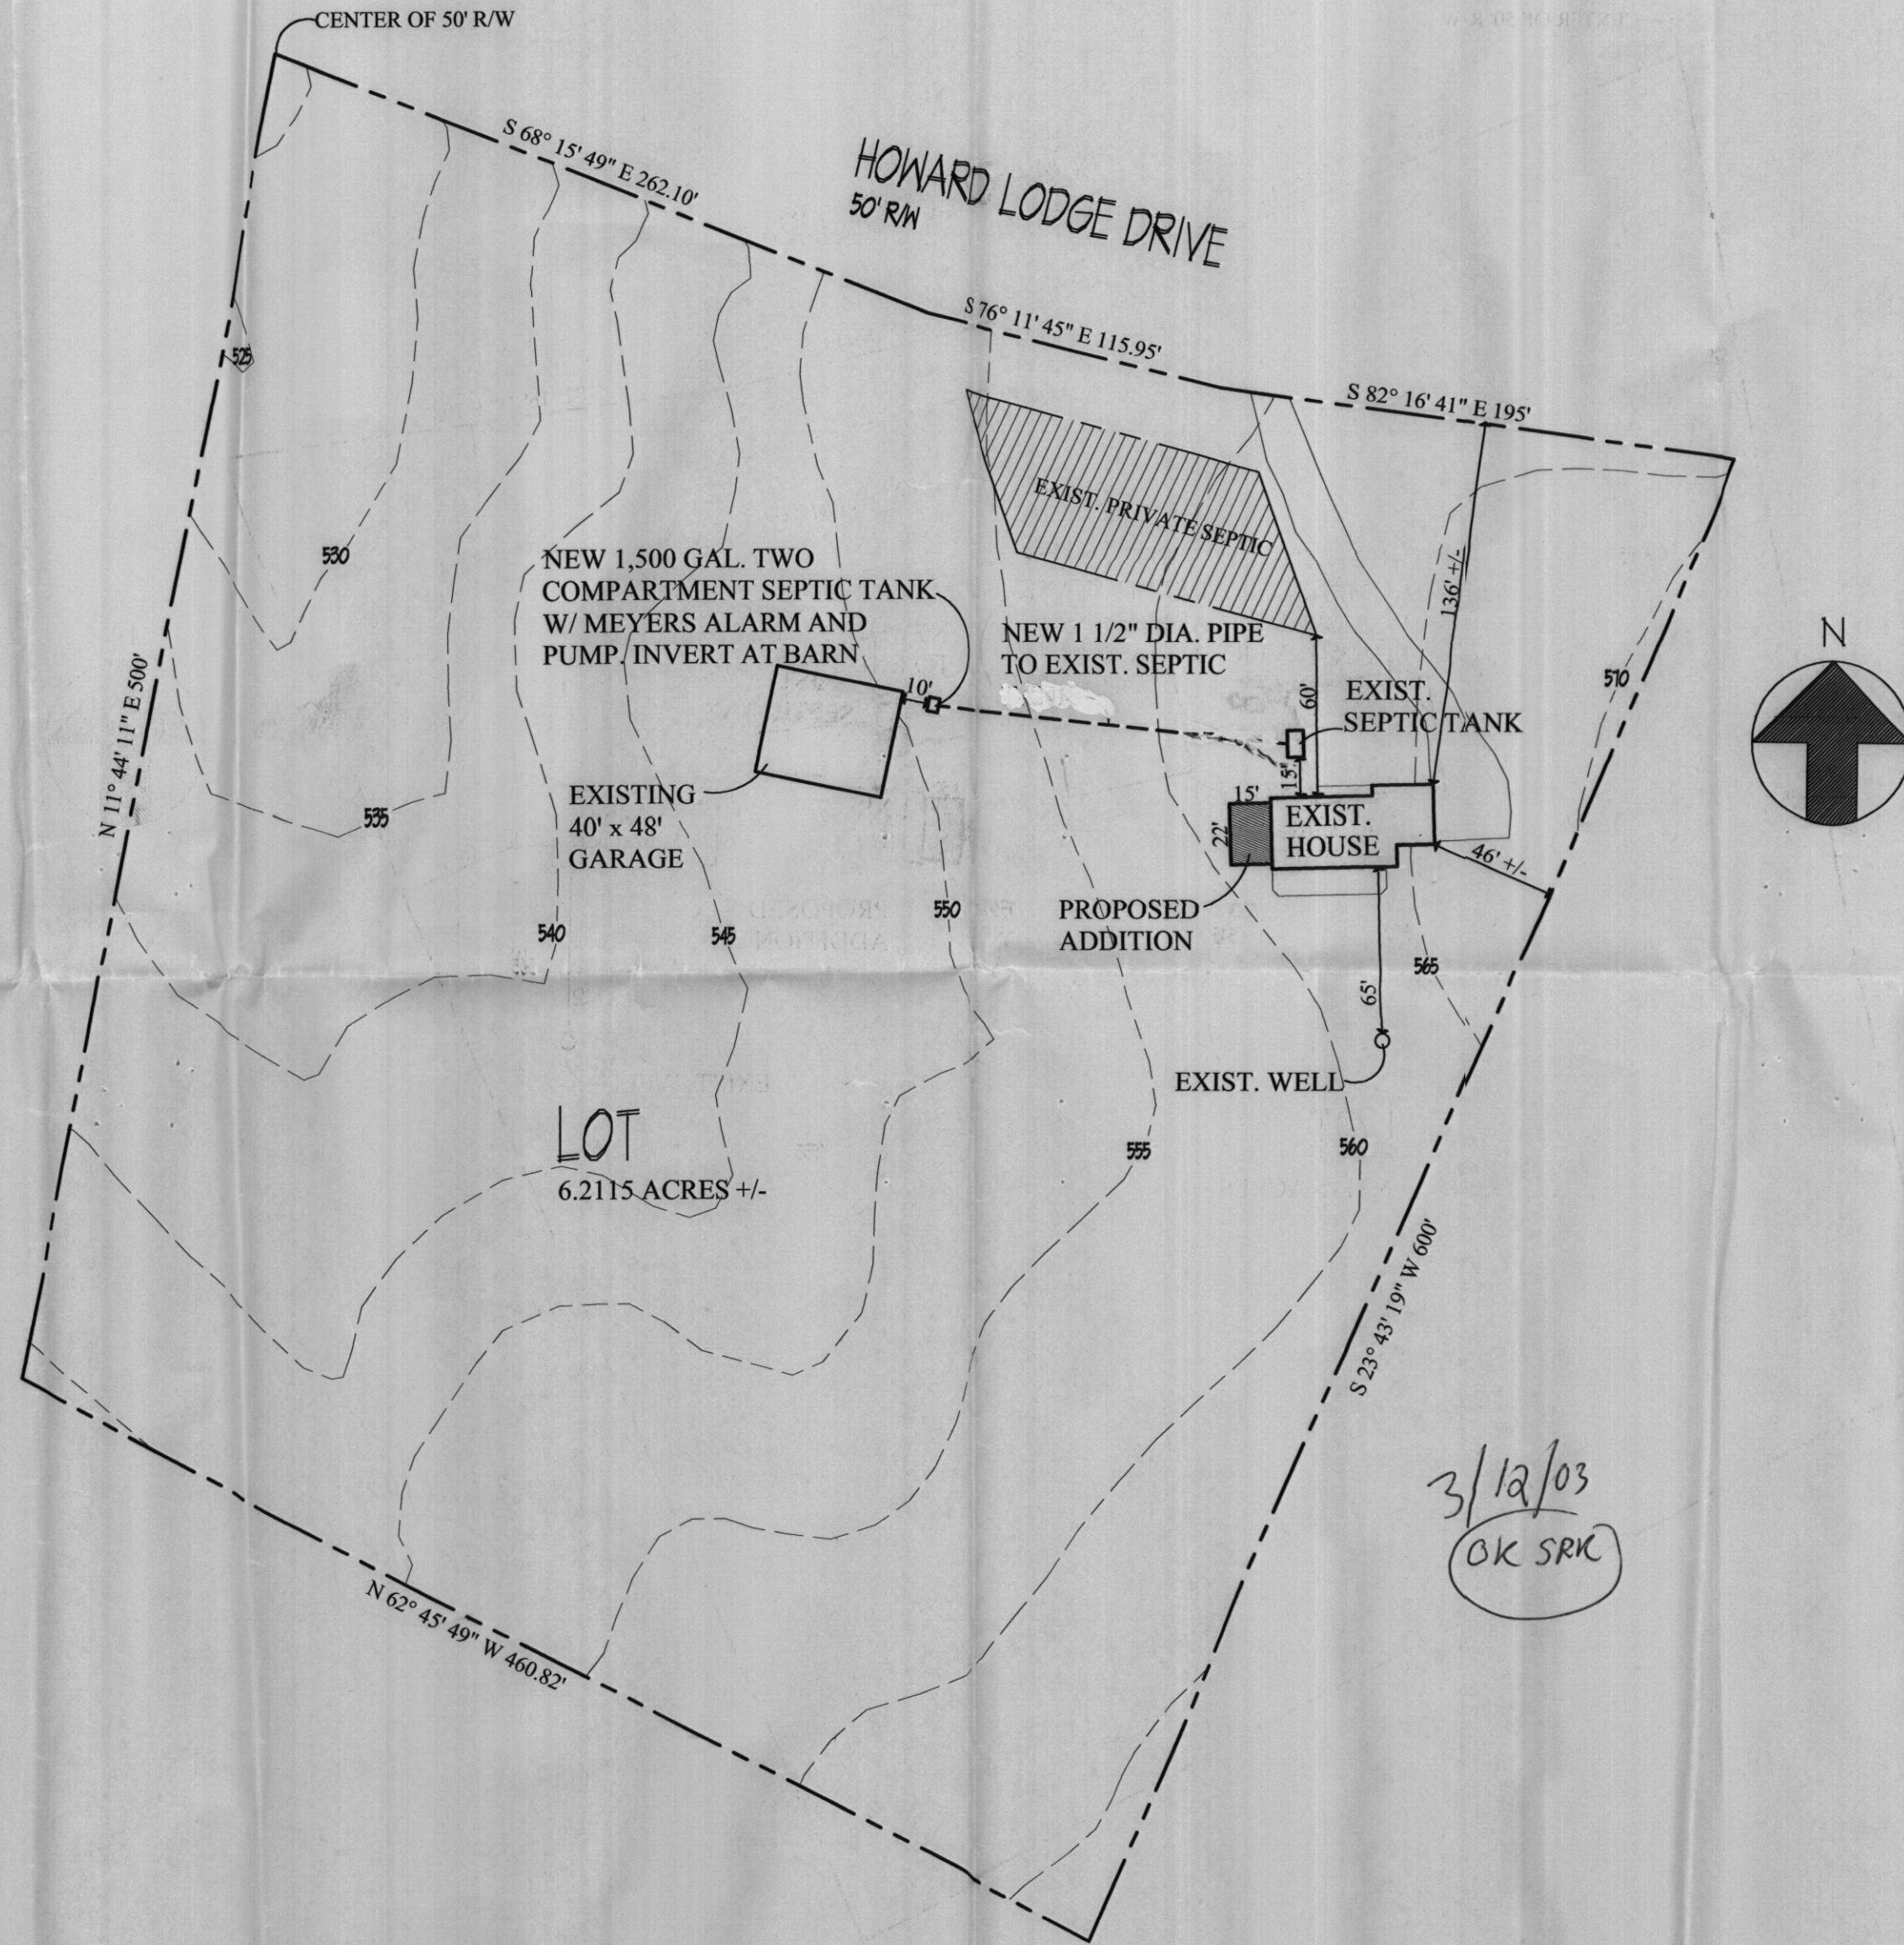

3/12/03  
OK SRK


12455 HOWARD LODGE DRIVE  
 HOWARD COUNTY, MARYLAND  
 3rd ELECTION DISTRICT  
 SCALE: 1"=60' DATE: MARCH 12, 2003

JONATHAN P. BUTTS  
 ARCHITECTURAL DESIGNER  
 8418 BELDALE COURT  
 BALTIMORE, MARYLAND 21286  
 (410) 662-9866

the  
**Griffmore**  
 group

CONTENTS	SITE PLAN		PR./T./ND.
SCALE: 1"=60'	DATE: MARCH 12, 2003	DRWN.	
PROJECT TITLE:	CURRY RESIDENCE		

SHEET NO.  
 S

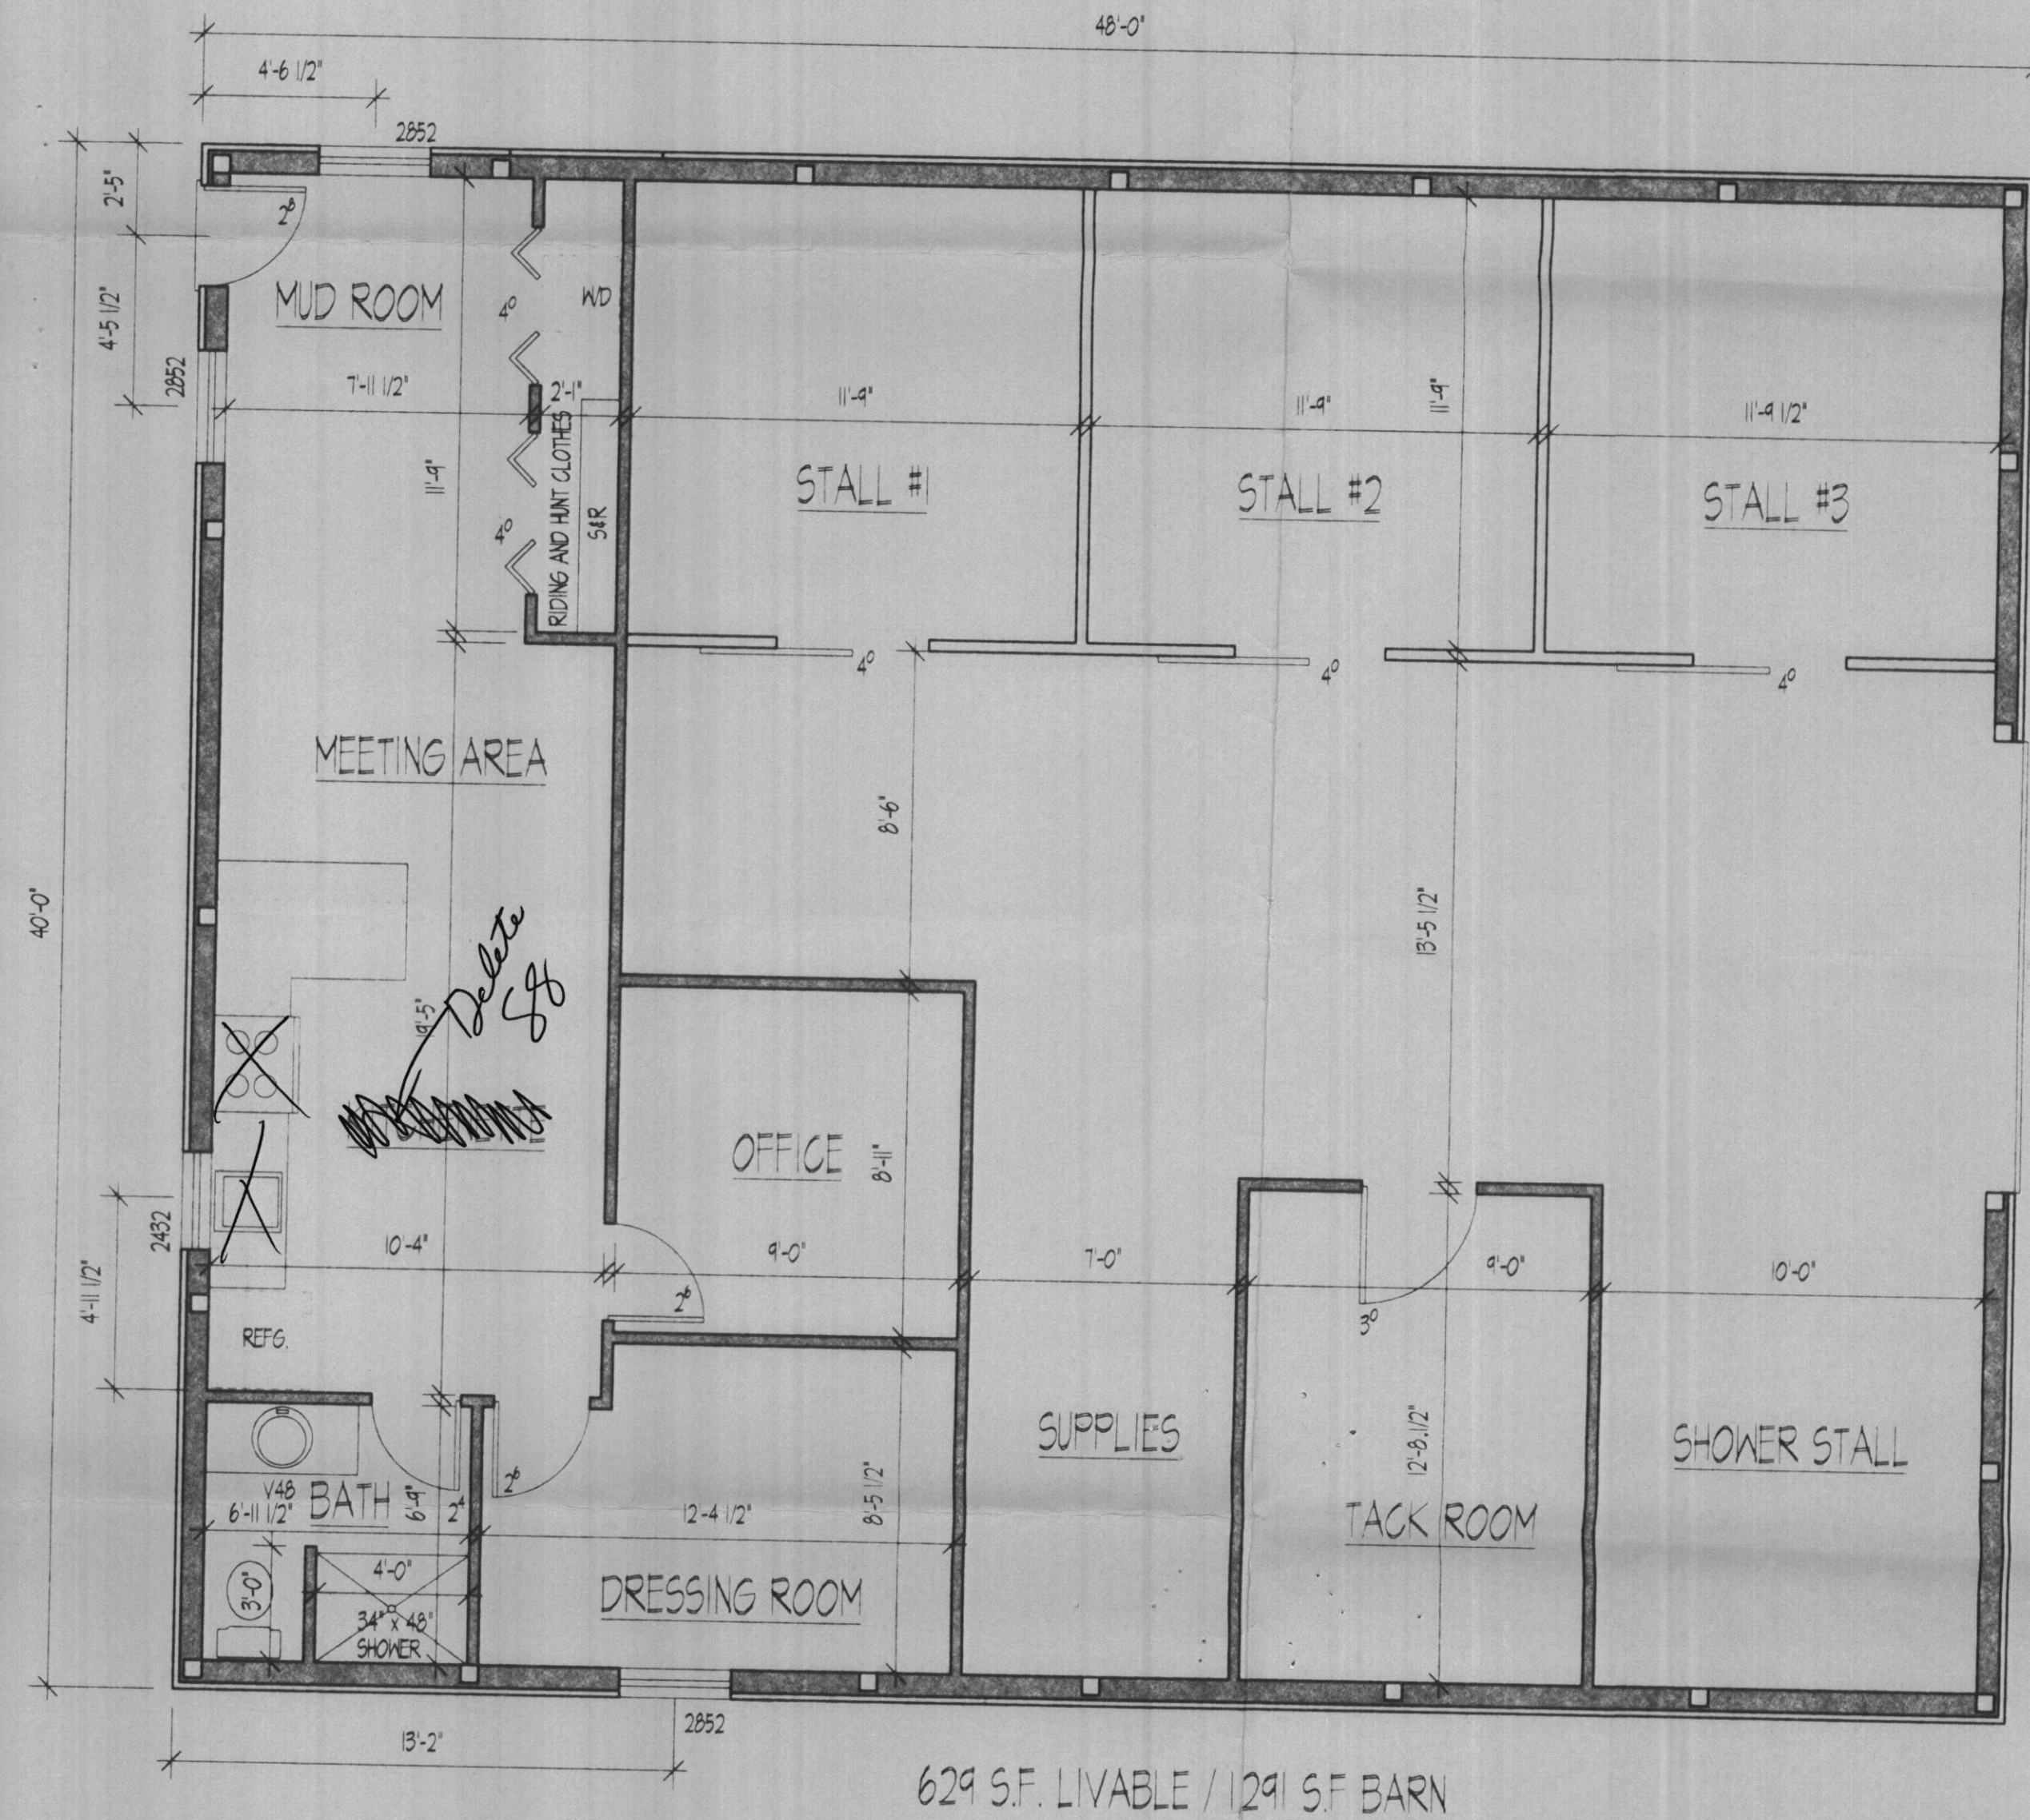

3/12/03-  
 propose L ok  
 SRIC

**NOTES:**

- COUPLE LEAVING LARGE HORSE FARM ARE DOWNSIZING
1. WIFE IS ALLERGIC TO HORSE HAIR SO ALL RIDING CLOTHING HORSE BLANKETS SADDLE PADS HAVE TO BE KEPT AWAY FROM HOUSE
  2. ALL RIDERS MUST SHOWER BEFORE COMING TO MAIN HOUSE
  3. HORSE MEDICATIONS AND SPECIAL PREPARATION OF ANIMAL AND HORSE DIET WILL USE REFRIGERATOR AND STOVE
  4. HUSBAND NEEDS A HOME OFFICE
  5. HUSBAND IS A GE ATTORNEY WHO WORKS FROM HOME TWO OR THREE DAYS PER WEEK
  6. BOTH ROOMS HAVE CABLE FOR COMPUTERS
  7. T-1 EXTERIOR FINISH WILL GIVE A RUSTIC COUNTRY LOOK.

**JONATHAN P. BUTTS**  
 ARCHITECTURAL DESIGNER  
 8418 BEDALE COURT  
 BALTIMORE, MARYLAND 21286  
 (410) 663-8866

the  
**Griffmore**  
 group

CONTENTS	BARN FLOOR PLAN	DATE: FEBRUARY 14, 2003	PROJECT
SCALE: 1/4" = 1'-0"		DRWN	CURRY RESIDENCE
PROJECT TITLE:			

ISSUE	NO.	DATE	DESCRIPTION

SHEET NO.  
**A-1**

**BARN FLOOR PLAN**  
 SCALE: 1/4" = 1'-0"