

7/30/76
a.m. please

PERMIT

P 23609
A 21630

SEWAGE DISPOSAL SYSTEM

MARYLAND STATE DEPARTMENT OF HEALTH

HOWARD COUNTY

ELLCOTT CITY

INDEXED

DISTRICT 5th

DATE 7/26/76

Roland Barth IS PERMITTED TO INSTALL ALTER

ADDRESS Clarksville Pike, Ellicott City, Md. PHONE 730-8495

A SEWAGE DISPOSAL SYSTEM LOCATED AT _____

SUBDIVISION Clarksville Meadows ⁷⁰²⁰ ROAD Route 32 LOT 7

PROPERTY OWNER ~~Na-Homes, Inc.~~ George R. Perry

ADDRESS 6730 Montgomery Road, Elkridge, Md. Phone: 796-1084

SPECIFICATIONS 3 bedrooms

DRAIN FIELD _____ DEPTH _____ FEET, BOTTOM AREA _____ SQ. FT.

SEEPAGE PITS _____ ABSORBENT SIDE-WALL AREA _____ SQ. FT.

SEPTIC TANK CAPACITY 1000 GALLONS

FOR GARBAGE GRINDER, INCREASE DISPOSAL AREA 22% & TANK CAPACITY 50%.

OTHER DRY WELL - To have 130 sq. ft. effective absorbent sidewall area per bedroom below inlet. Inlet to be 3 1/2 ft. below original grade and maximum depth permitted for dry well is 12 ft. Locate dry well as shown on plans submitted.

NOTE: ALL PIPE FROM HOUSE TO DISPOSAL AREA MUST BE CAST IRON.
PERMIT VOID AFTER THREE YEARS.

NOTE: INSTALL STAND PIPE ON SEPTIC TANK AND DRY WELL. STAND PIPES MUST BE 6 INCHES IN DIAMETER. CAST IRON, CONCRETE OR TERRA COTTA ACCEPTED.

PLANS APPROVED BY Charles B. Streaker DATE 2/10/76

FILL SEPTIC TANK AND DISTRIBUTION BOX WITH WATER BEFORE CALLING FOR AN INSPECTION. COVER NO WORK UNTIL INSPECTED AND APPROVED.


NEITHER THE HOWARD COUNTY COMMISSIONERS NOR THE HEALTH DEPARTMENT IS RESPONSIBLE FOR THE SUCCESSFUL OPERATION OF ANY SYSTEM.

BLDG. PERMIT SIGNED
AND RETURNED 10/13/79
Serial # 47494

BLDG. PERMIT SIGNED
AND RETURNED 10/13/79
Pool Permit
Serial No. 4/381

A 21630

A 21630

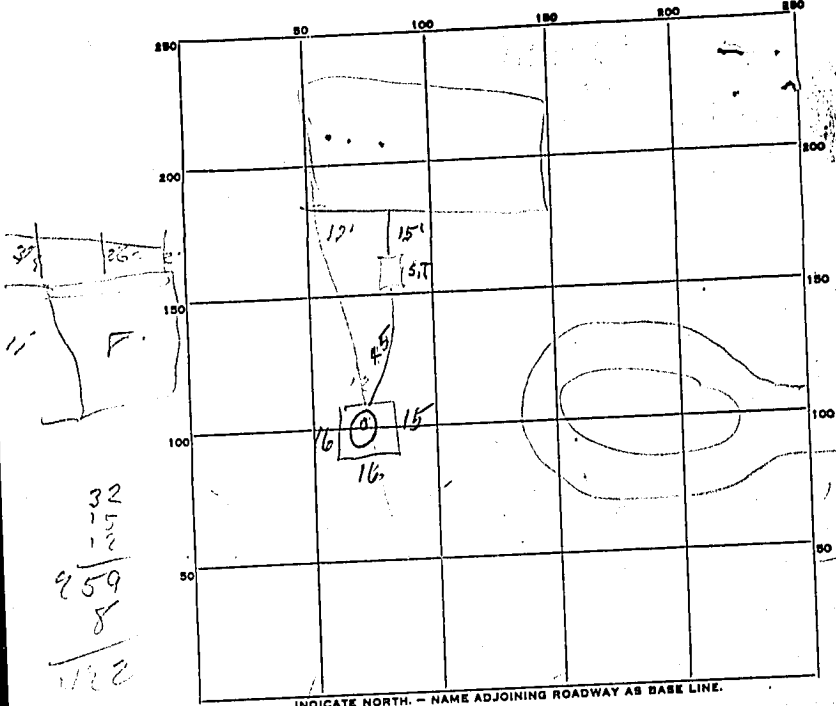

$$\begin{array}{r} 32 \\ 15 \\ \hline 959 \\ 8 \\ \hline 112 \end{array}$$

$$\begin{array}{r} 130 \\ 360 \\ \hline 390 \end{array}$$

PERMIT CARD Final
 SEPTIC TANK, LEVEL CLEANOUTS
 DISTRIBUTION BOX, LEVEL _____
 TILE FIELD, DEPTH _____ FT. TRENCH WIDTH _____ FT.
 GRAVEL DEPTH _____ IN. TOTAL LENGTH _____ FT.
 NUMBER OF TRENCHES _____ TOTAL BOTTOM AREA _____
 SEEPAGE PITS, INSIDE DIAMETER 39' FT. DEPTH BELOW INLET 8 FT.
 ABSORBENT AREA 422 SQ. FT. (need 390) OK.

REMARKS _____

DATE SYSTEM APPROVED 7/30/46 INSPECTOR M. J. [Signature]