

05203

DEPARTMENT OF WATER RESOURCES
STATE OFFICE BLDG., ANNAPOLIS, MARYLAND 21403

WELL COMPLETION REPORT

DATE WELL COMPLETED: FEB 25 1990

DEPTH OF WELL: TR (TO NEAREST FOOT)

COUNTY: WICOMICO

PERMIT NO. FROM "PERMIT TO DRILL WELL": 16-16-01-16

DRILLERS IDENTIFICATION NO.: 1163

OWNER: MIT Well (LAST NAME)

POST OFFICE: EMMOTT CITY MD

WELL LOG

STATE THE KIND OF FORMATIONS PENETRATED, THEIR COLOR, DEPTH, THICKNESS AND IF WATER BEARING

DESCRIPTION	FROM	TO	DEPTH OF WATER BEARING
Top soil	0	3	
Shelly rock	3	10	
Brandy rock	10	22	

Drilled 109 ft
Hole 20 ft
Grouted 2 ft
5 Bags cement

ROUTINE RECORD

WELL LOG CASE NO. 1163

TYPE OF WELL: C/S (CONCRETE) SC (STEEL CASE)

NO. OF SPACES: 5 NO. OF HOLES: 400

FALLING HEAD: 15

DEPTH OF GROUT SEAL TO NEAREST FOOT: 0 TO 20

CASING RECORD

INSERT APPROXIMATE CODE BELOW

STEEL: ST CONCRETE: CO

PLASTIC: PL OTHER: OT

MAIN CASING TYPE: ST

NOMINAL DIAMETER TOP BRASS CASING (NEAREST INCH): 0

TOTAL DEPTH OF MAIN CASING (NEAREST FOOT): 22

OTHER CASING (IF USED)

DIAMETER (INCH):

DEPTH (FEET) FROM TO

SCREEN RECORD

INSERT APPROXIMATE CODE BELOW

STEEL: ST BRASS OR BRONZE: BR OPEN MESH: HO

PLASTIC: PL OTHER: OT

SCREEN TYPE ON WELL: C 2

DEPTH (NEAREST WHOLE FOOT)

FROM TO

1 1 11 15 17 21

2 22 24 28 30 32 36

3 38 39 41 46 47 51

SLOT SIZE 1. 2. 3.

DIAMETER OF SCREEN (NEAREST INCH) FROM TO

GRAVEL PACK

IF WELL DRILLED WAS A FLOWING WELL CIRCLE BOX: P

OWNER USE ONLY (NOT TO BE FILLED IN BY DRILLER)

TELESCOPE CASING: T TO 70

LOG INDICATOR: 72

OWNER DATA AVAILABLE: 76 TO 70

PUMPING TEST

WELL NUMBER (TO NEAREST HOLE): 1

PUMPING RATE (GALLONS PER MINUTE TO NEAREST GALLON): 5

WATER LEVEL - DISTANCE FROM LAND SURFACE (FEET): 17 TO 20

DEPTH: 75 FEET

TYPE OF PUMP USED (CIRCLE APPROPRIATE ONE) (FROM PUMPING TEST)

A AIR 27 P PISTON 27 T TURBINE 27

C CENTRIFUGAL 27 R ROTARY 27 O OTHER (SEE CODE) 27

J JET 27 B BUSHINGHOLE 27

PUMP INSTALLED

TYPE OF PUMP (WRITE APPROPRIATE LETTER IN BOX - SEE ABOVE: A, C, J, P, R, S, T, U)

DRILLER WILL INSTALL PUMP (CIRCLE APPROPRIATE ONE): Y


CAPACITY: GALLONS PER MINUTE (TO NEAREST GALLON): 31

PUMP COLUMN LENGTH (NEAREST FOOT): 62 TO 67

CASING HEIGHT (CIRCLE APPROPRIATE ONE AND ENTER CASING HEIGHT)

ABOVE LAND SURFACE: 2 FEET

BELOW: 0 TO 51 FEET

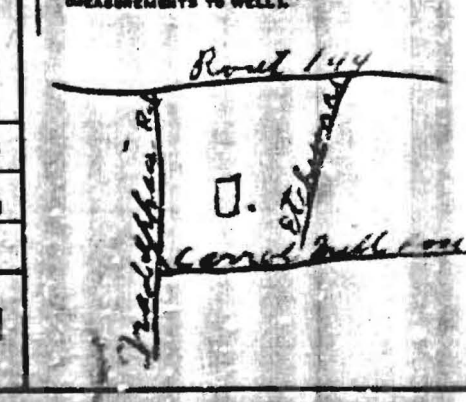

CIRCLE APPROPRIATE BOXES

A WELL WAS ABANDONED AND SEALED WHEN THIS WELL WAS COMPLETED

E ELECTRIC LOG OBTAINED

P TEST WELL CONVERTED TO PRODUCTION WELL

I HEREBY CERTIFY THAT I HAVE COMPLIED WITH ALL CONDITIONS STATED ON THE ABOVE-CAPTIONED "PERMIT TO DRILL WELL", AND THAT INFORMATION CONTAINED IN THIS REPORT IS TRUE, ACCURATE, AND COMPLETE TO THE BEST OF MY KNOWLEDGE, INFORMATION AND BELIEF.

DRILLERS NAME: Dewey Brown

(PLEASE PRINT) Dewey Brown

SIGNATURE: Dewey Brown