

4/23/76
7/27/76

PERMIT

SEWAGE DISPOSAL SYSTEM

MARYLAND STATE DEPARTMENT OF HEALTH

HOWARD COUNTY

ELLICOTT CITY

DISTRICT 2

DATE 1/23/76

INDEXED

File
P 2342
A 21579

 IS PERMITTED TO INSTALL ALTER

ADDRESS 1724 New Hampshire Ave., Ashton, Maryland PHONE (8) 774-4534

A SEWAGE DISPOSAL SYSTEM LOCATED AT

SUBDIVISION (New Sub) ROAD E. Side of St. 108 LOT 1

(see application for better directions)

PROPERTY OWNER Ray Henry

ADDRESS

SPECIFICATIONS - 4 bedrooms

DRAIN FIELD DEPTH FEET, BOTTOM AREA SQ. FT.

SEWAGE PITS ABSORBENT SIDEWALL AREA SQ. FT.

SEPTIC TANK CAPACITY 1,200 GALLONS

FOR GARbage GRINDER, INCREASE DISPOSAL AREA 25% & TANK CAPACITY 50%.

OTHER Dry well to have 120 sq. ft. effective sidewall absorption area per bedroom.

to begin below the first 4 ft. of new paper soil. Max. depth permitted for dry well is

11 1/2 ft. below original grade. Locate dry well 120 ft. from the front lot line and 120 ft.

from the right side line, as seen when facing the property from the right 1/2 of way.

PERMIT VOID AFTER THREE YEARS.

NOTE: ALL PIPE FROM HOUSE TO DISPOSAL AREA MUST BE CAST IRON.

NOTE: INSTALL STAND PIPE ON SEPTIC TANK AND DRY WELL. STAND PIPE MUST BE 6" IN DIA.,

PLANS APPROVED BY FRED SKINNER DATE 1/23/76


CAST IRON, CONCRETE OR TERRA COTTA ACCEPTED.

FILL SEPTIC TANK AND DISTRIBUTION BOX WITH WATER BEFORE CALLING FOR AN INSPECTION. COVER NO WORK UNTIL INSPECTED AND APPROVED.

NEITHER THE HOWARD COUNTY COMMISSIONERS NOR THE HEALTH DEPARTMENT IS RESPONSIBLE FOR THE SUCCESSFUL OPERATION OF ANY SYSTEM.

A 21579

A 21579

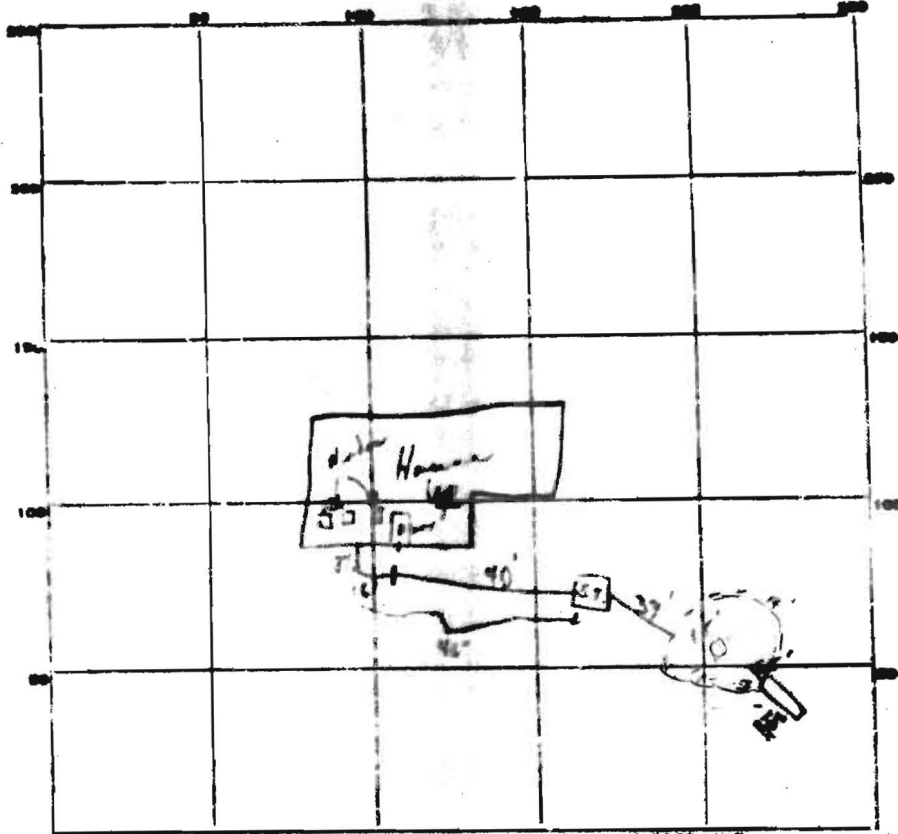

INDICATE NORTH - NAME ADJOINING ROADWAY AS BASE LINE.

PERMIT CARD Yes 7/23/76 7/27/76 7/27/76

SEPTIC TANK LEVEL OK CLEANOUTS Not None

DISTRIBUTION BOX LEVEL _____

Trench
TRENCH DEPTH _____ FT. TRENCH WIDTH _____ FT.

GRAVEL DEPTH _____ IN. TOTAL LENGTH _____ FT.

NUMBER OF TRENCHES _____ TOTAL BOTTOM AREA _____

SEEPAGE PITS, NUMBER DIAMETER outside perimeter 63 FT. DEPTH BELOW INLET 4 1/2 FT.

ABSORBENT AREA _____ SQ. FT.

REMARKS 7/23/76 OK Center on all the way

Permit card says "top of septic tank"

below grade; 20' well about 70' off.

7/26/76 To add 70 sq ft. to dry well - also "man hole" to septic tank. W

7/27/76 5' earth buffer; 15' of trench gravel already in

DATE SYSTEM APPROVED 7/27/76 INSPECTOR C. R. Stuck

Peraloue