

8/5/03 - 2pm

PUB. SEWER STATUS VERIFIED BY NA

ISSUE DATE: 3/28/2003

P 518594

APPROVAL DATE: 8/5/03

PERMIT

A REPAIR

INDEXED

ON-SITE SEWAGE DISPOSAL SYSTEM HOWARD COUNTY HEALTH DEPARTMENT BUREAU OF ENVIRONMENTAL HEALTH

04-339738

Touse Remodeling Corp IS PERMITTED TO INSTALL ALTER

ADDRESS: 9329 Cornshock Ct - 21045 PHONE NUMBER: 410-290-9062

SUBDIVISION: Lisbon Manor LOT NUMBER: 5

ADDRESS: 16262 Compromise Court PROPERTY OWNER: Bill & Susan Hughs

SEPTIC TANK CAPACITY (GALLONS): _____

PUMP CHAMBER CAPACITY (GALLONS): _____

NUMBER OF BEDROOMS: _____

SQUARE FEET PER BEDROOM: _____

LINEAR FEET OF TRENCH REQUIRED: _____

TRENCHES:	Trench to be _____ feet wide. Inlet _____ feet below original grade. Bottom maximum depth _____ feet below original grade. Effective area begins at _____ feet below original grade. _____ feet of stone below distribution pipe.
LOCATION:	
PURPOSE:	In support of building permit # B00140903. Need to add another trench.

PLANS APPROVED: Brian Baker DATE: 3/27/03

- NOTE: PERMIT VOID AFTER 2 YEARS
- NOTE: CONTRACTOR RESPONSIBLE FOR SCHEDULING A PRE-CONSTRUCTION INSPECTION FOR ALL INSTALLATIONS
- NOTE: WATERTIGHT SEPTIC TANKS REQUIRED
- NOTE: ALL PARTS OF SEPTIC SYSTEM SHALL BE 100 FEET FROM ANY WATER WELL
- NOTE: MANHOLE RISERS REQUIRED ON ALL SEPTIC TANKS AND PUMP CHAMBERS

NEITHER THE HOWARD COUNTY COUNCIL NOR THE HEALTH DEPARTMENT IS

RESPONSIBLE FOR THE SUCCESSFUL OPERATION OF ANY SYSTEM

PERMITTEE RESPONSIBLE FOR OBTAINING FINAL APPROVAL ON THIS PERMIT

CALL 410-313-2640 FOR INSPECTION OF SEPTIC SYSTEM

BUILDING PERMIT SIGNED AND RETURNED

3-27-03 B00140903-MEDIAN ADDITION
8-06-03 B00143129-UG PUMP AND TANK

P518594

NOT TO SCALE

INDEXED

See old diagram

ROAD

TRENCH/DRAINFIELD DATA

WIDTH	INLET	BOTTOM
_____	_____	_____
NUMBER OF TRENCHES _____		
TOTAL LENGTH _____		
ABSORPTION AREA _____		
DISTRIBUTION BOX LEVEL _____		
DISTRIBUTION BOX BAFFLE _____		
DISTRIBUTION BOX PORT _____		

SEPTIC TANK DATA

SEPTIC TANK 1 LEVEL _____	
CAPACITY _____	GAL
SEAM LOC _____	
TANK LID DEPTH _____	
BAFFLES _____	
BAFFLE FILTER _____	
MANHOLE LOC _____	
6" PORT LOC _____	
WATERTIGHT TEST _____	
SEPTIC TANK 2 LEVEL _____	
CAPACITY _____	GAL
SEAM LOC _____	
TANK LID DEPTH _____	
BAFFLES _____	
BAFFLE FILTER _____	
MANHOLE LOC _____	
6" PORT LOC _____	
WATERTIGHT TEST _____	

PRE-CONSTRUCTION _____

INSTALLATION 8/5/03 - (1) 80' trench added off of D.B. of current system. OK to cover (S)

BUILDING PERMIT SIGNED
AND RETURNED

FINAL INSPECTOR


[Signature]

DATE OF APPROVAL

8/5/03

To: Tom
From: Rob to use

Hughes Job

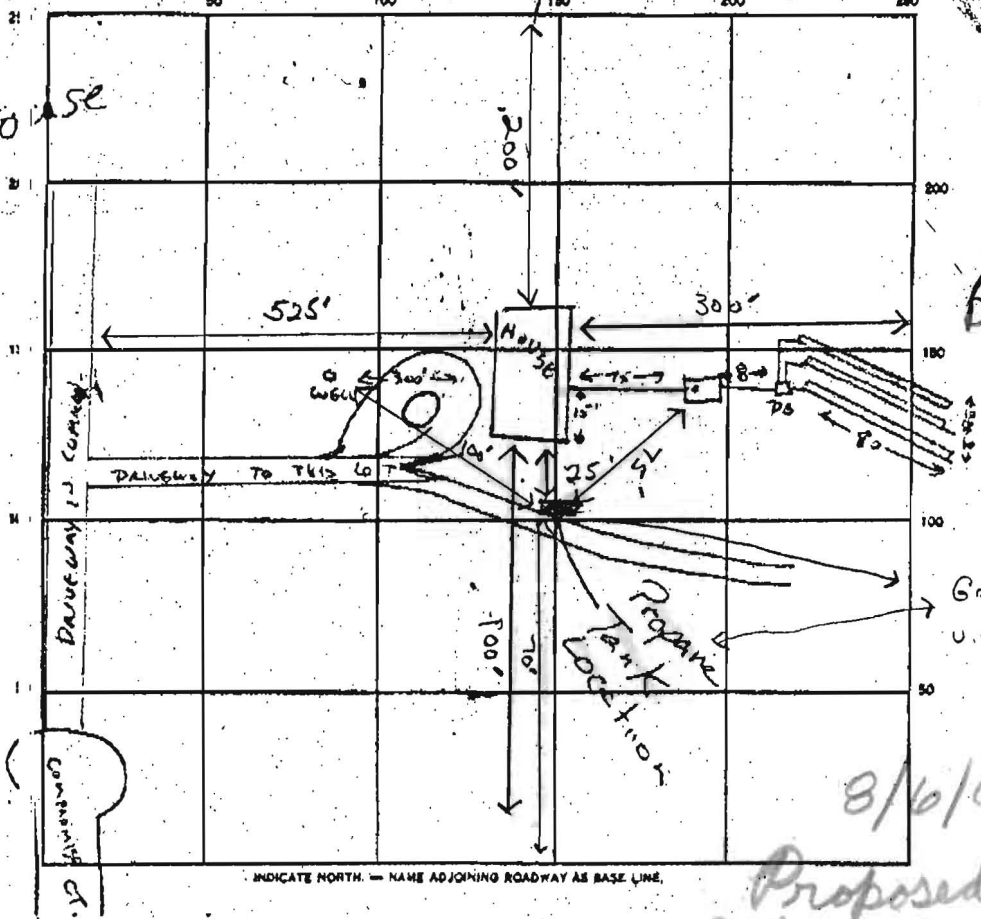

600143127

INSTALL (1) 1000 GALLON ASME U.G. LP TANK

8/16/03

Proposed Propane Tank Location O.K.

SEPTIC TANK LEVEL

CLEANOUTS

DISTRIBUTION BOX LEVEL

DRAIN FIELD/TILE FIELD DEPTH 4 1/2 FT. TRENCH WIDTH 3 FT. INLET DEPTH 3 FT.

EFFECTIVE GRAVEL DEPTH 1 1/2 FT. TOTAL LENGTH 240 FT.

NUMBER OF TRENCHES 3/80 each ONE SIDEWALL/BOTTOM AREA 720 SQ. FT.

DRYWELL INSIDE DIAMETER FT. EFFECTIVE DEPTH BELOW INLET FT.

ABSORBENT AREA 720 SQ. FT.

REMARKS

1" = 200'

DATE SYSTEM APPROVE 12/22/06

INSPECTOR C. William