

# APPLICATION

A 24409

SEWAGE DISPOSAL TESTING

P \_\_\_\_\_

STATE OF MARYLAND - DEPARTMENT OF HEALTH AND MENTAL HYGIENE

HOWARD COUNTY HEALTH DEPARTMENT  
ENVIRONMENTAL HEALTH SERVICES

DISTRICT 4th

P. O. BOX 476, ELLICOTT CITY, MARYLAND 21043  
TELEPHONE: 465-5000, EXT. 356

DATE 10/29/76

TO: THE COUNTY HEALTH OFFICER  
ELLICOTT CITY, MARYLAND

I, HEREBY, APPLY FOR THE NECESSARY TEST IN ORDER TO CONSTRUCT (OR RECONSTRUCT) A SEWAGE DISPOSAL SYSTEM.

PROPERTY OWNER Simco Corporation

ADDRESS 1001 W. Nolcrest Drive, Sil. Spg. Md. PHONE 593-7858

PROPERTY LOCATION:

SUBDIVISION Lisbon Mansions LOT NO. 28 new 5  
~~Paterson View Estates~~

ROAD AND DESCRIPTION North side of Old Frederick, 1/4 mile west of Rte. 94

SIZE OF LOT 2.1 acres TYPE BLDG. 3  
NUMBER OF BEDROOMS

IF NOT SINGLE RESIDENCE DESCRIBE \_\_\_\_\_

THE SYSTEM INSTALLED UNDER THIS APPLICATION IS ACCEPTABLE ONLY UNTIL PUBLIC FACILITIES BECOME AVAILABLE.

SIGNATURE OF APPLICANT [Signature] President


APPROVED BY \_\_\_\_\_ FOR \_\_\_\_\_ DATE \_\_\_\_\_  
(KIND OF SYSTEM)

REJECTED BY \_\_\_\_\_ FOR \_\_\_\_\_ DATE \_\_\_\_\_  
(KIND OF SYSTEM)

HOLD PENDING FURTHER TESTS \_\_\_\_\_ DATE \_\_\_\_\_

REASONS FOR REJECTION OR HOLDING \_\_\_\_\_

# THIS IS NOT A PERMIT

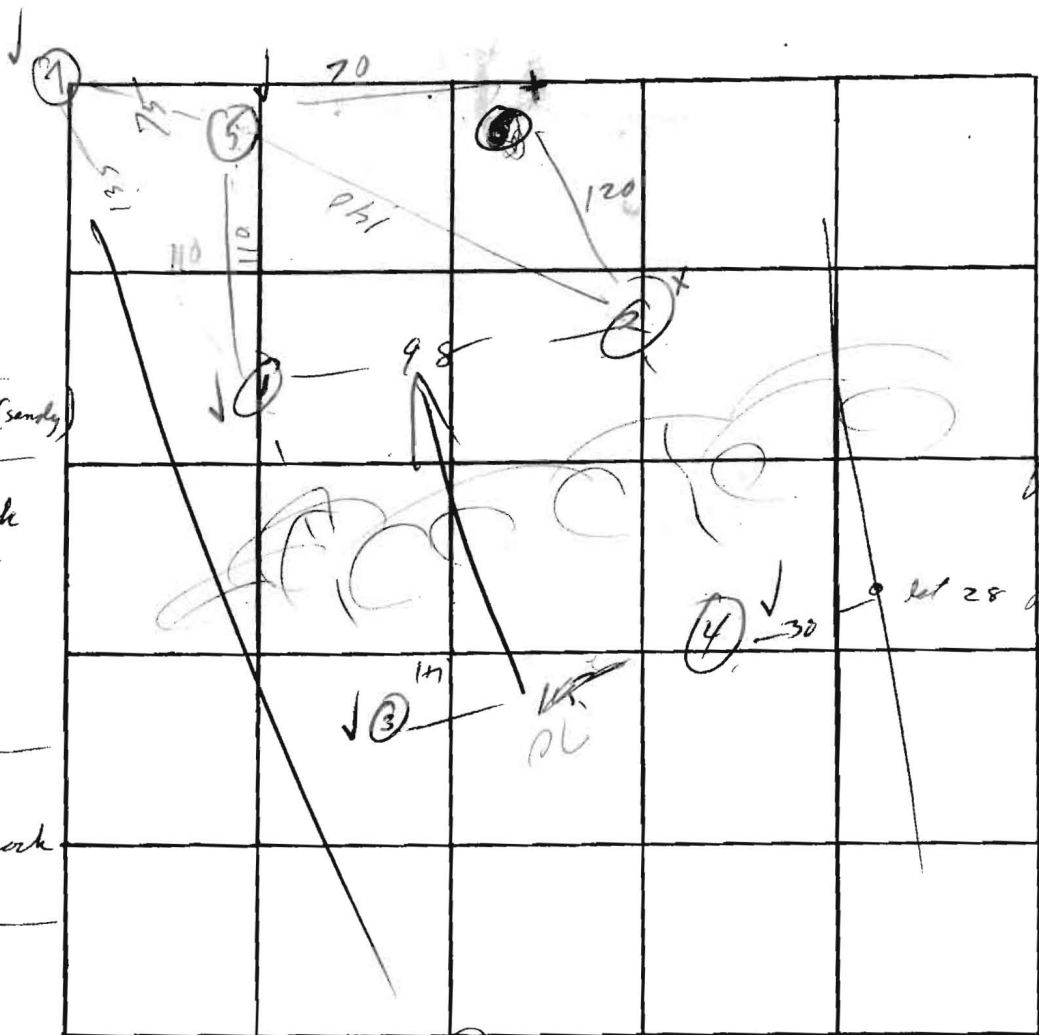

Jul 28

Jul 28 Pol.

①  
0 clay-loam (sandy)  
5 1/2  
loam rock  
1 1/2 rock

②  
0  
sandy clay loam  
rock  
10

③  
0  
loam  
2 1/2  
rock  
9

④ sandy  
11 clay loam

INDICATE NORTH. - NAME ADJOINING ROADWAY AS BASE LINE.

DATE	TEST NO.	DEPTH	PRE-WET		TEST - 1" DROP		TIME	
			START	STOP	START	STOP		
7/6/78	2	11 1/2	11 34	11 41	11 41	11 52	18	X
	2A	2 1/2	11 34	11 40	11 40	11 42	7	X
7/5	1	11 1/2	vis					✓
	5	2 1/2	11 42	11 52	11 52	12 00	8	✓
	5A	12	11 42	11 55	11 55	11 12	17	X
	6	~5						X
	7 7A	4 13	12 35	12 41 12 45	12 41 12 45	12 52 1 10	11 24	✓
	3 3A	3 12					6 21	✓
	4 4A	3 12 1/2					3 9	✓

160 ypp.  
per bedroom  
13 min  
avg

REMARKS \_\_\_\_\_  
 TYPE OF SOIL \_\_\_\_\_  
 TESTED BY M ALSO PRESENT: \_\_\_\_\_